



PLATE 3-FULL CROSS SECTION PILE LINE
ASWALDEN TYPICAL SHEET
REVISED 12/1/07

ORIGINAL	SURVEYED	BY	DATE
SURVEY	PLOTTED		
NOTE BOOK	AREA		
NO.	AREA CHECKED		

FINAL	SURVEYED	BY	DATE
SURVEY	PLOTTED		
NOTE BOOK	AREA		
NO.	AREA CHECKED		

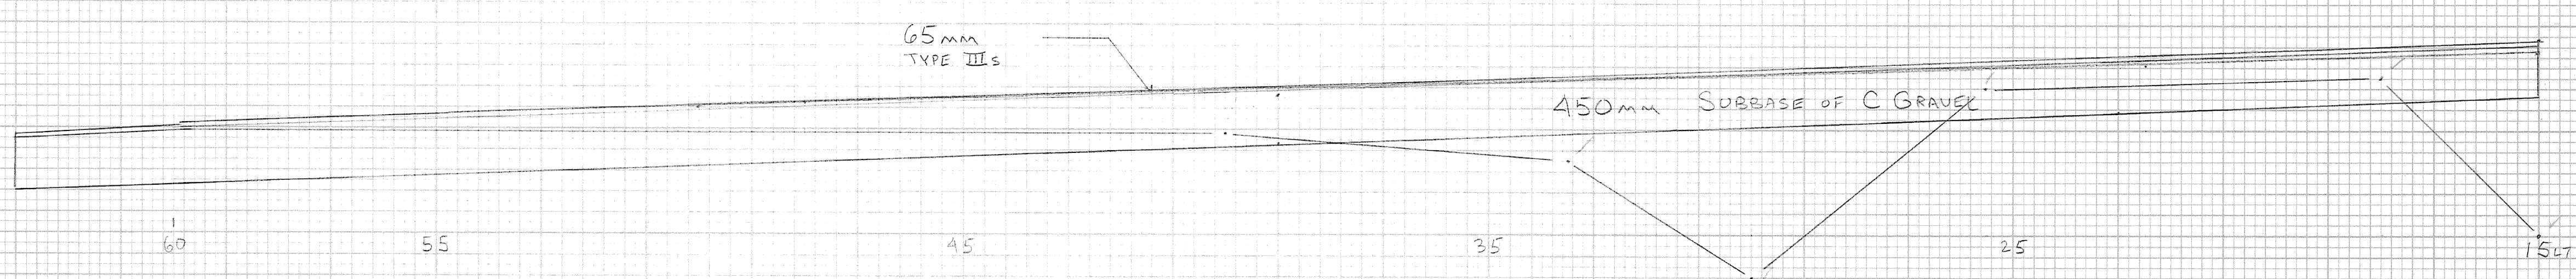

12+280 (Butt)

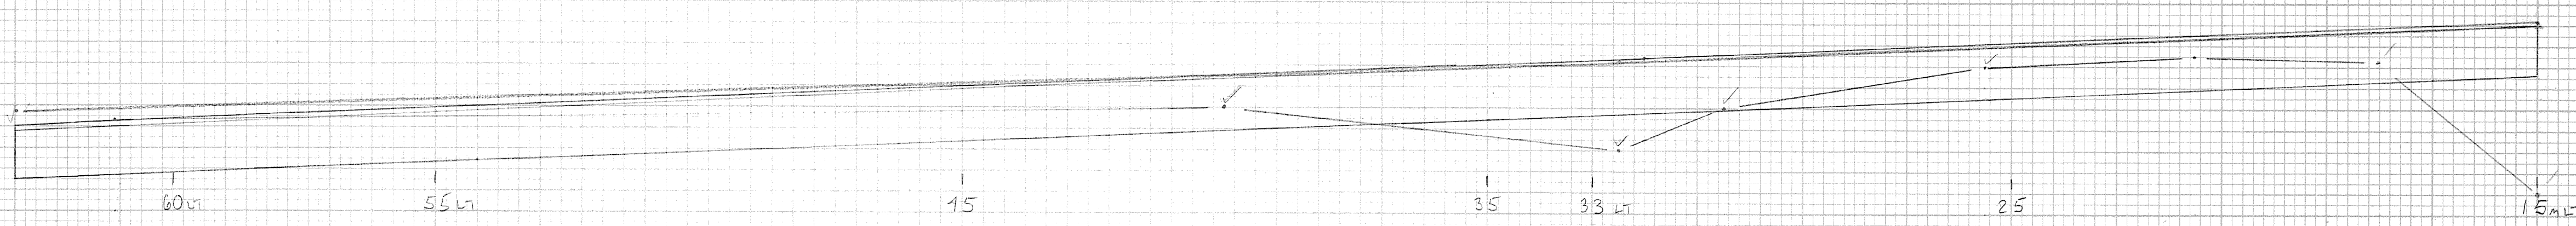

12+260

SCALE H 1:80
V 1:40

ALBURG-SWANTON RRF 036-1 (1)
BOAT ACCESS CROSS SECTIONS

SHEET 2 OF 2

7-21-07

11/6-14-07