


DRAINAGE NOTE 40: (DRAINAGE BOOK 2A p. 52)

POINT #	ALONG STATION	X	Y	STATION	FINISH GRADE E	OFFSET	FINISH GRADE
1	4.86	1.21	40.074	0+074.2	40.435	4.50 LT	40.621
2	3.42	0.88	40.073	0+073.9	40.422	3.30 LT	40.620
3	3.42	0.88	40.072	0+072.1	40.345	3.30 RT	40.147
4	4.66	1.21	40.071	0+071.9	40.336	4.50 RT	40.066
5	8	8	40.073	0+073.0	40.353	8	40.383
6	12.42	3.22	40.069	0+069.5	40.246	12.0 RT	38.101
7	9.84	2.55	40.075	0+075.6	40.495	9.5 LT	39.451

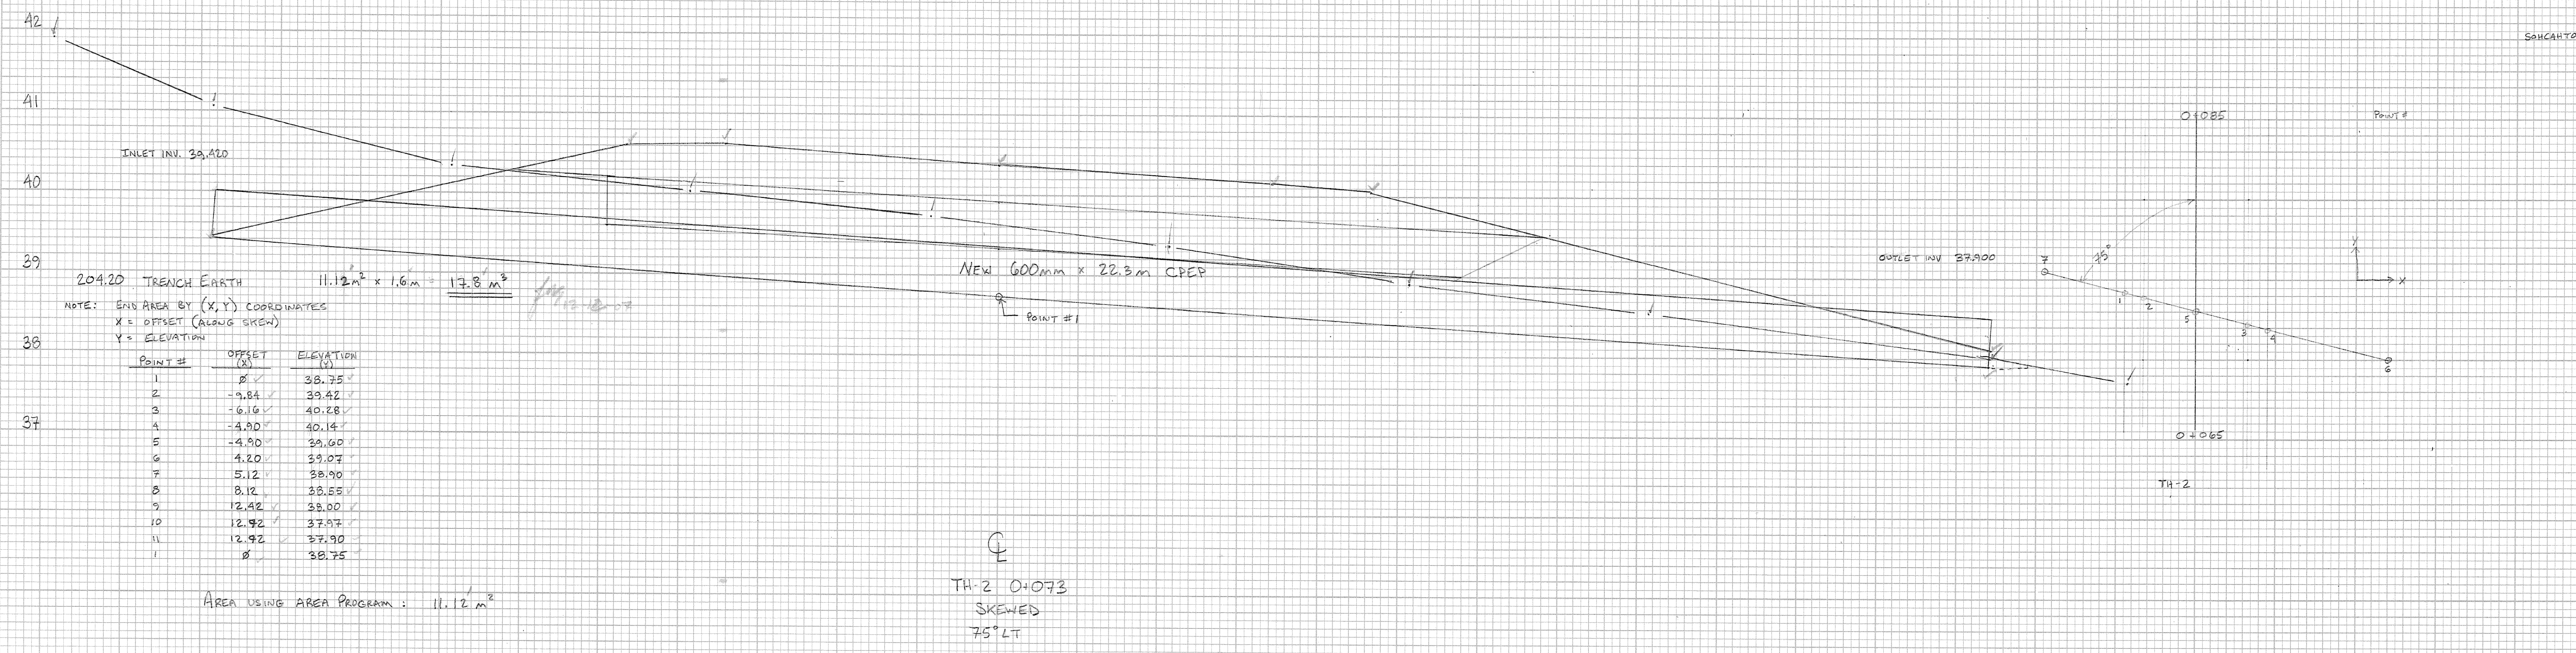


DRAINAGE NOTE 11: (DRAINAGE BOOK 2 p. 52)

20A.20 TRENCH EARTH 21.23 m<sup>2</sup> x 1.45 m = 30.8 m<sup>3</sup> STW 63-06

NOTE: END AREA BY (X,Y) COORDINATES  
X = OFFSET  
Y = ELEVATION

POINT #	OFFSET (X)	ELEVATION (Y)
1	-11.0	35.50
2	-11.0	35.95
3	-13.1	36.58
4	-20.0	37.20
5	-25.2	37.20
6	-27.2	36.35
7	-27.2	35.93
8	-27.5	35.38
9	-27.5	35.30
1	-11.0	35.50

AREA USING AREA PROGRAM: 21.23 m<sup>2</sup>

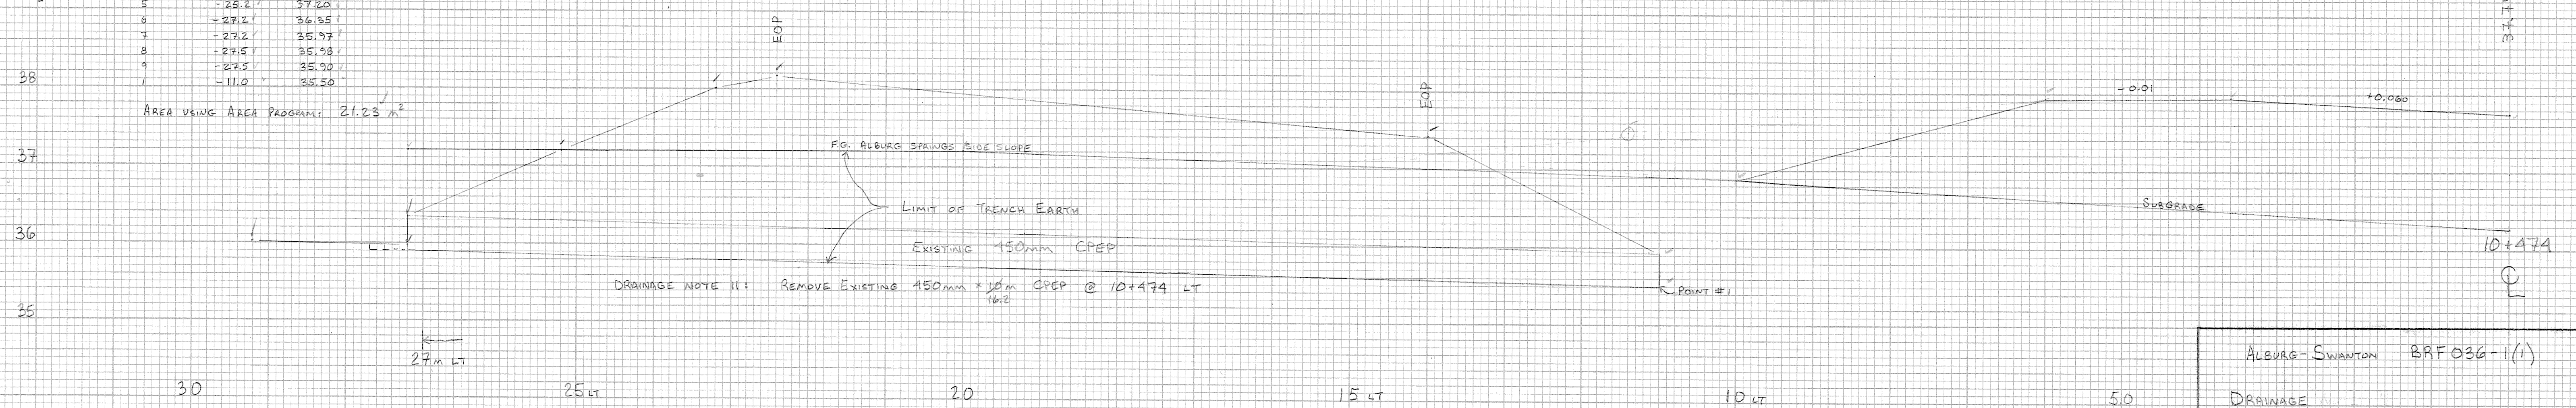

ALBURG-SWANTON BRFO36-1(1)

DRAINAGE

DRAWN BY S. WHEATLEY 6-3-06  
CHECKED BY  
SCALE 1:40 (H&V)

SHEET 3 OF 10