




METRIC

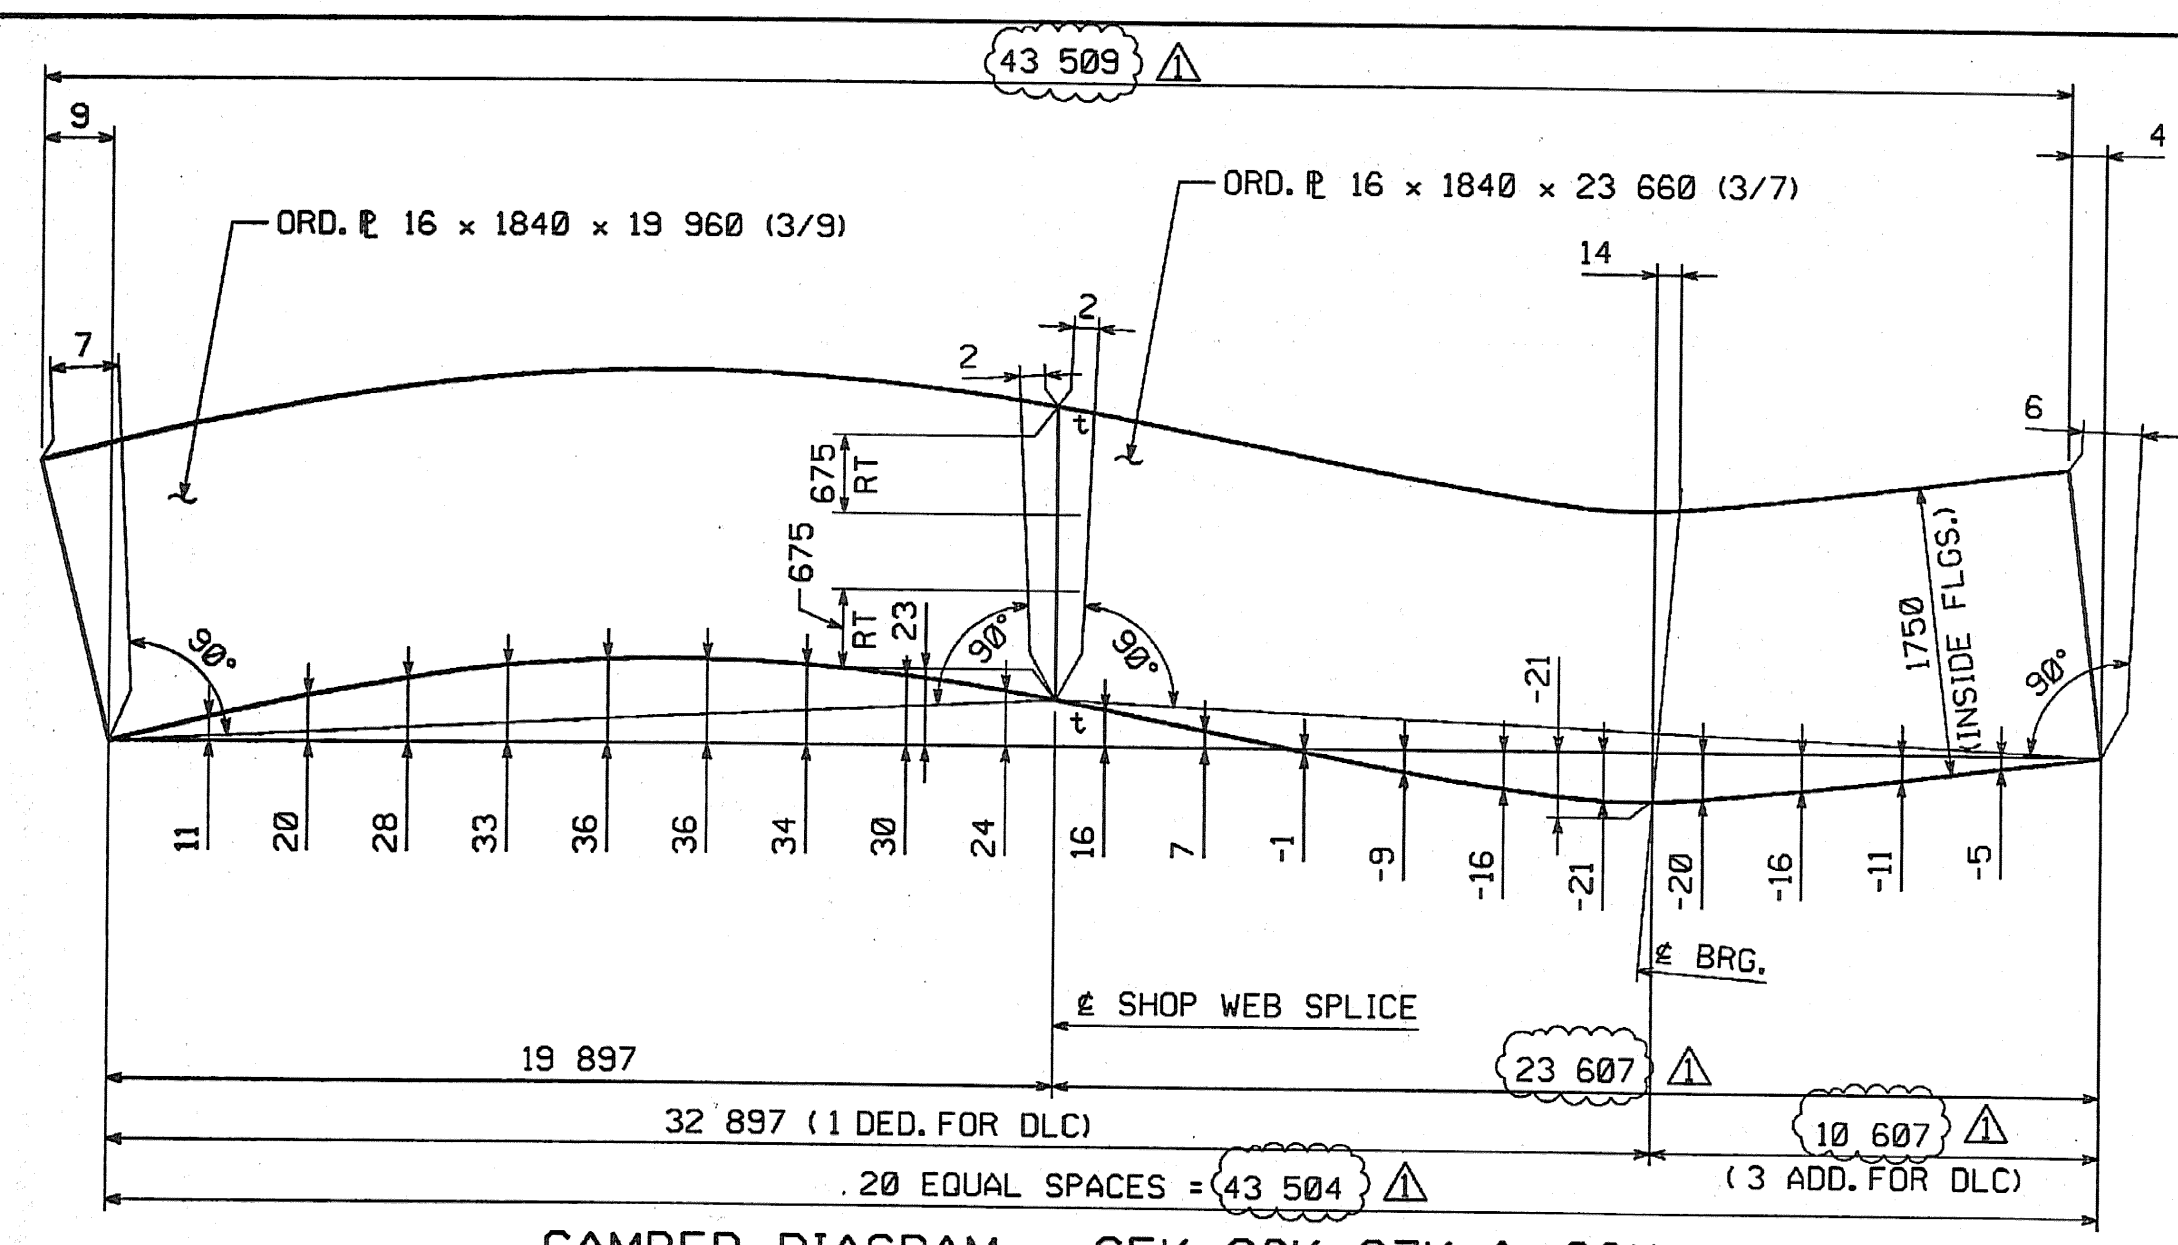

CAMBER DIAGRAM - G5K, G6K, G7K, & G8K

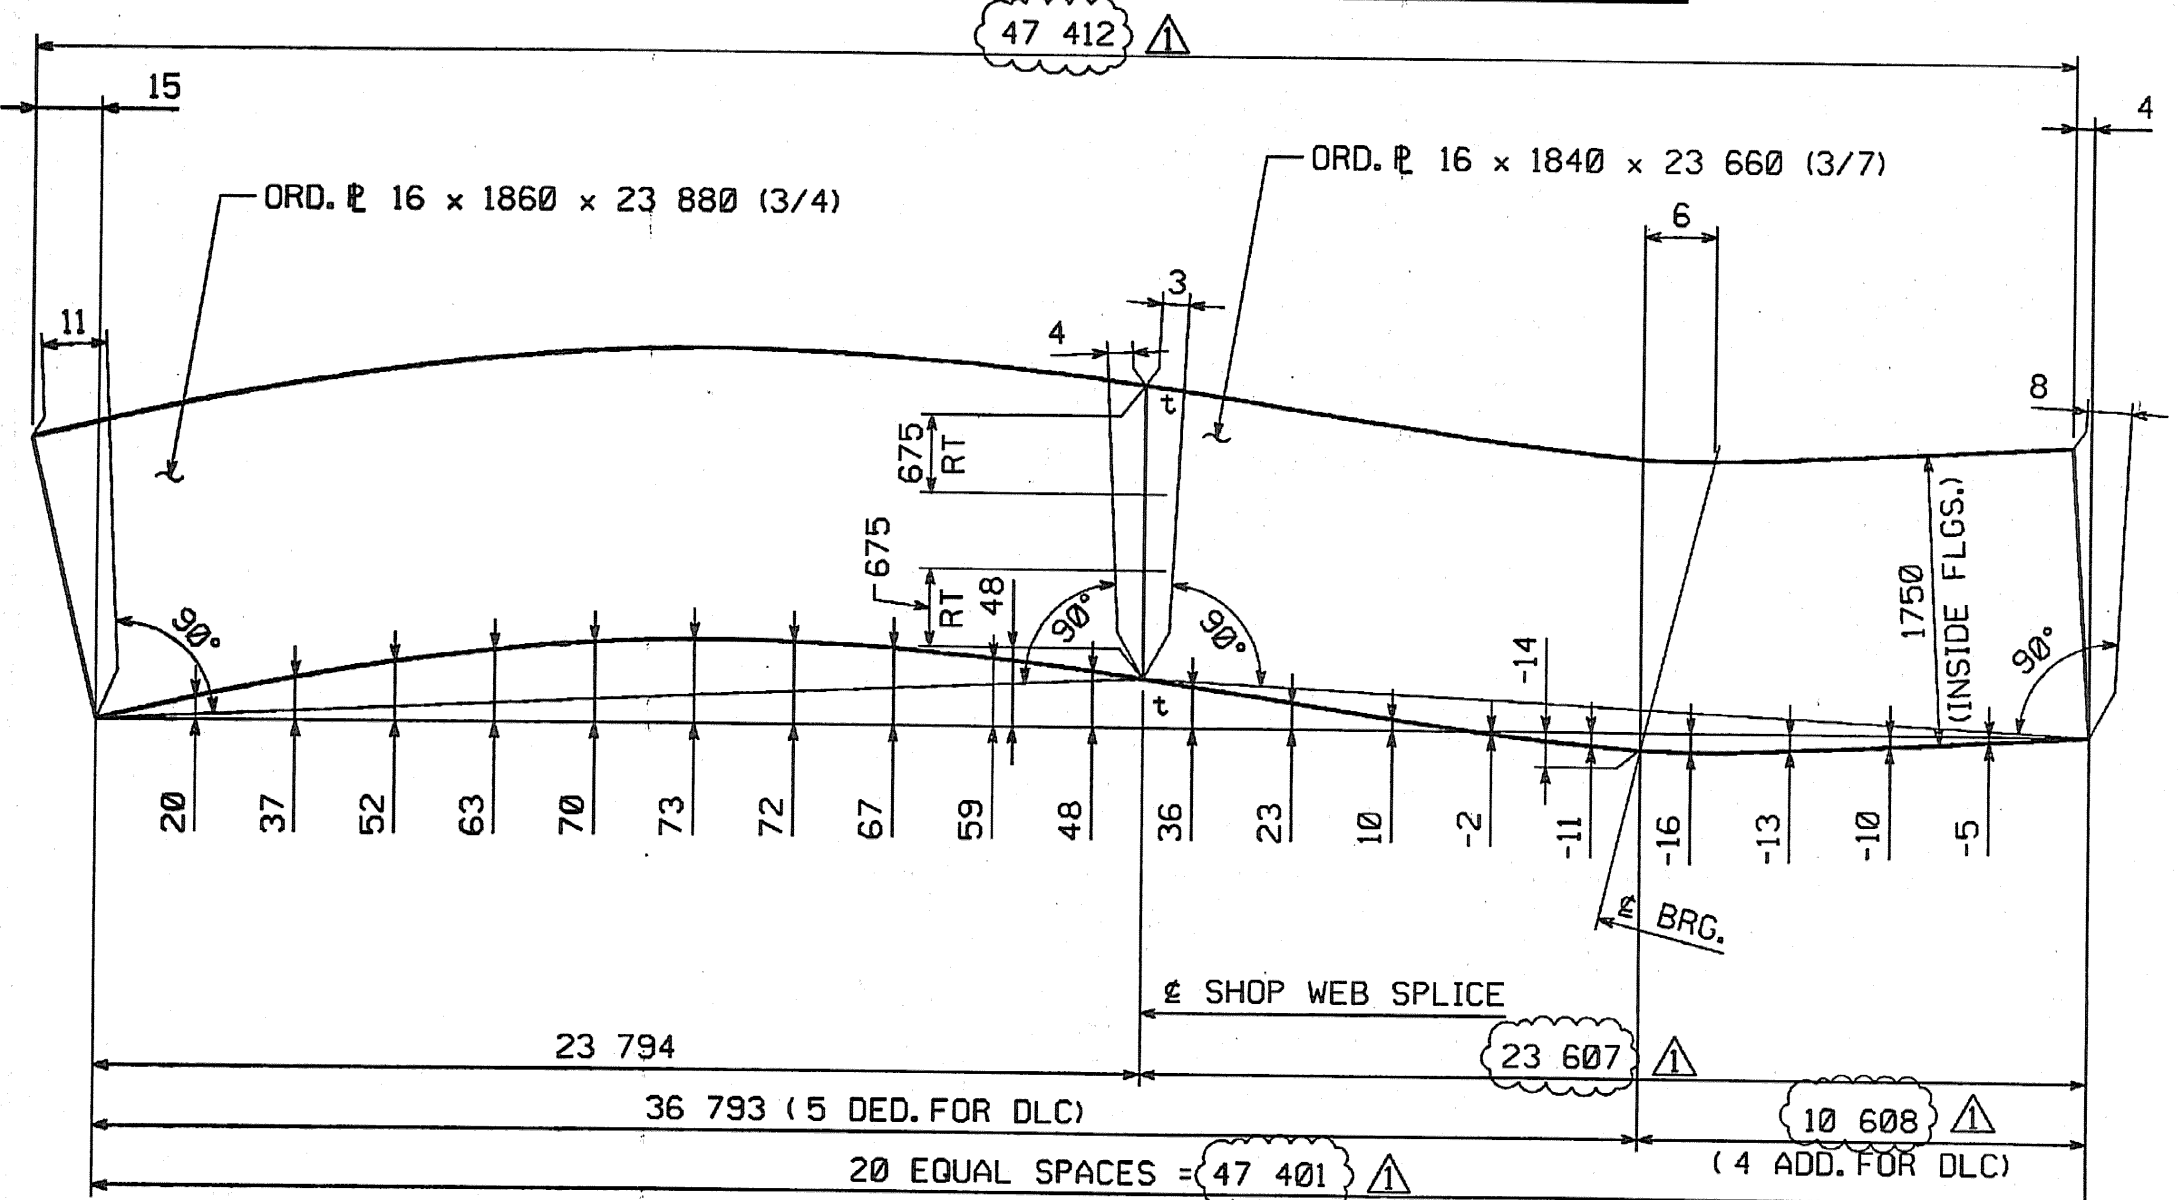

CAMBER DIAGRAM - G5L, G6L, G7L, & G8L

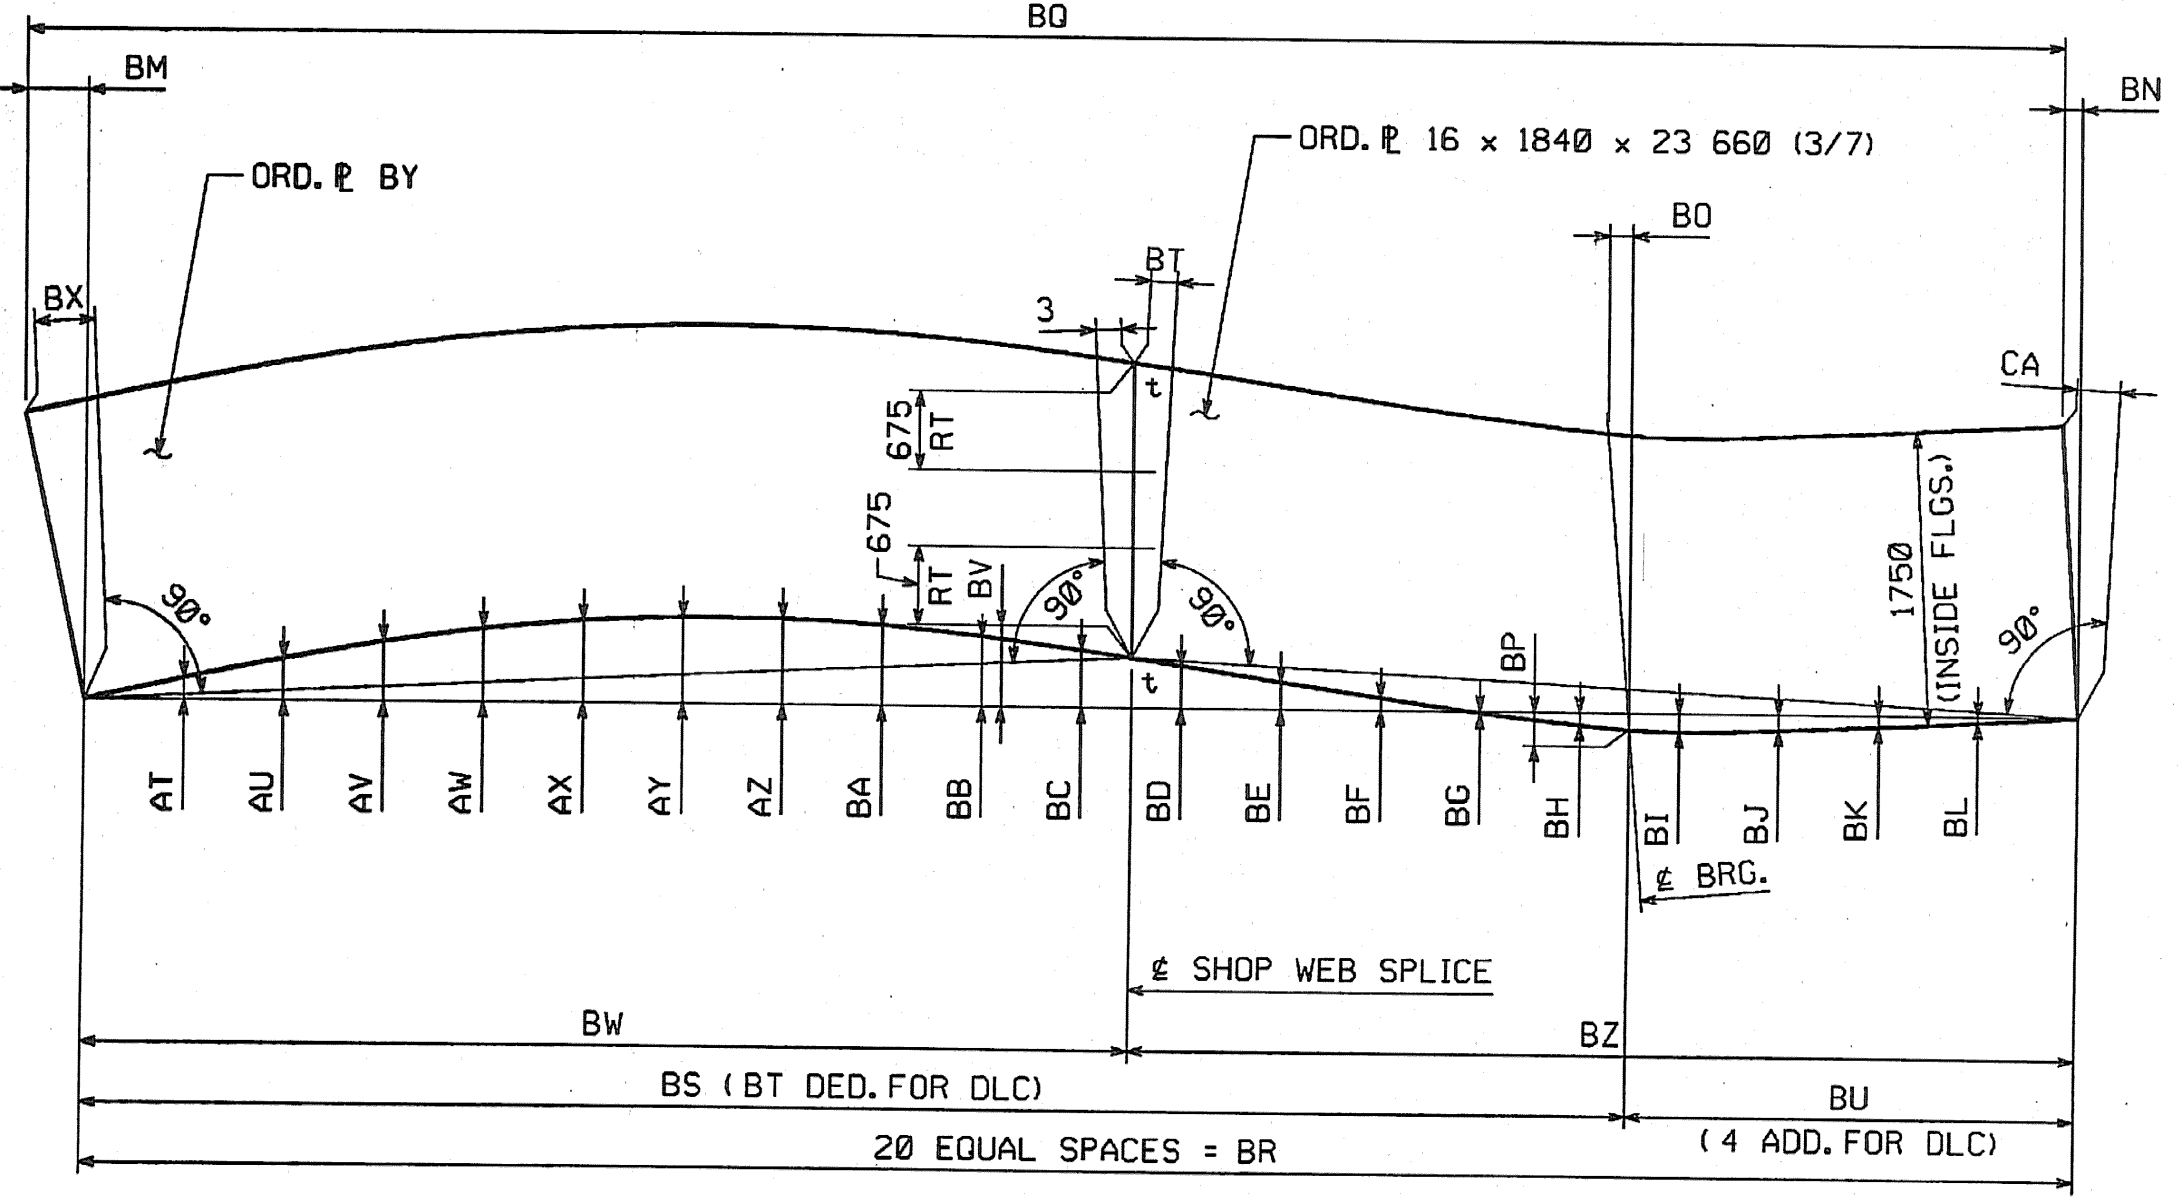


CAMBER DIAGRAM - G5N, G6N, G7N, & G8N

MARK	AT	AU	AV	AW	AX	AY	AZ	BA	BB	BC	BD	BE	BF	BG	BH	BI	BJ	BK	BL	BM	BN	BO	BP	BQ	BR	BS	BT	BU	BV
G5M THRU G8M	18	34	48	59	65	69	68	64	56	46	34	22	10	-1	-10	-14	-13	-9	-5	13	3	4	-13	47 411	47 401	36 794	4	10 607	45
G5N THRU G8N	17	33	46	56	62	65	64	58	50	39	27	15	4	-7	-16	-20	-17	-12	-6	12	5	14	-13	47 412	47 403	36 795	3	10 608	39

MARK	BW	BX	BY	BZ	CA
G5M THRU G8M	23 795	10	16 x 1840 x 23 880 (3/6)	23 606	6
G5N THRU G8N	23 796	9	16 x 1860 x 23 880 (3/4)	23 607	8

METRIC 1. ALL DIMENSIONS ARE IN MILLIMETERS UNLESS OTHERWISE NOTED. 2. ALL WEIGHTS ARE IN KILOGRAMS.

FED. ROAD DIV. NO.	STATE	FED. AID PROJ. NO.
	VT	

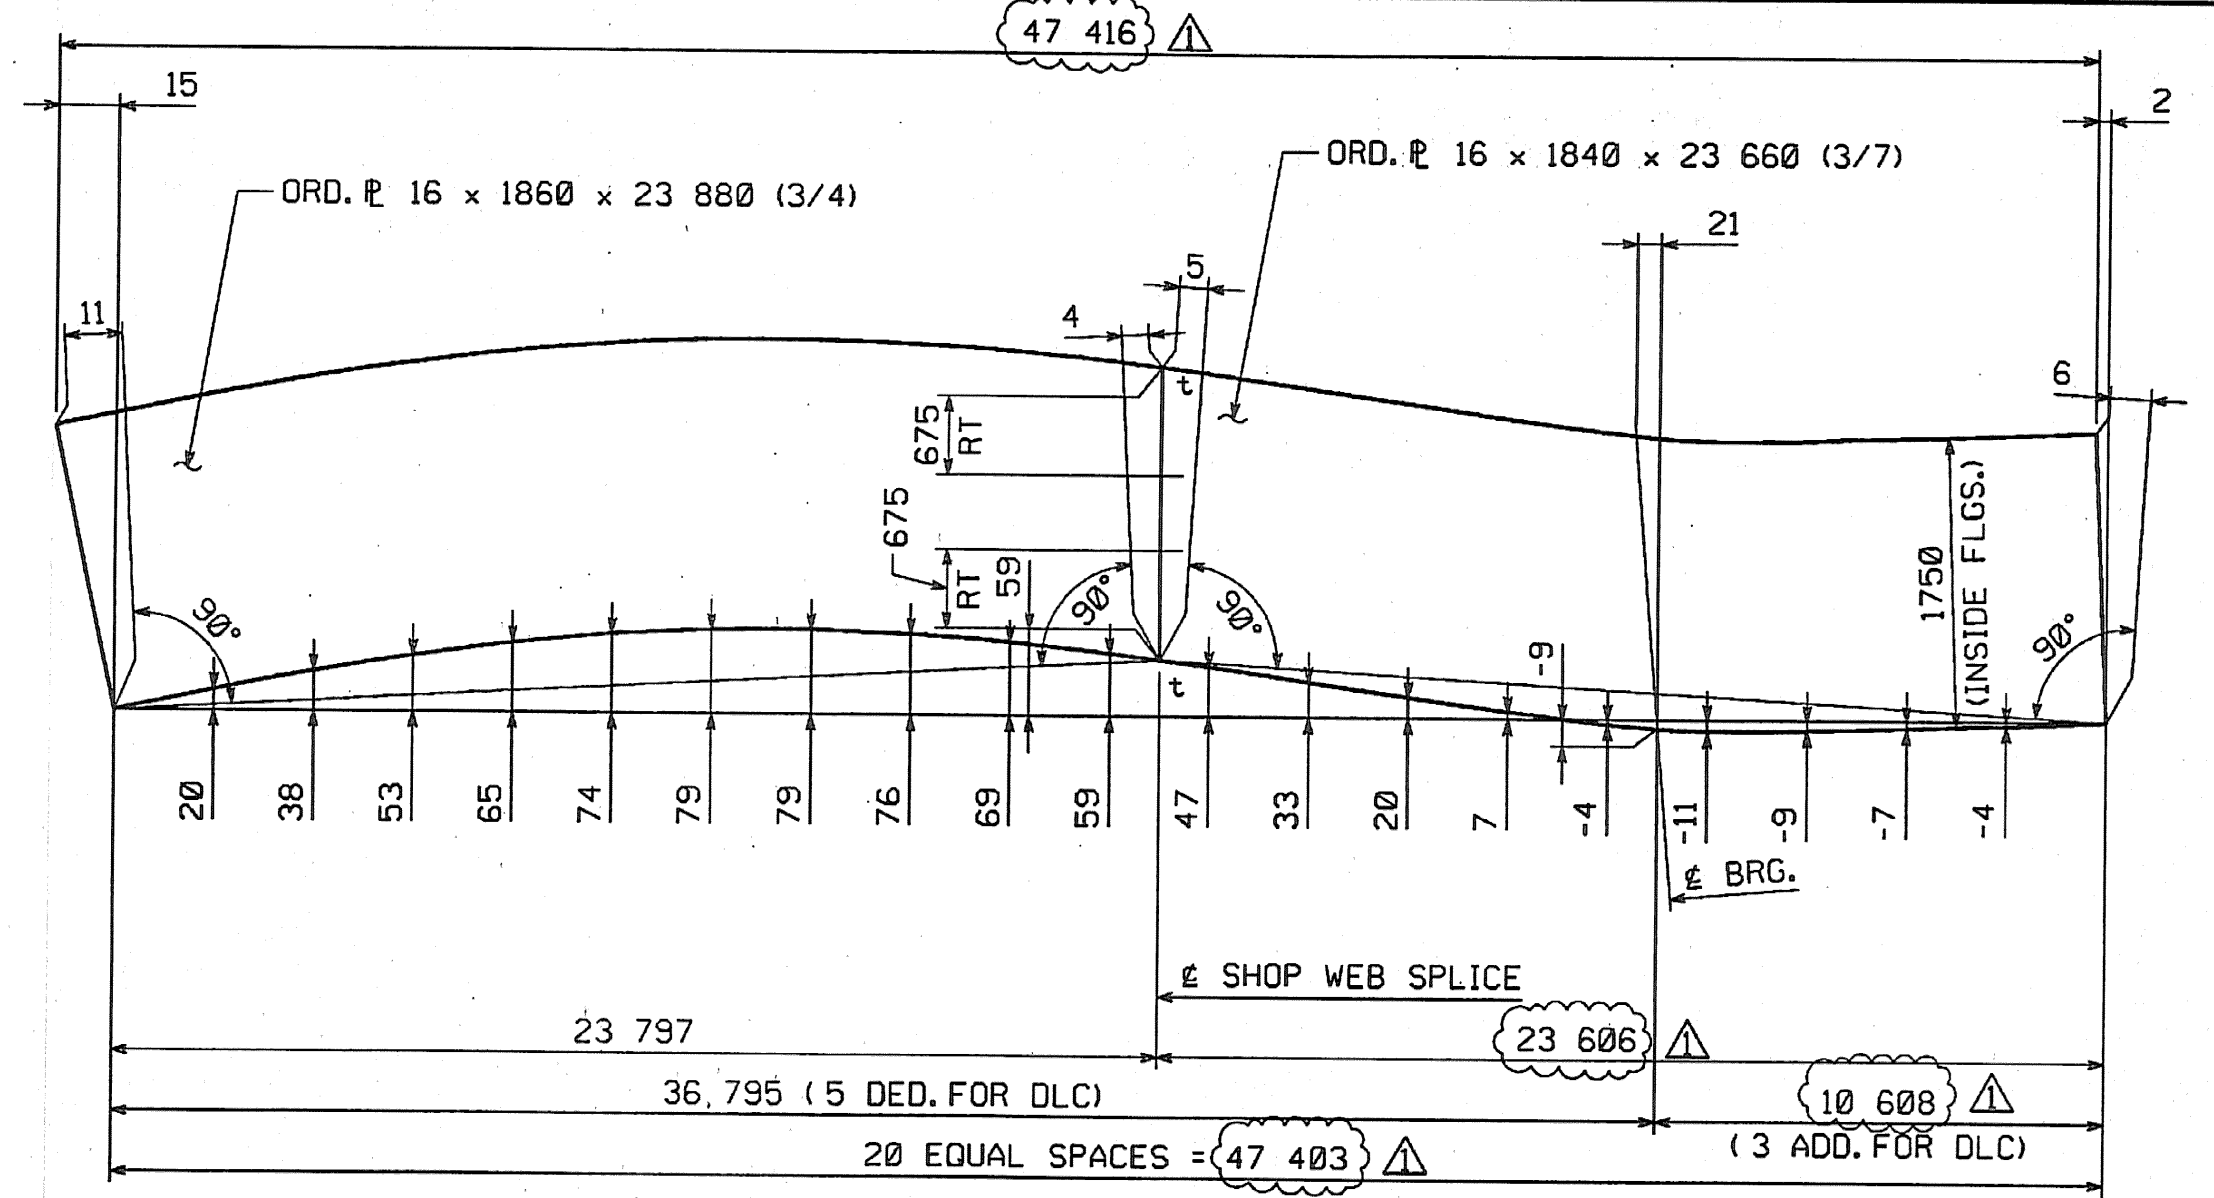

CAMBER DIAGRAM - G5O, G6O, G7O, & G8O

NOTES:
FOR WELDING DETAILS AND OTHER NOTES, SEE DWG. WC1.

NO.	REVISION	BY	DATE
1	INCREASE LENGTHS TO SATISFY REQUIREMENTS FOR LENGTH & MEAN TEMPERATURE OF 45°F.	DP	9/17/04

SHOP DRAWING REVIEW

REVIEWED AS REQUIRED BY THE CONSTRUCTION CONTRACT DOCUMENTS AND APPROVED, BUT ONLY FOR CONFORMANCE TO THE DESIGN CONCEPT OF THE WORK, AND SUBJECT TO FURTHER LIMITATIONS AND REQUIREMENTS CONTAINED IN THE CONSTRUCTION CONTRACT DOCUMENTS.

REJECTED REVISE AND RESUBMIT FURNISH AS CORRECTED

CORRECTIONS OR COMMENTS MADE ON THE SHOP DRAWINGS DURING THIS REVIEW DO NOT RELIEVE CONTRACTOR FROM COMPLIANCE WITH REQUIREMENTS OF THE DRAWINGS AND SPECIFICATIONS. THIS CHECK IS ONLY FOR REVIEW OF GENERAL CONFORMANCE WITH THE DESIGN CONCEPT OF THE PROJECT AND GENERAL COMPLIANCE WITH THE INFORMATION GIVEN IN THE CONTRACT DOCUMENTS. THE CONTRACTOR IS RESPONSIBLE FOR CONFORMING AND CORRELATING ALL QUANTITIES AND DIMENSIONS; SELECTING FABRICATION PROCESSES AND TECHNIQUES OF CONSTRUCTION; COORDINATING HIS WORK WITH THAT OF ALL OTHER TRADES; AND PERFORMING HIS WORK IN A SAFE AND SATISFACTORY MANNER.

Vanasse Hangen Brustlin, Inc.
Engineers, Planners, and Scientists
80 Bedford Farms, Milton Rd.
Bedford, NH 03110, 603 644 0808

Job Number: 50011
Reviewed By: *Smtt*
Date: 11/10/04

HIGH STEEL STRUCTURES, INC.

1770 Hempstead Road
Lancaster, PA 17603-0008
Phone 717/299-5211

WEB CAMBER DIAGRAMS
VT 78 OVER MISSISSQUOI BAY, BRIDGE NO. 2
VT 78 STA.10+970.425 TO STA.12+059.775
TOWNS OF ALBURG AND SWANTON
COUNTIES OF GRAND ISLE AND FRANKLIN
STATE OF VERMONT, AGENCY OF TRANSPORTATION

STATE CONTRACT OR REF. NO. BRF-036-1(1)

CONTRACTOR: CIANBRO CORPORATION

IN CHARGE: GLIDDEN (IH) MADE BY: KMA CHK'D BY: SJA DATE: 7/9/04

CONTRACT NUMBER: VT-04057-2 DRAWING NUMBER: WC3 OF WC5

PLOTTED: 9/20/2004 1:03:41 PM