



SEE SHEET B3 FOR CONTINUATION

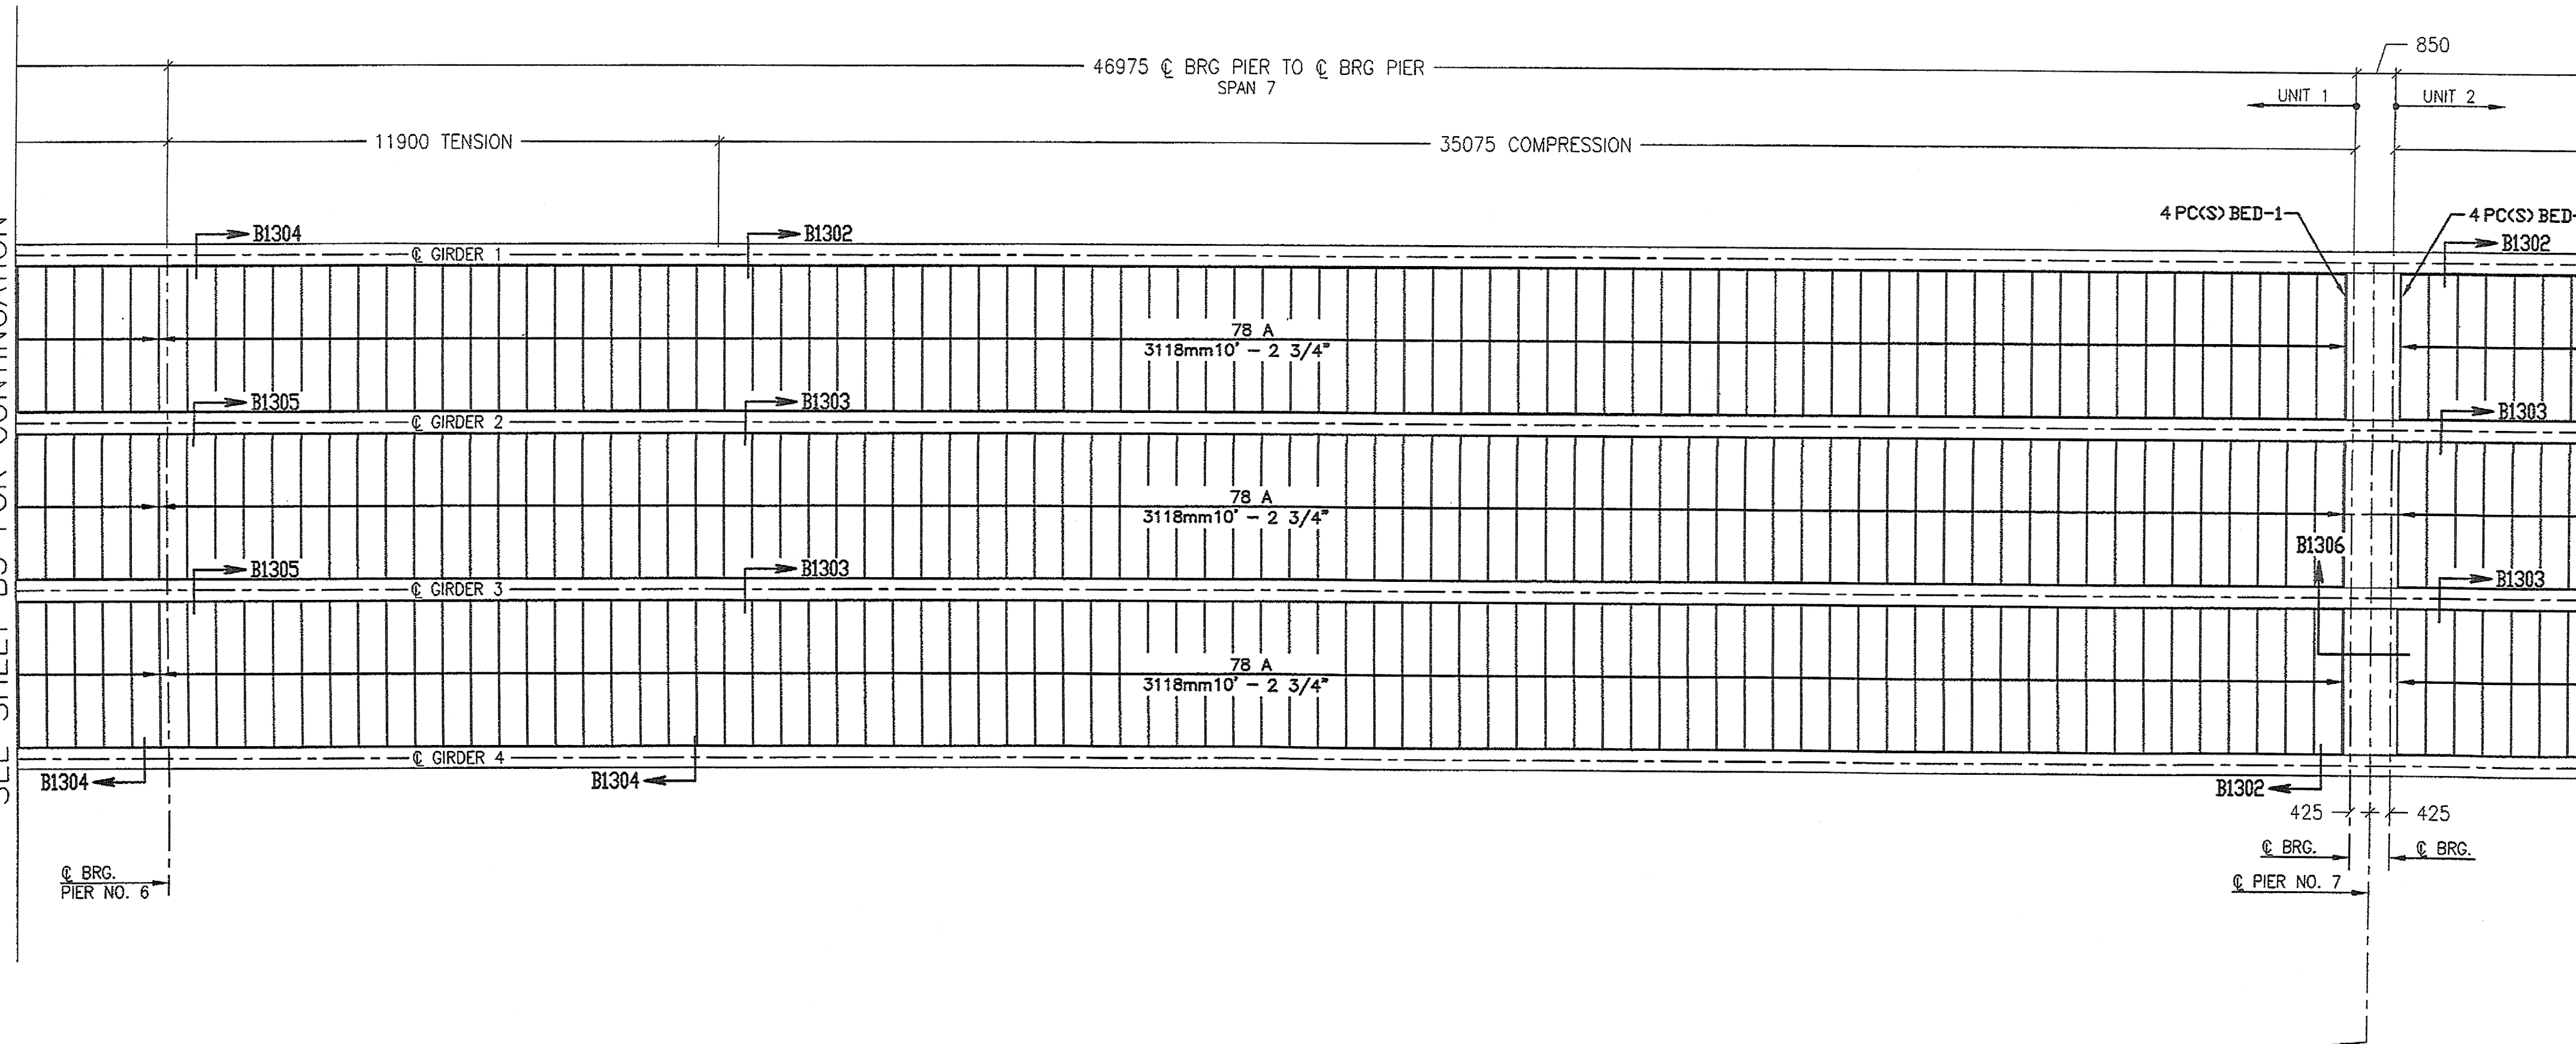

MATCHLINE

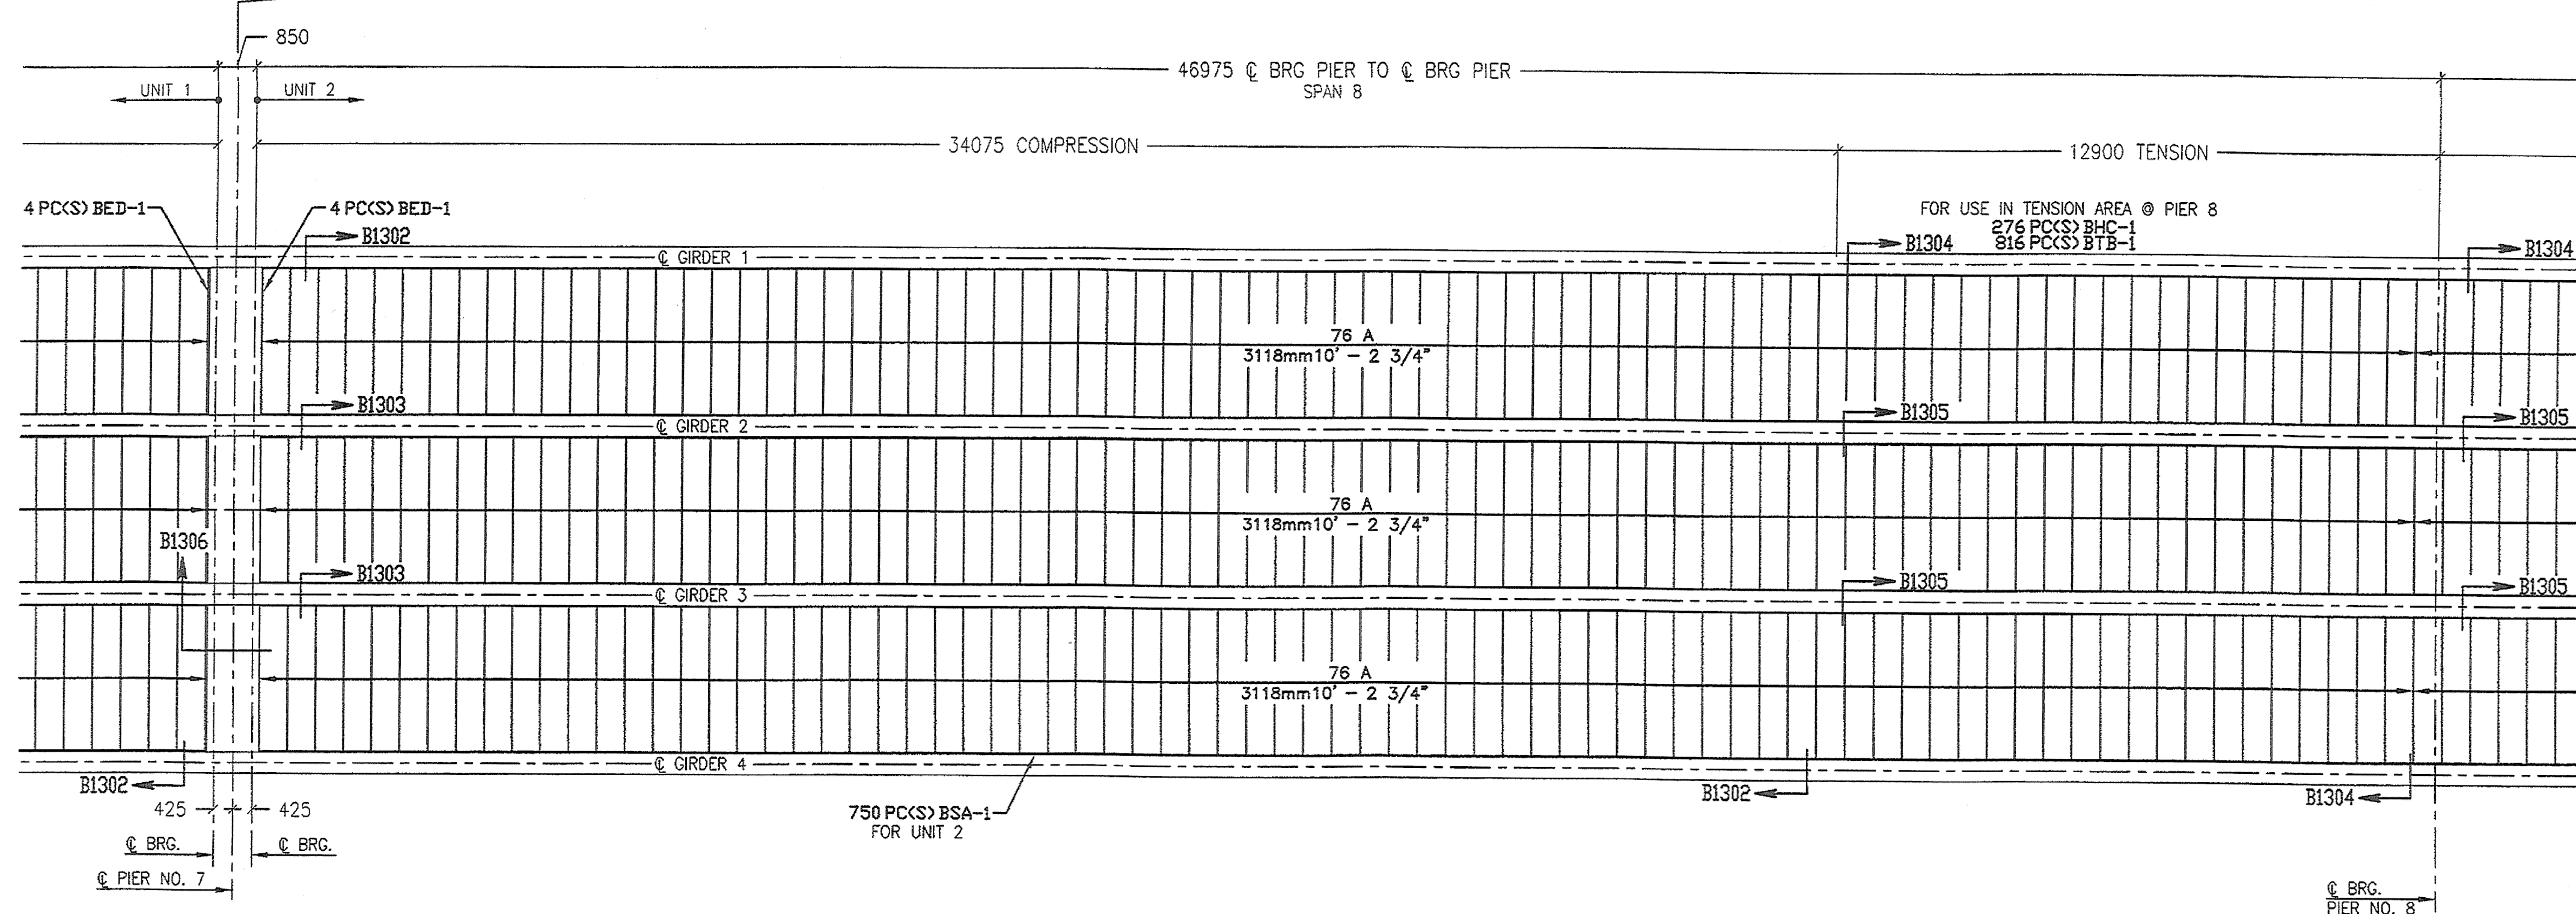

**UNIT 1 & 2  
BRIDGEFORM DECK PLAN  
SPANS 7 & 8**

114mm (4 1/2") X 305mm (12") PITCH 19 GA GALV G165 (MARK A)  
SCALE: 1:100

SEE SHEET B5 FOR CONTINUATION

**CONSTRUCTION**

**SHOP DRAWING REVIEW**

REVIEWED AS REQUIRED BY THE CONSTRUCTION CONTRACT DOCUMENTS AND APPROVED, BUT ONLY FOR CONFORMANCE TO THE DESIGN CONCEPT OF THE WORK, AND SUBJECT TO FURTHER LIMITATIONS AND REQUIREMENTS CONTAINED IN THE CONSTRUCTION CONTRACT DOCUMENTS.

REJECTED  REVISE AND RESUBMIT  FINISH AS CORRECTED

CORRECTIONS OR COMMENTS MADE ON THE SHOP DRAWINGS DURING THIS REVIEW DO NOT RELIEVE CONTRACTOR FROM COMPLIANCE WITH REQUIREMENTS OF THE DRAWINGS AND SPECIFICATIONS. THIS CHECK IS ONLY FOR REVIEW OF GENERAL CONFORMANCE WITH THE DESIGN CONCEPT OF THE PROJECT AND GENERAL COMPLIANCE WITH THE INFORMATION GIVEN IN THE CONTRACT DOCUMENTS. THE CONTRACTOR IS RESPONSIBLE FOR: CONFORMING AND CORRELATING ALL QUANTITIES AND DIMENSIONS; SELECTING FABRICATION PROCESSES AND TECHNIQUES OF CONSTRUCTION; COORDINATING HIS WORK WITH THAT OF ALL OTHER TRADES; AND PERFORMING HIS WORK IN A SAFE AND SATISFACTORY MANNER.

**VHB** Vanessa Hengen Brustlin, Inc.  
Engineers, Planners, and Scientists  
Six Bedford Pkwy., Waton 010  
Boston, MA 02110 617-552-0888

Job Number: 80911  
Reviewed By: *[Signature]*  
Date: 8-27-05

**Wheeling Corrugating Company**  
Since 1890  
134 WILMOT ST., WHEELING, WEST VIRGINIA, 26060  
PHONE: 304-231-3200

CUSTOMER: CIANBRO  
PROJECT: MISSISSOUI BAY BRIDGE  
OVER VT 76 (PRINCIPAL ARTERIAL)  
LOCATION: OVER MISSISSOUI BAY BRIDGE NO. 2  
COUNTIES OF GRAND ISLE AND FRANKLIN  
OWNER: STATE OF VERMONT AGENCY OF TRANSPORTATION  
DATE CHECKED: 3/21/05  
DATE DRAWN: 3/28/05  
DRAWN BY: LUCAS  
PROJECT # BR-036 - 1 (1)

PRINTS ISSUED

No.	DATE	FOR
0/6	3/29	APPROVAL
E-0/8	4/21	APPROVAL
E	4/22	APPROVAL
E	5/13	APPROVAL

**SYMBOLS**

--- SED. LINE  
--- AREA LINE  
# SED. MARK  
# AREA MARK  
E.O.D. END OF DECK  
E.O.S. END OF DRAWING

NUMBER OF DECK SHEETS: 11  
DECK SYMBOL: 1A  
SHEET LENGTH: 0-0

PROJECT # BR-05-27

**B4**

SHEET 4 OF 13

EACH SHEET MUST BE FASTENED TO SUPPORTS IMMEDIATELY UPON PLACEMENT TO AVOID HAZARD THAT COULD RESULT FROM HORIZONTAL MOVEMENT OR SUDDEN UPLIFT