



SEE SHEET B4 FOR CONTINUATION

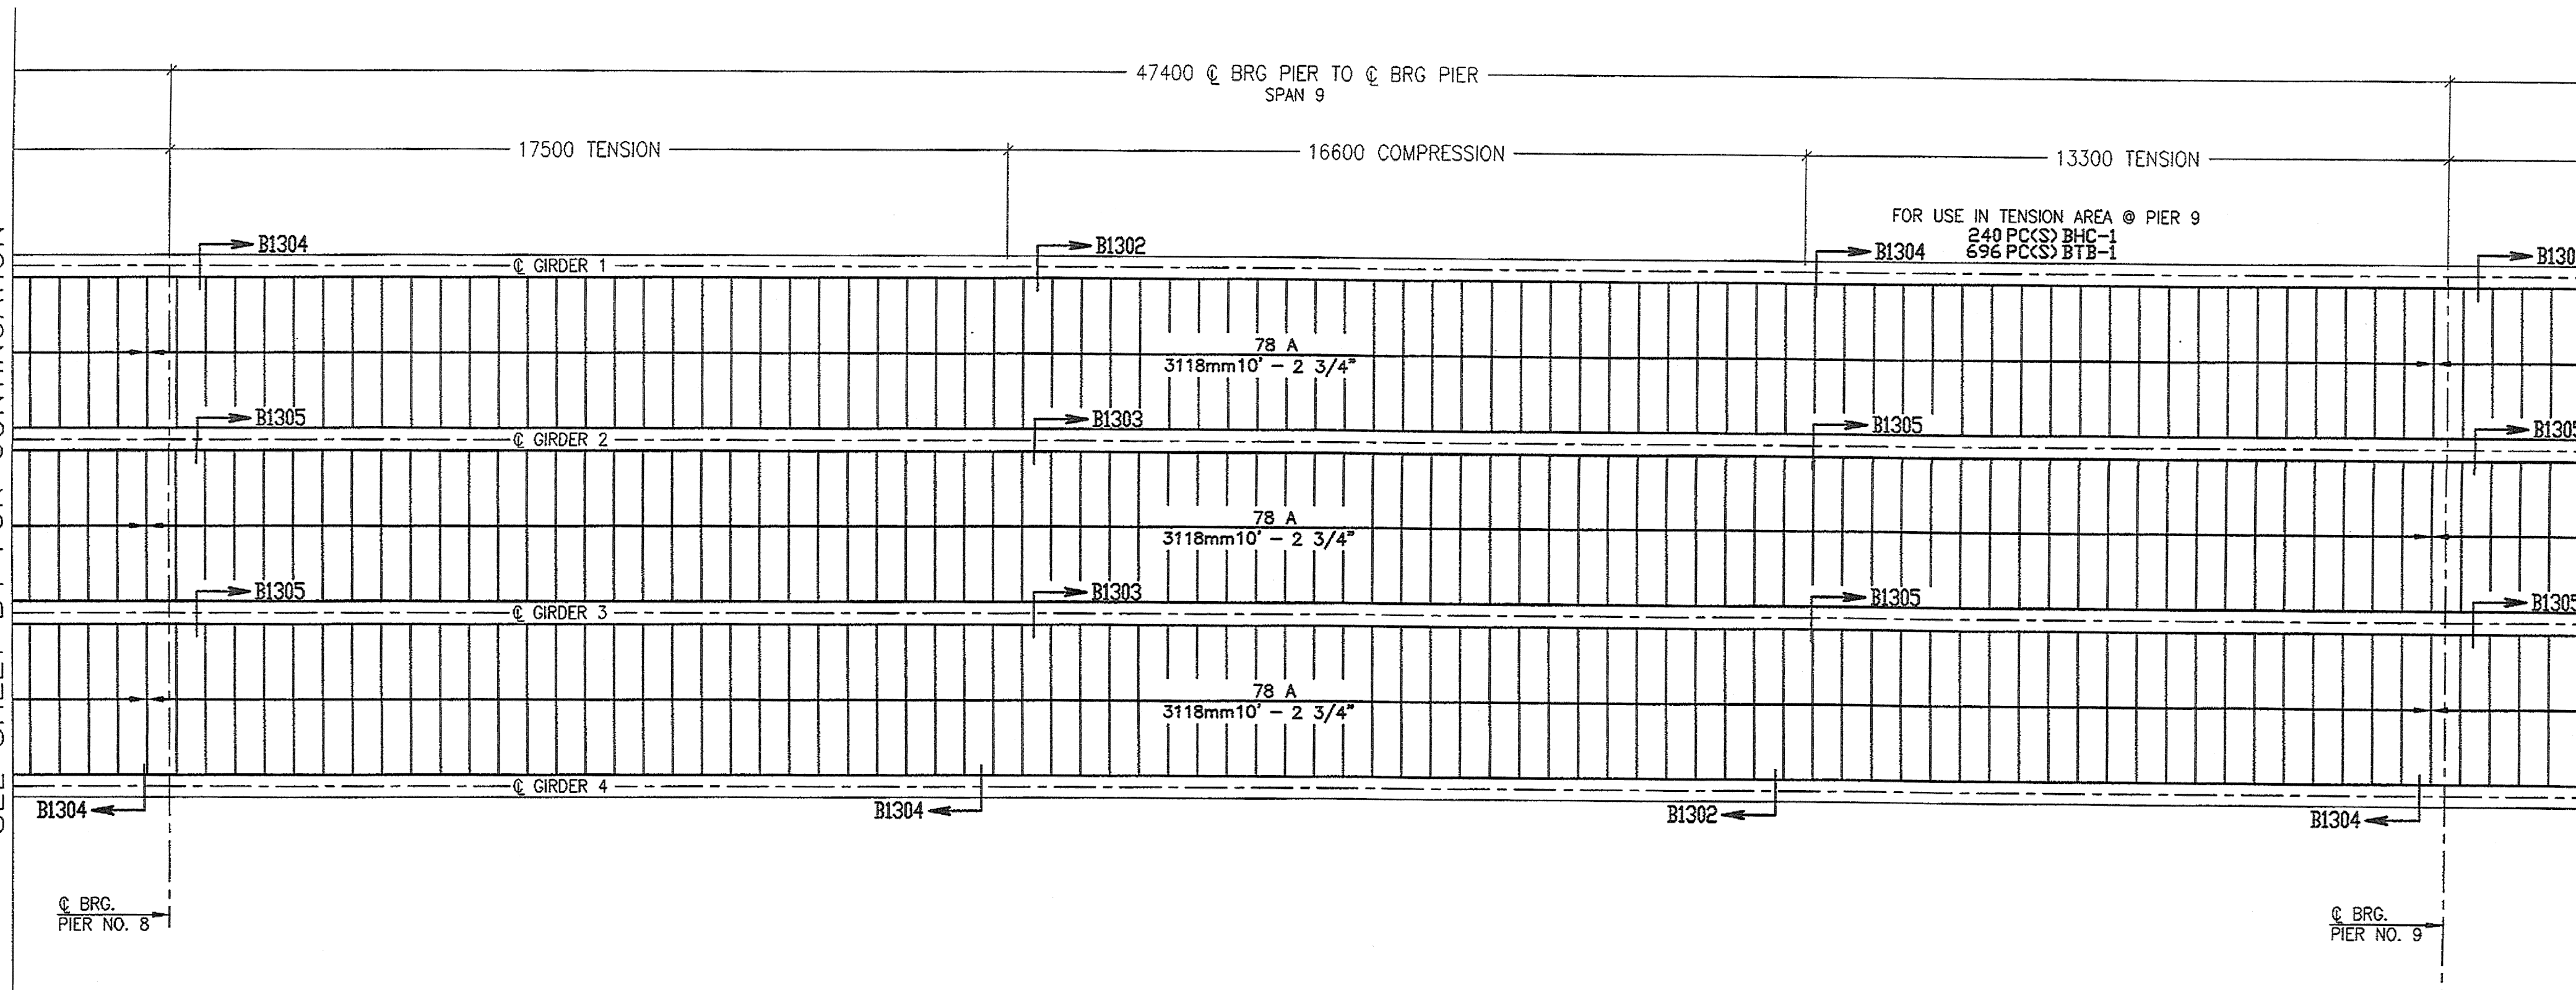

MATCHLINE

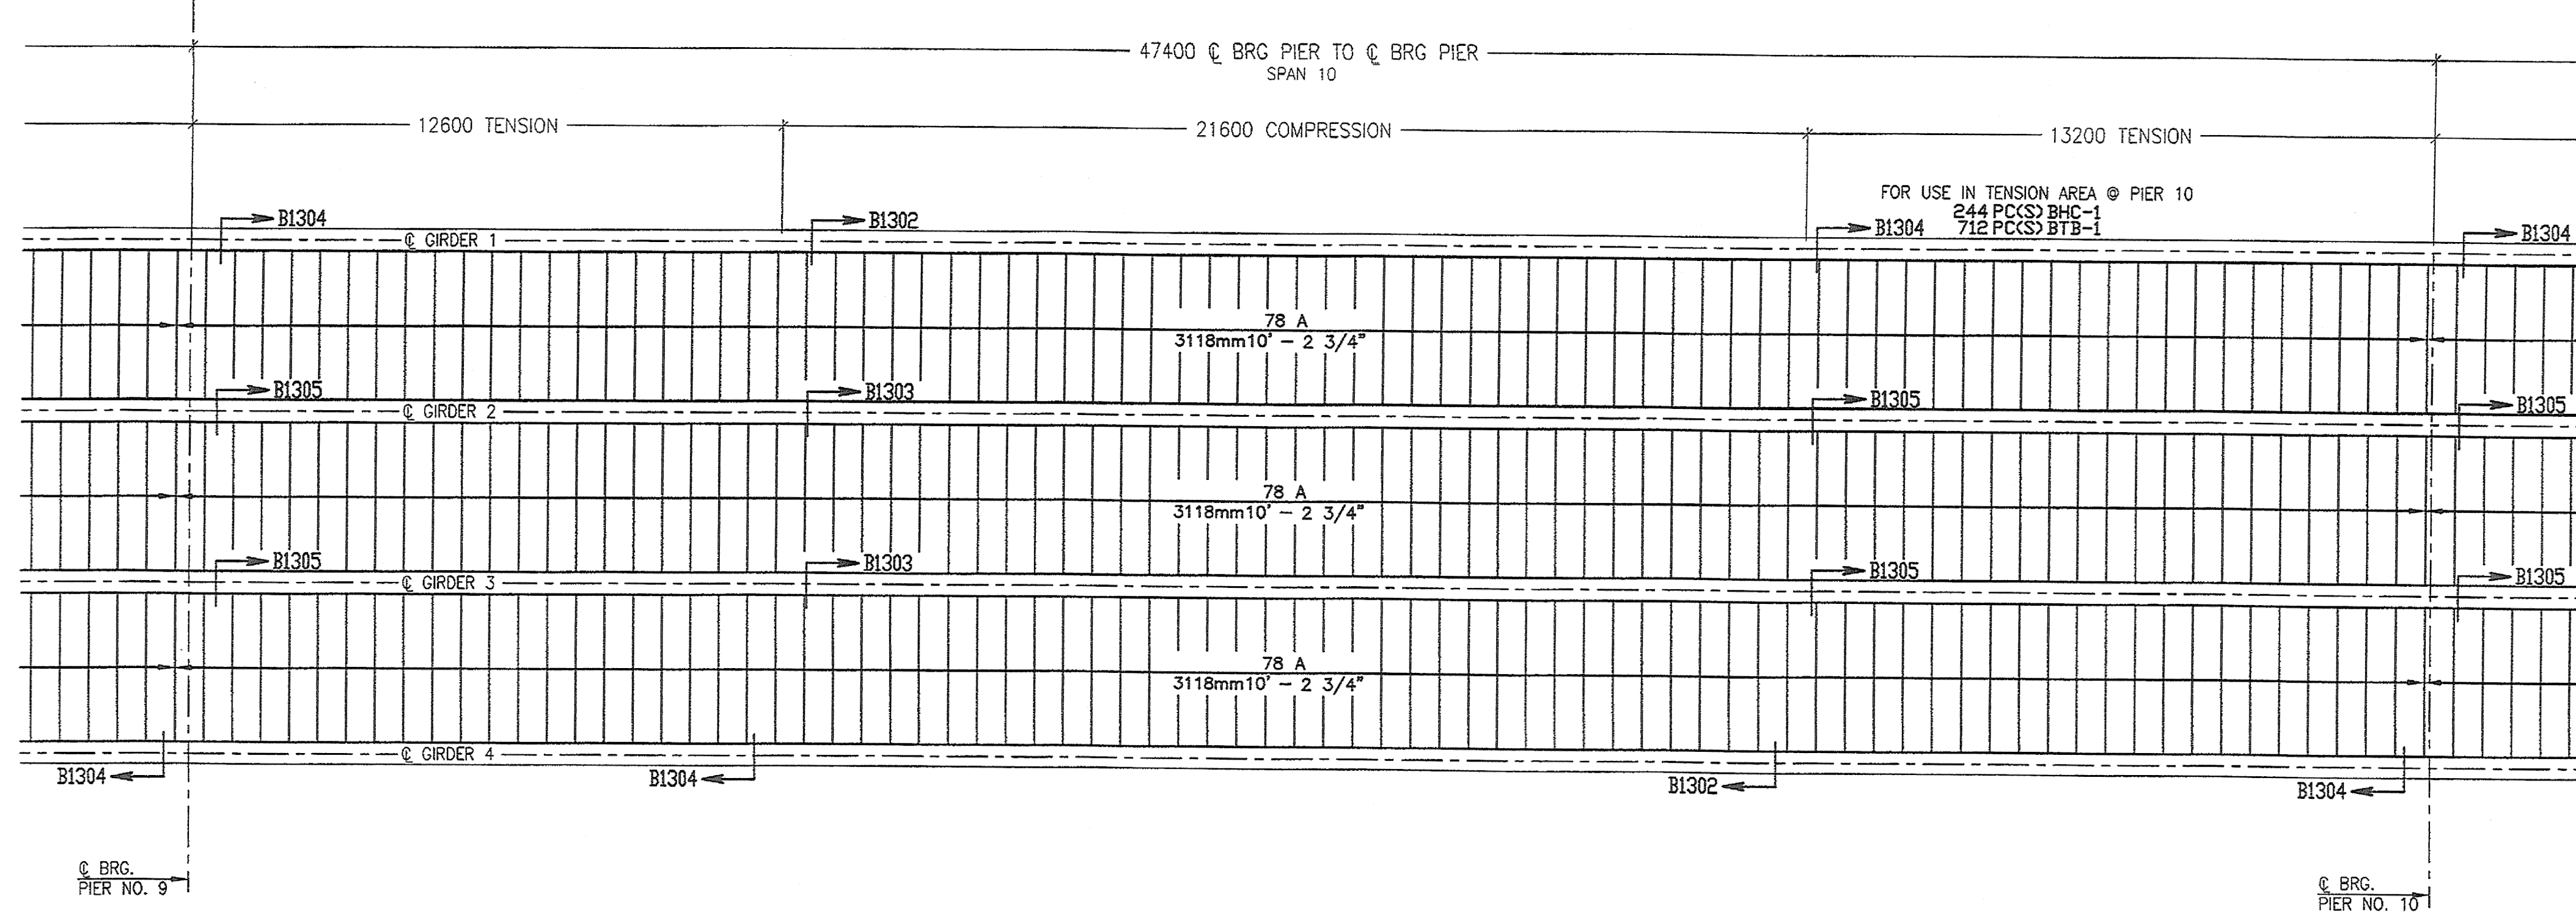

SEE SHEET B6 FOR CONTINUATION

**UNIT 2
BRIDGEFORM DECK PLAN
SPANS 9 & 10**

114mm (4 1/2") X 305mm (12") PITCH 19 GA GALV G165 (MARK A)
SCALE: 1:100

CONSTRUCTION SHOP DRAWING REVIEW

REVIEWED AS REQUIRED BY THE CONSTRUCTION CONTRACT DOCUMENTS AND APPROVED, BUT ONLY FOR CONFORMANCE TO THE DESIGN CONCEPT OF THE WORK, AND SUBJECT TO FURTHER LIMITATIONS AND REQUIREMENTS CONTAINED IN THE CONSTRUCTION CONTRACT DOCUMENTS.

REJECTED REVISE AND RESUBMIT FURNISH AS CORRECTED

CORRECTIONS OR COMMENTS MADE ON THE SHOP DRAWINGS DURING THIS REVIEW DO NOT RELIEVE CONTRACTOR FROM COMPLIANCE WITH REQUIREMENTS OF THE DRAWINGS AND SPECIFICATIONS. THIS CHECK IS ONLY FOR REVIEW OF GENERAL CONFORMANCE WITH THE DESIGN CONCEPT OF THE PROJECT AND GENERAL COMPLIANCE WITH THE INFORMATION GIVEN IN THE CONTRACT DOCUMENTS. THE CONTRACTOR IS RESPONSIBLE FOR CORRECTING AND CORRELATING ALL QUANTITIES AND DIMENSIONS, SELECTING FABRICATION PROCESSES AND TECHNIQUES OF CONSTRUCTION, COORDINATING HIS WORK WITH THAT OF ALL OTHER TRADES, AND PERFORMING HIS WORK IN A SAFE AND SATISFACTORY MANNER.

VHB Vanessa Hanger Brustlin, Inc.
Engineers, Planners, and Scientists
Six Bedford Farms, Milton Rd.
Bedford, NH 02811 603 844 0888

Job Number: 55111
Reviewed By: *[Signature]*
Date: 6-27-05

Wheeling Corrugating Company
Since 1890
A DIVISION OF WHEELING PIPING AND STEEL CORPORATION
115 WILSON ST., WHEELING, WEST VIRGINIA 26060
Tel: (800) 331-3333


CIANBRO
MISSISSAUGA RAY BRIDGE
VT 78 (PRINCIPAL ARTERIAL)
OVER MISSISSAUGA BAY, BRIDGE NO. 2
COUNTIES OF GRAND ISLE AND FRANKLIN
STATE OF VERMONT AGENCY OF TRANSPORTATION

CUSTOMER: CIANBRO
PROJECT: MISSISSAUGA RAY BRIDGE
LOCATION: COUNTIES OF GRAND ISLE AND FRANKLIN
OWNER: STATE OF VERMONT AGENCY OF TRANSPORTATION

DATE CHECKED: 3/21/05
DATE: 3/28/05
PROJECT #: BR 036 - 1 (1)
DRAWN: GLH

PRINTS ISSUED

No.	DATE	FOR
0/8	3/28	APPROVAL
E-0/8	4/21	APPROVAL
E	4/22	APPROVAL
E	5/13	APPROVAL

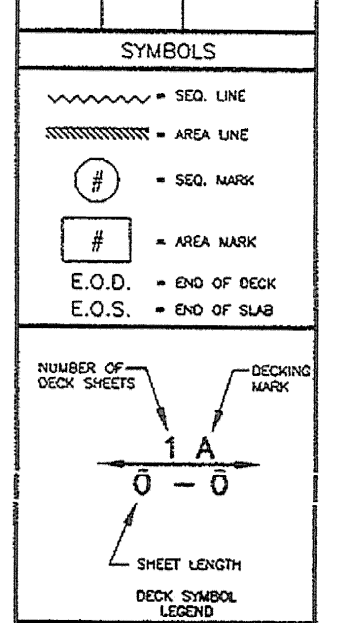

PROJECT # **BR-05-27**

B5
SHEET 5 OF 13

EACH SHEET MUST BE FASTENED TO SUPPORTS IMMEDIATELY UPON PLACEMENT TO AVOID HAZARD THAT COULD RESULT FROM HORIZONTAL MOVEMENT OR SUDDEN UPLIFT