



SEE SHEET B9 FOR CONTINUATION

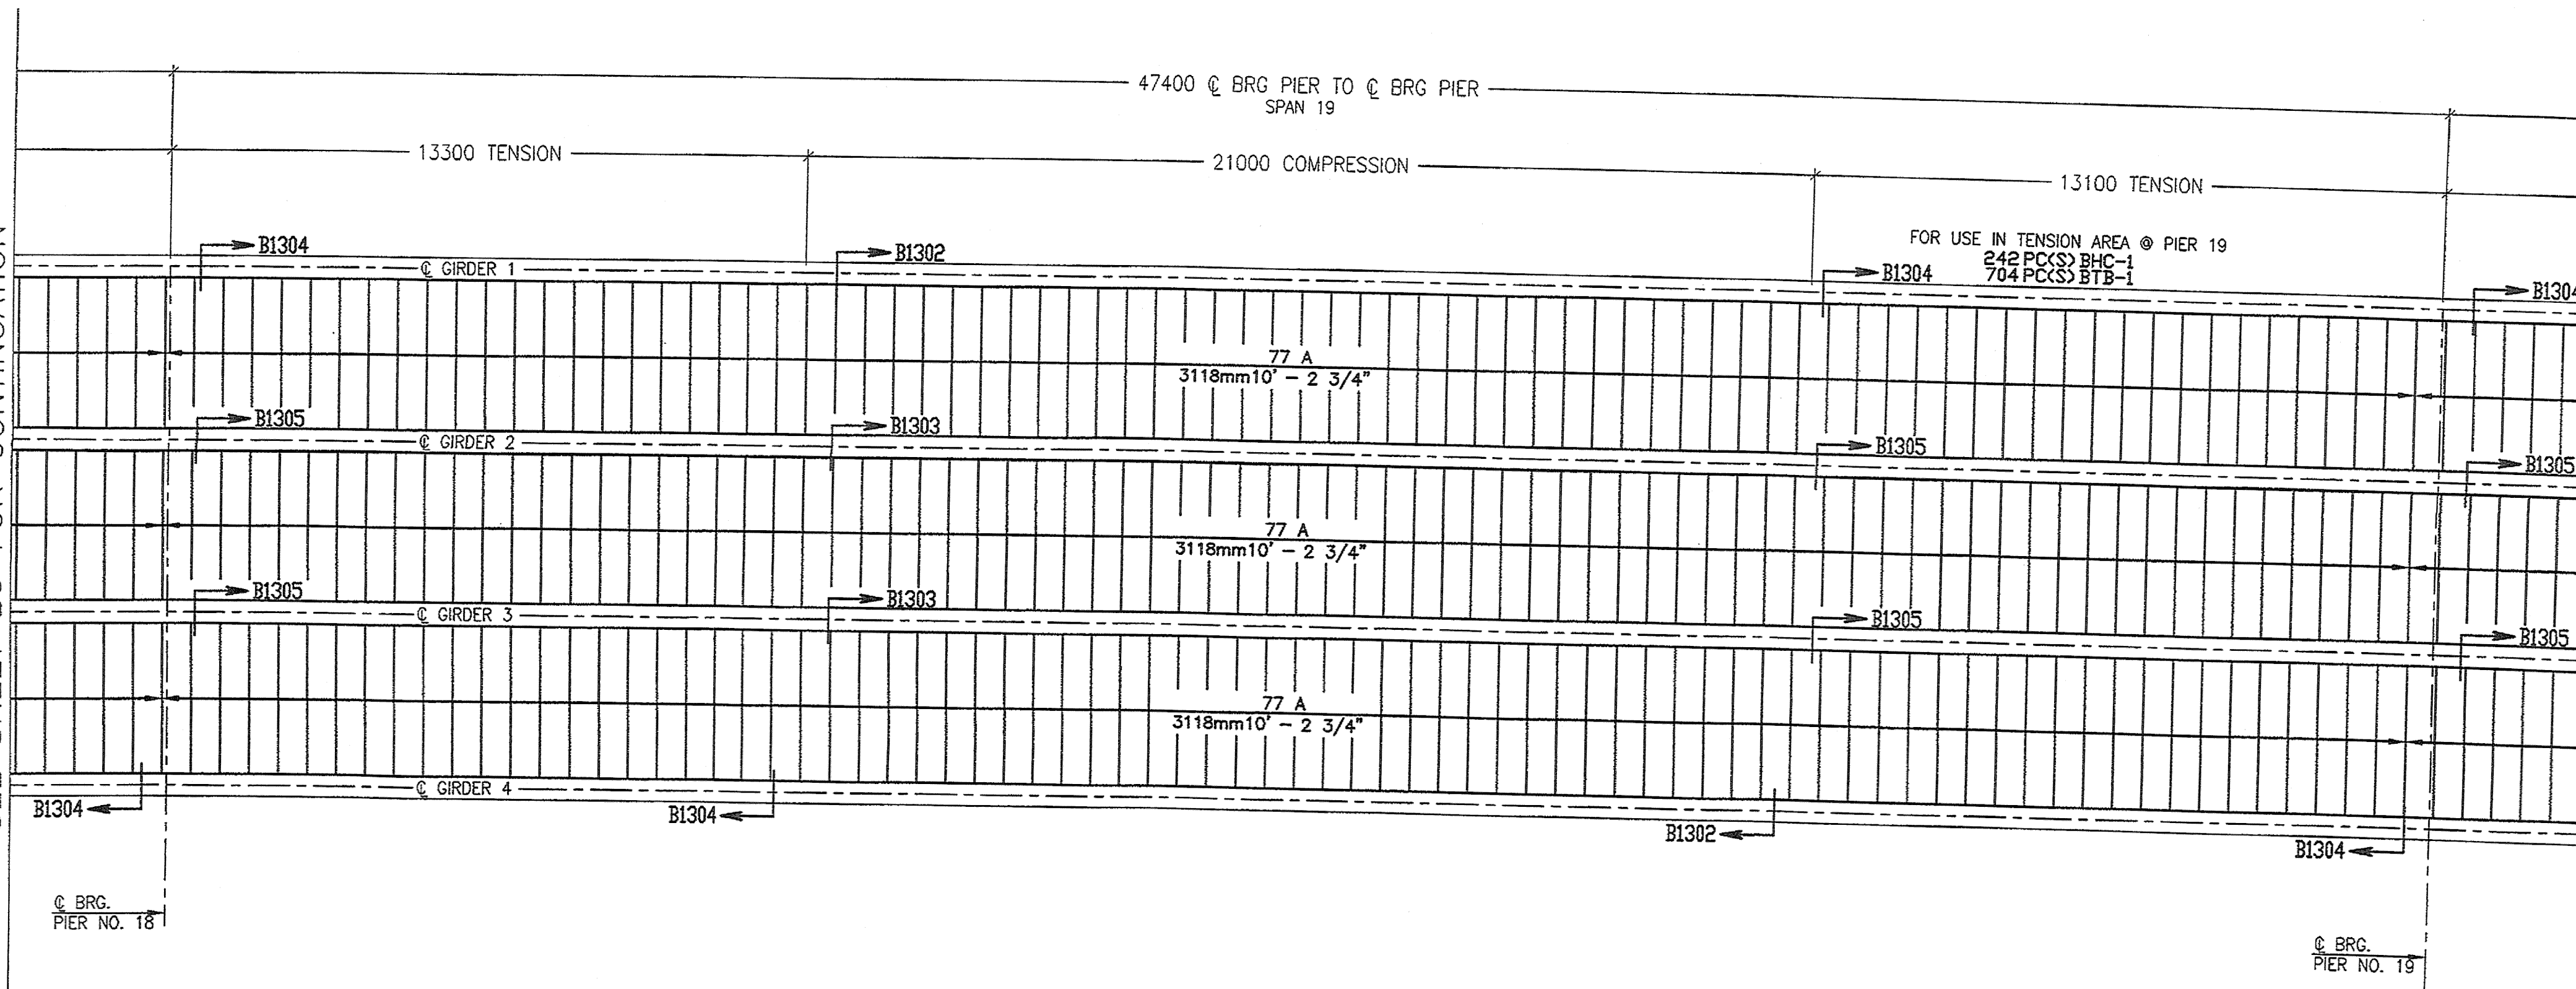

MATCHLINE

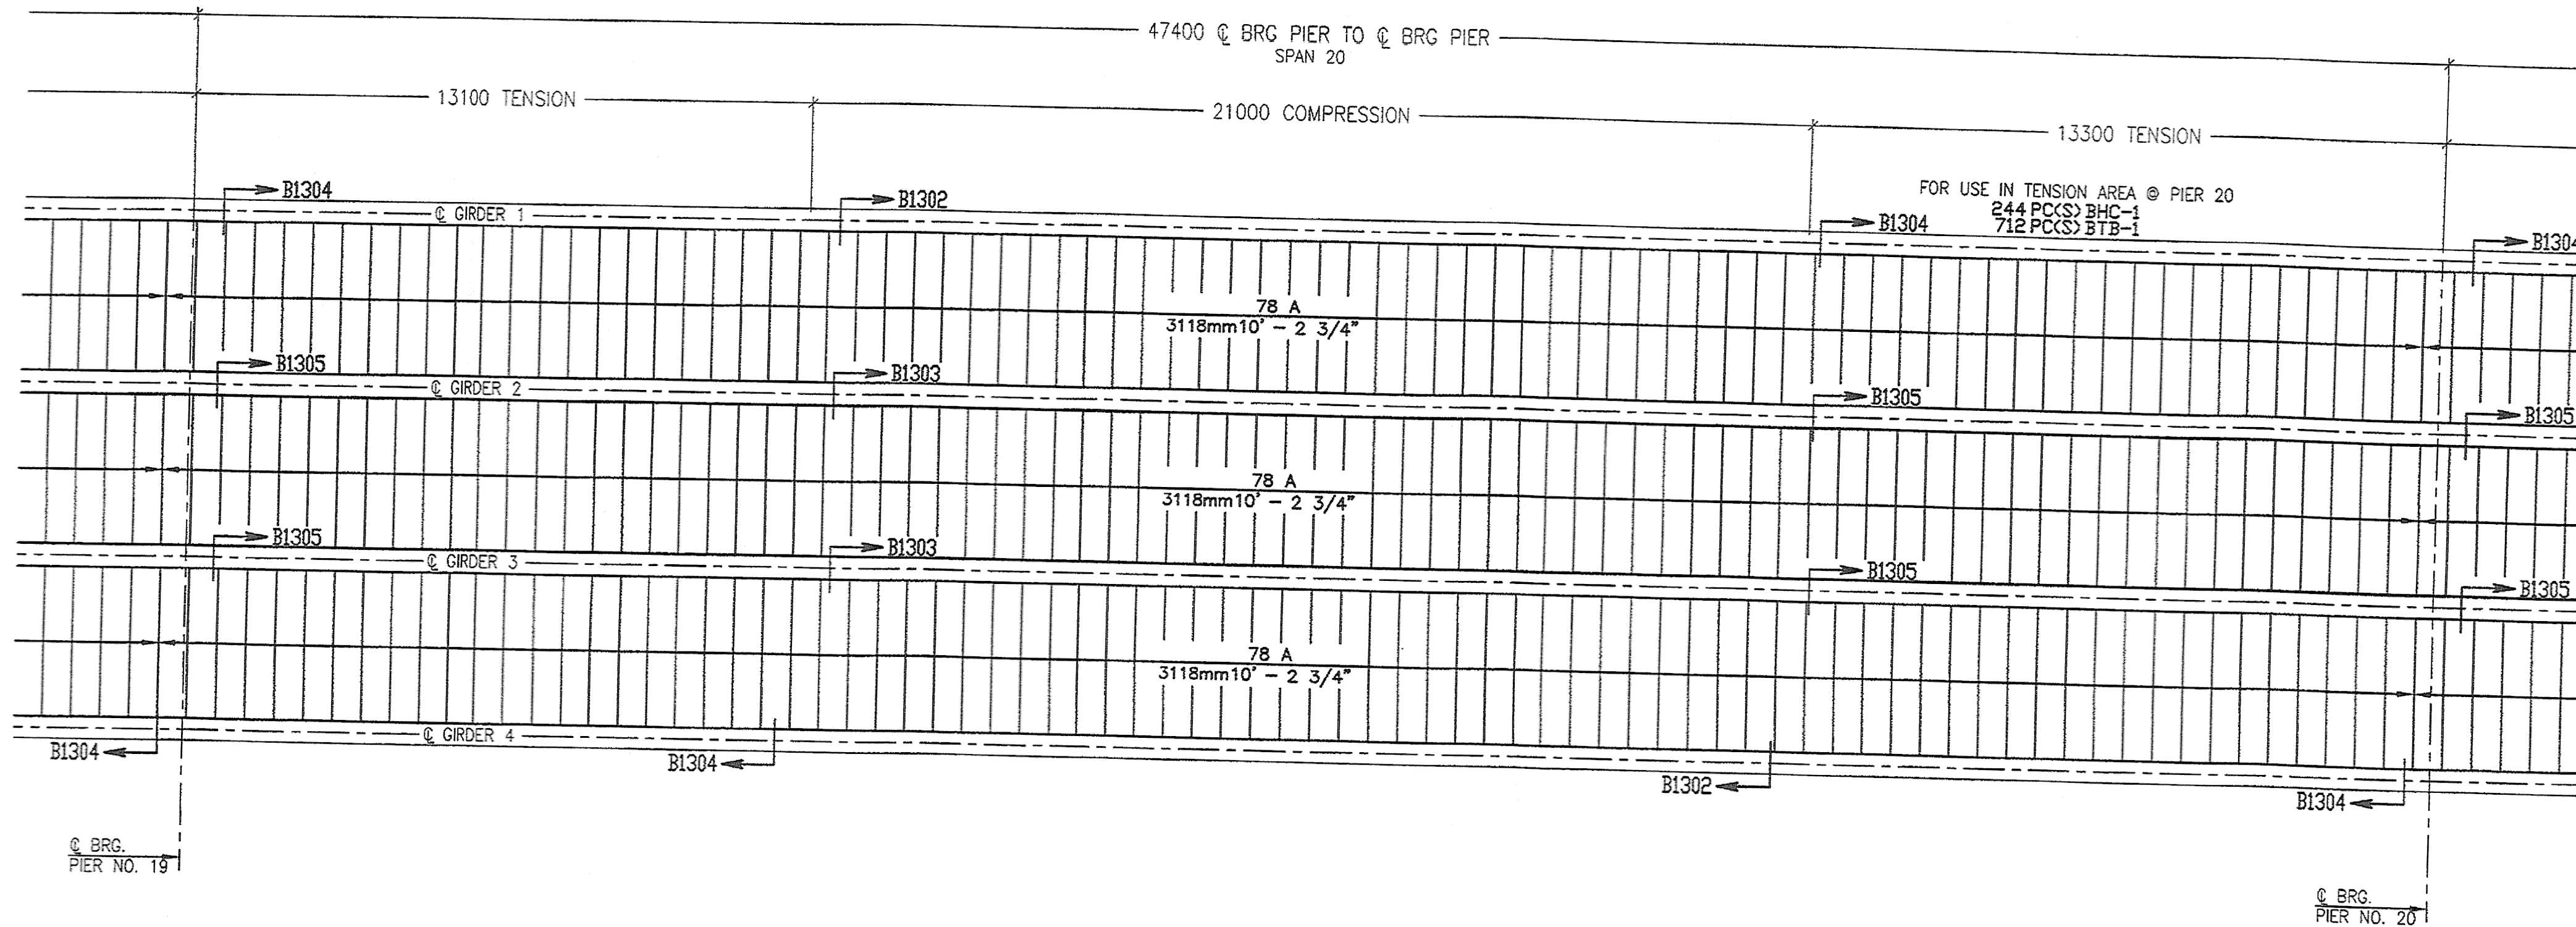

**UNIT 3
BRIDGEFORM DECK PLAN
SPANS 19 & 20**

114mm (4 1/2") X 305mm (12") PITCH 19 GA GALV G165 (MARK A)

SCALE: 1:100

SEE SHEET B11 FOR CONTINUATION

CONSTRUCTION SHOP DRAWING REVIEW

REVIEWED AS REQUIRED BY THE CONSTRUCTION CONTRACT DOCUMENTS AND APPROVED, BUT ONLY FOR CONFORMANCE TO THE DESIGN CONCEPT OF THE WORK, AND SUBJECT TO FURTHER LIMITATIONS AND REQUIREMENTS CONTAINED IN THE CONSTRUCTION CONTRACT DOCUMENTS.

REJECTED REVISE AND RESUBMIT FURNISH AS CORRECTED

CORRECTIONS OR COMMENTS MADE ON THE SHOP DRAWINGS DURING THIS REVIEW DO NOT RELIEVE CONTRACTOR FROM COMPLIANCE WITH REQUIREMENTS OF THE DRAWINGS AND DESIGN CONCEPT OF THE PROJECT AND GENERAL COMPLIANCE WITH THE INFORMATION GIVEN IN THE CONTRACT DOCUMENTS. THE CONTRACTOR IS RESPONSIBLE FOR CONFIRMING AND CORRELATING ALL QUANTITIES AND DIMENSIONS, SELECTING FABRICATION PROCESSES AND TECHNIQUES OF CONSTRUCTION, COORDINATING HIS WORK WITH THAT OF ALL OTHER TRADES, AND PERFORMING HIS WORK IN A SAFE AND SATISFACTORY MANNER.

VHB VanDaele Hangen Bruslin, Inc.
Engineers, Planners, and Scientists
Six Bedford Farms, Kilton Rd.
Bedford, NH 03110 603 564 0188

Job Number: 50811
Reviewed By: [Signature]
Date: 5-27-05

Wheeling Corrugating Company
Since 1890

CUSTOMER: CIANBRO
PROJECT: MISSISSOQUI BAY BRIDGE
LOCATION: VT 78 (PRINCIPAL ARTERIAL)
OWNER: COUNTIES OF GRAND ISLE AND FRANKLIN
STATE OF VERMONT AGENCY OF TRANSPORTATION
DATE CHECKED: 3/21/05
DATE DRAWN: 3/21/05
DRAWN BY: GLH
PROJECT # BR-05-27
PROJECT # BR-05-27
BRF 036 - 1 (1)

NO.	DATE	FOR
0/6	3/20	APPROVAL
E-0/6	4/21	APPROVAL
E	4/22	APPROVAL
E	5/13	APPROVAL

PRINTS ISSUED

SYMBOLS

1 A
0 - 0
SHEET LENGTH
DECK SYMBOL
LEGEND

B10
SHEET 10 OF 13

EACH SHEET MUST BE FASTENED TO SUPPORTS IMMEDIATELY UPON PLACEMENT TO AVOID HAZARD THAT COULD RESULT FROM HORIZONTAL MOVEMENT OR SUDDEN UPLIFT