



SEE SHEET B10 FOR CONTINUATION

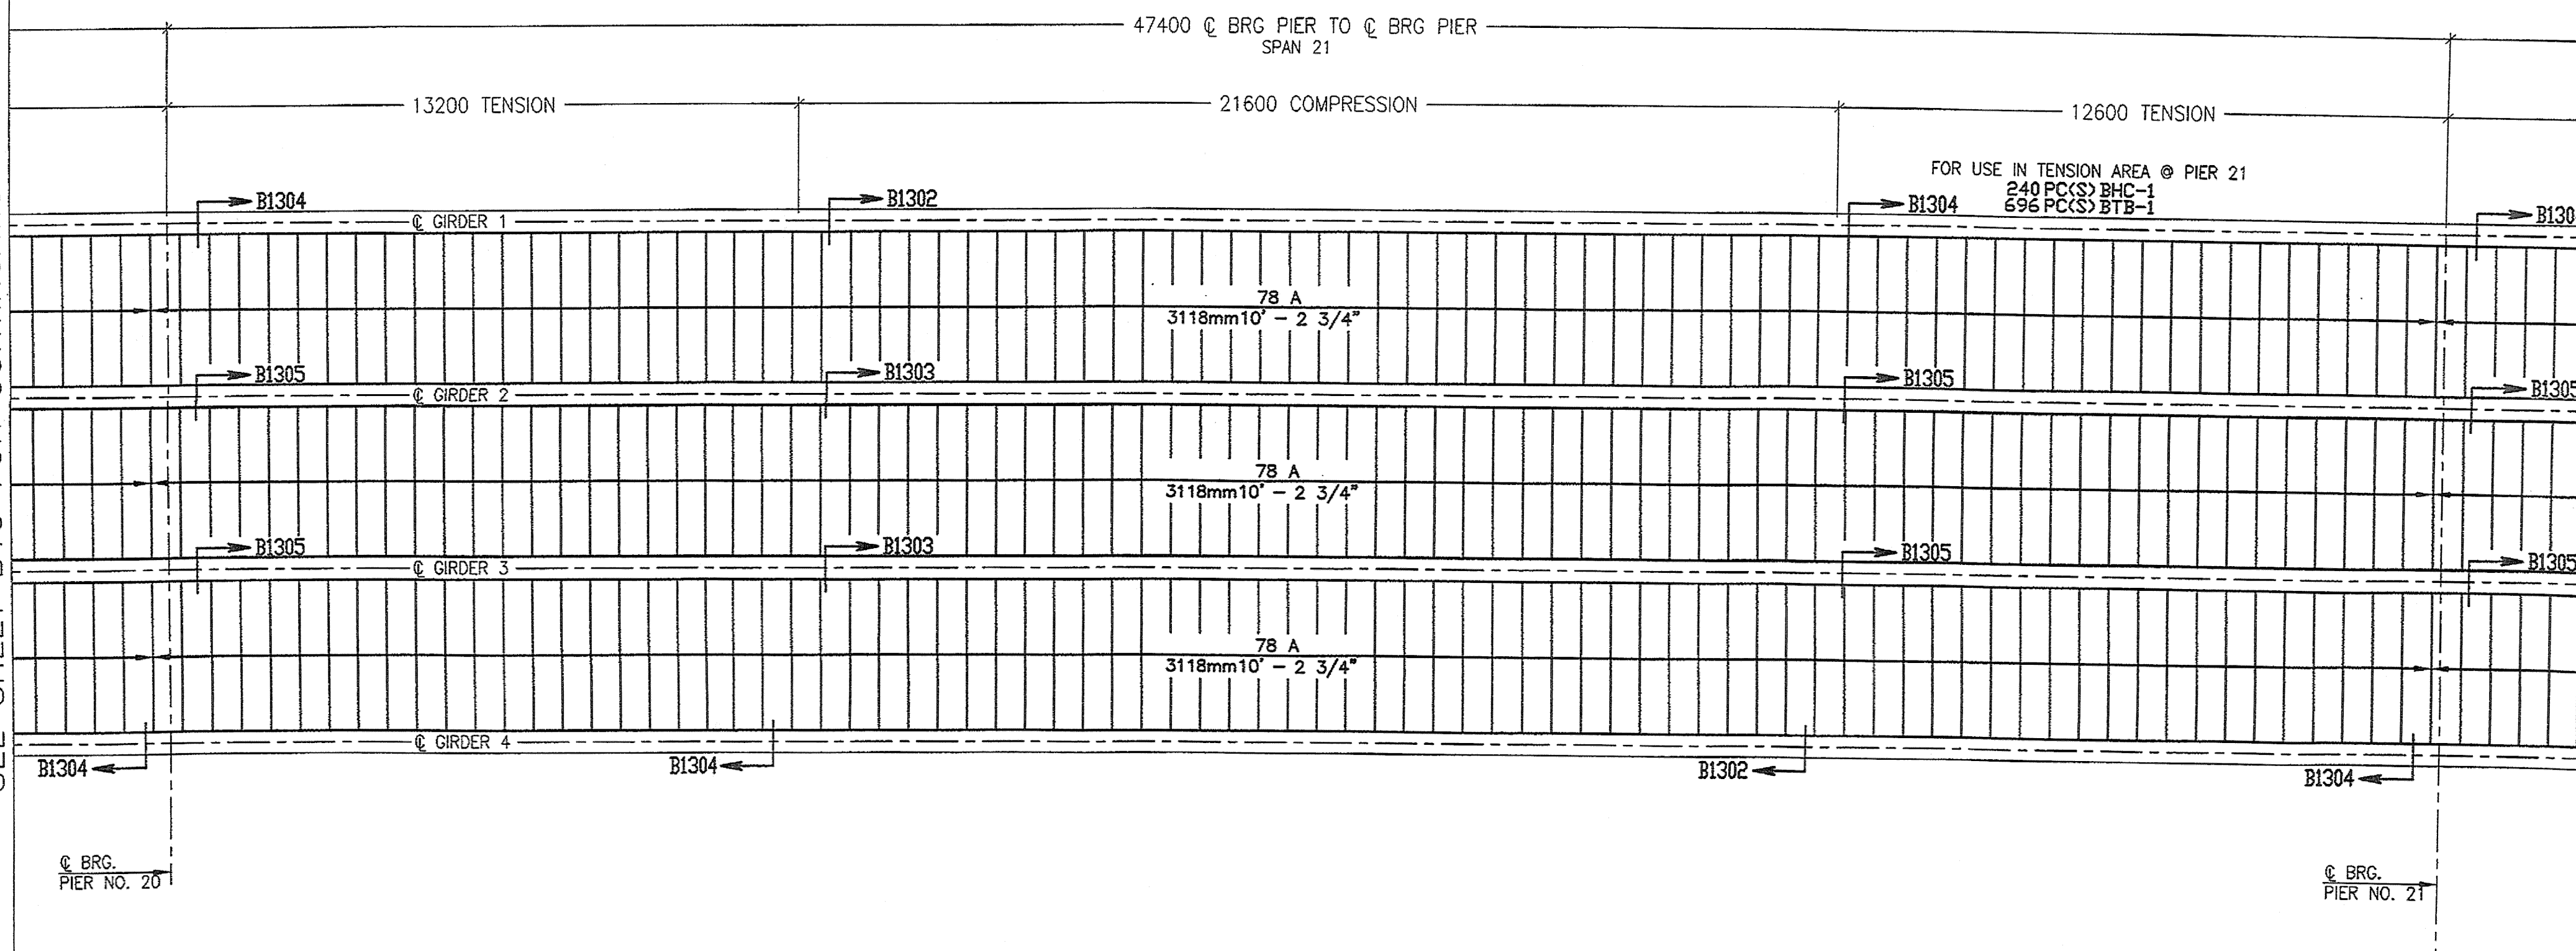

MATCHLINE

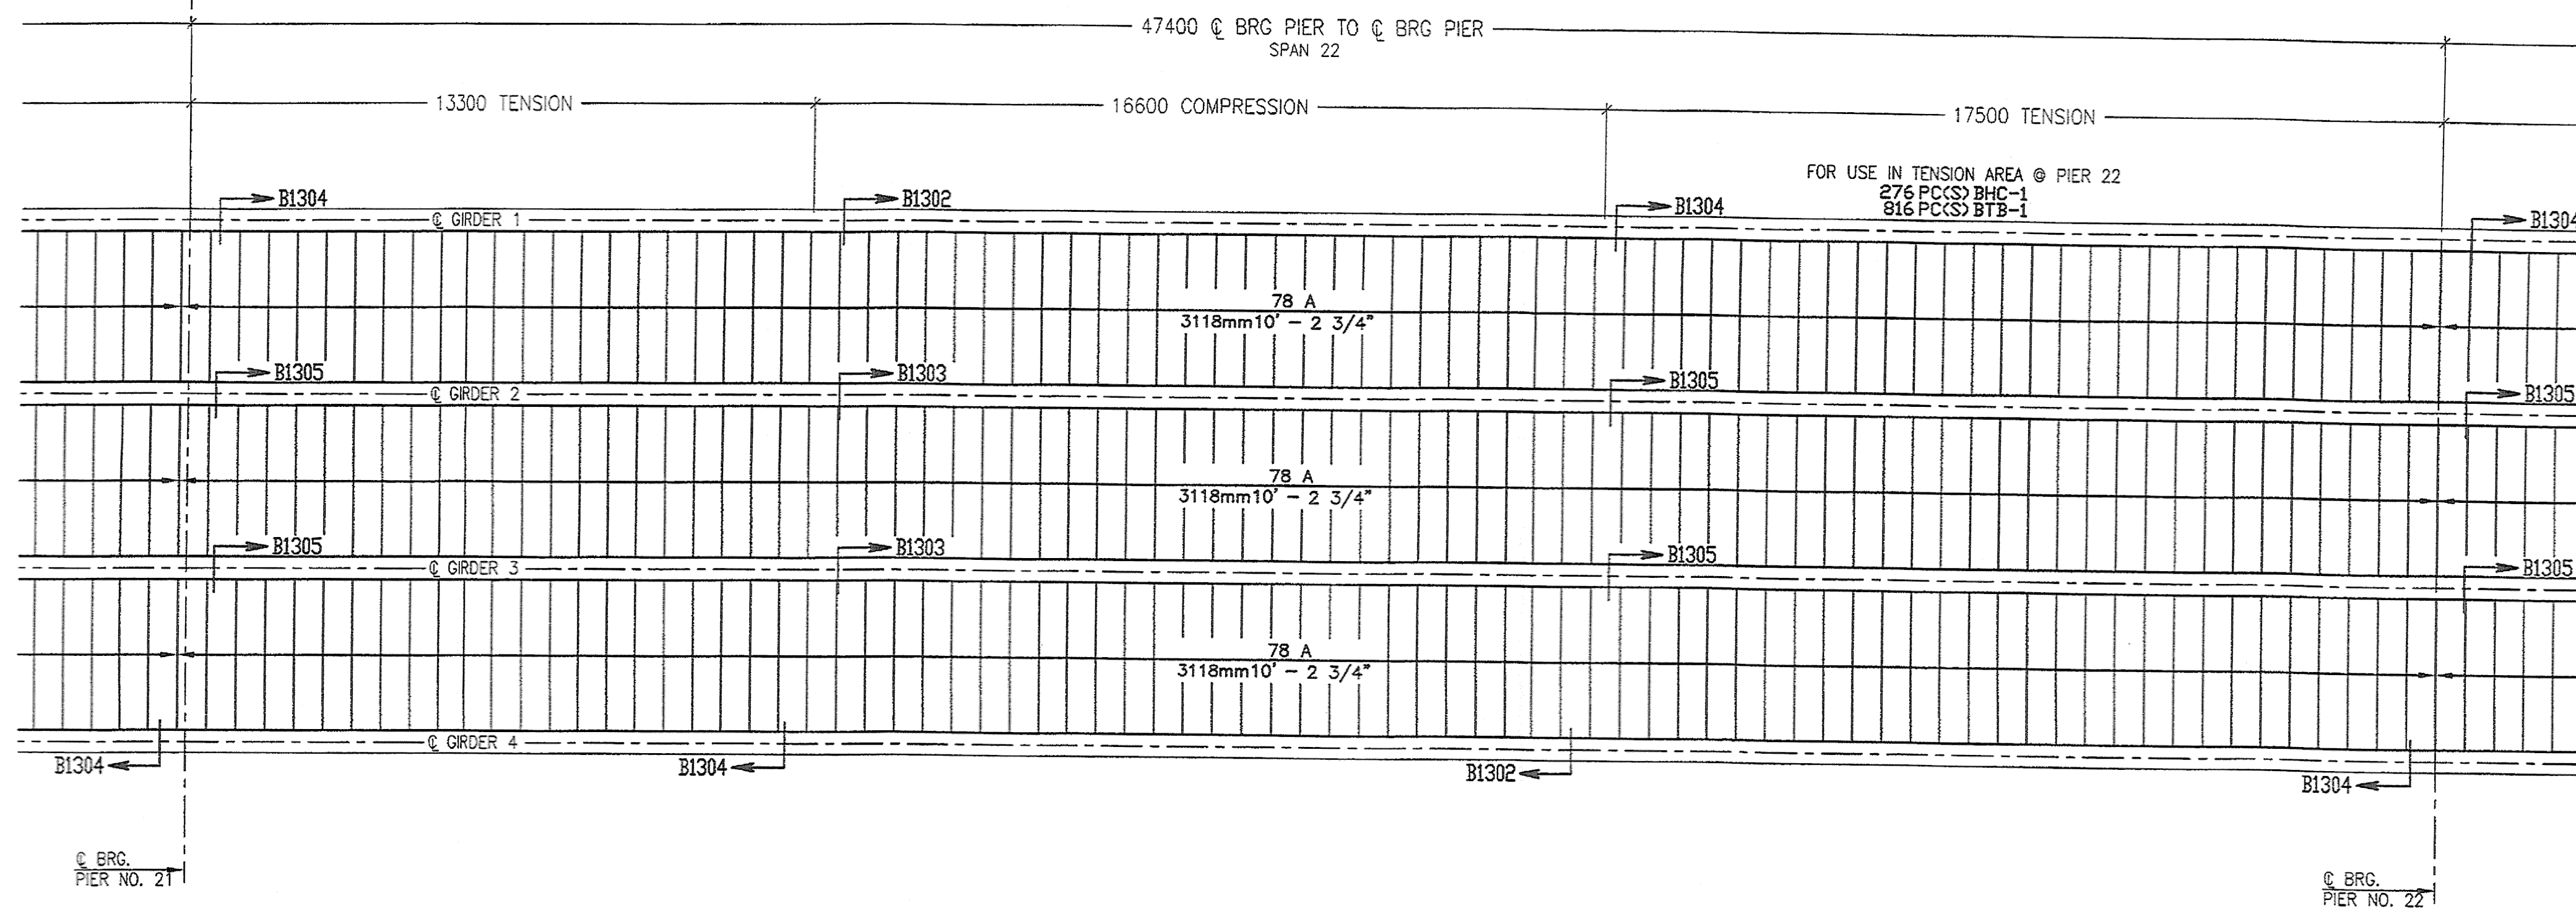

SEE SHEET B12 FOR CONTINUATION

**UNIT 3
BRIDGEFORM DECK PLAN
SPANS 21 & 22**

114mm (4 1/2") X 305mm (12") PITCH 19 GA GALV G165 (MARK A)
SCALE: 1:100

CONSTRUCTION SHOP DRAWING REVIEW

REVIEWED AS REQUIRED BY THE CONSTRUCTION CONTRACT DOCUMENTS AND APPROVED, BUT ONLY FOR COMPLIANCE TO THE DESIGN CONCEPT OF THE WORK, AND SUBJECT TO FURTHER LIMITATIONS AND REQUIREMENTS CONTAINED IN THE CONSTRUCTION CONTRACT DOCUMENTS.

REJECTED REVISE AND RESUBMIT FINISH AS CORRECTED

CORRECTIONS OR COMMENTS MADE ON THE SHOP DRAWINGS DURING THIS REVIEW DO NOT RELIEVE CONTRACTOR FROM COMPLIANCE WITH REQUIREMENTS OF THE DRAWINGS AND SPECIFICATIONS. THIS CHECK IS ONLY FOR REVIEW OF GENERAL COMPLIANCE WITH THE DESIGN CONCEPT OF THE PROJECT AND GENERAL COMPLIANCE WITH THE INFORMATION GIVEN IN THE CONTRACT DOCUMENTS. THE CONTRACTOR IS RESPONSIBLE FOR CONFIRMING AND CORRELATING ALL QUANTITIES AND DIMENSIONS; SELECTING FABRICATION PROCESSES AND TECHNIQUES OF CONSTRUCTION; COORDINATING HIS WORK WITH THAT OF ALL OTHER TRADES; AND PERFORMING HIS WORK IN A SAFE AND SATISFACTORY MANNER.

VHB Vansesky Hargrett Braslin, Inc.
Engineers, Planners, and Scientists
Six Redford Farms, Kilboon Rd.
Bedford, NH 03110 603 844 0898

Job Number: 50911
Reviewed By: *SMH*
Date: 5-27-05

Wheeling Corrugating Company
Since 1890
A DIVISION OF WHEELING METAL INDUSTRIES, CORP.
1150 WEST 1ST ST., WHEELING, WEST VIRGINIA 26061
TEL: 800-351-3333

CUSTOMER: CIAMBRO
MISSISSIPPI BAY BRIDGE
AT 78 (PRINCIPAL ARTERIAL)
OVER MISSISSIPPI RIVER, BRIDGE NO. 2
COUNTIES OF MISSISSIPPI AND FRANKLIN
STATE OF VERMONT
DATE CHECKED: 3/21/05
DATE OF TRAVEL: 3/28/05
PROJECT # BR 05-27-1 (1)

PROJECT: MISSISSIPPI BAY BRIDGE
LOCATION: MISSISSIPPI AND FRANKLIN COUNTIES
OWNER: VERMONT DEPARTMENT OF TRANSPORTATION
DRAWN: GLH
DATE: 3/21/05

PRINTS ISSUED

No.	DATE	FOR
0/6	3/29	APPROVAL
E-0/6	4/21	APPROVAL
E	4/22	APPROVAL
E	5/13	APPROVAL

SYMBOLS

- ~ ~ ~ ~ ~ = SEG. LINE
- ===== = AREA LINE
- ⊕ = SEG. MARK
- # = AREA MARK
- E.O.D. = END OF DECK
- E.O.S. = END OF SUB

NUMBER OF DECK SHEETS: 1 A
DECK SHEET LENGTH: 0 - 0
DECK SHEET WIDTH: 0 - 0

PROJECT # **BR-05-27**

B11

EACH SHEET MUST BE FASTENED TO SUPPORTS IMMEDIATELY UPON PLACEMENT TO AVOID HAZARD THAT COULD RESULT FROM HORIZONTAL MOVEMENT OR SUDDEN UPLIFT