


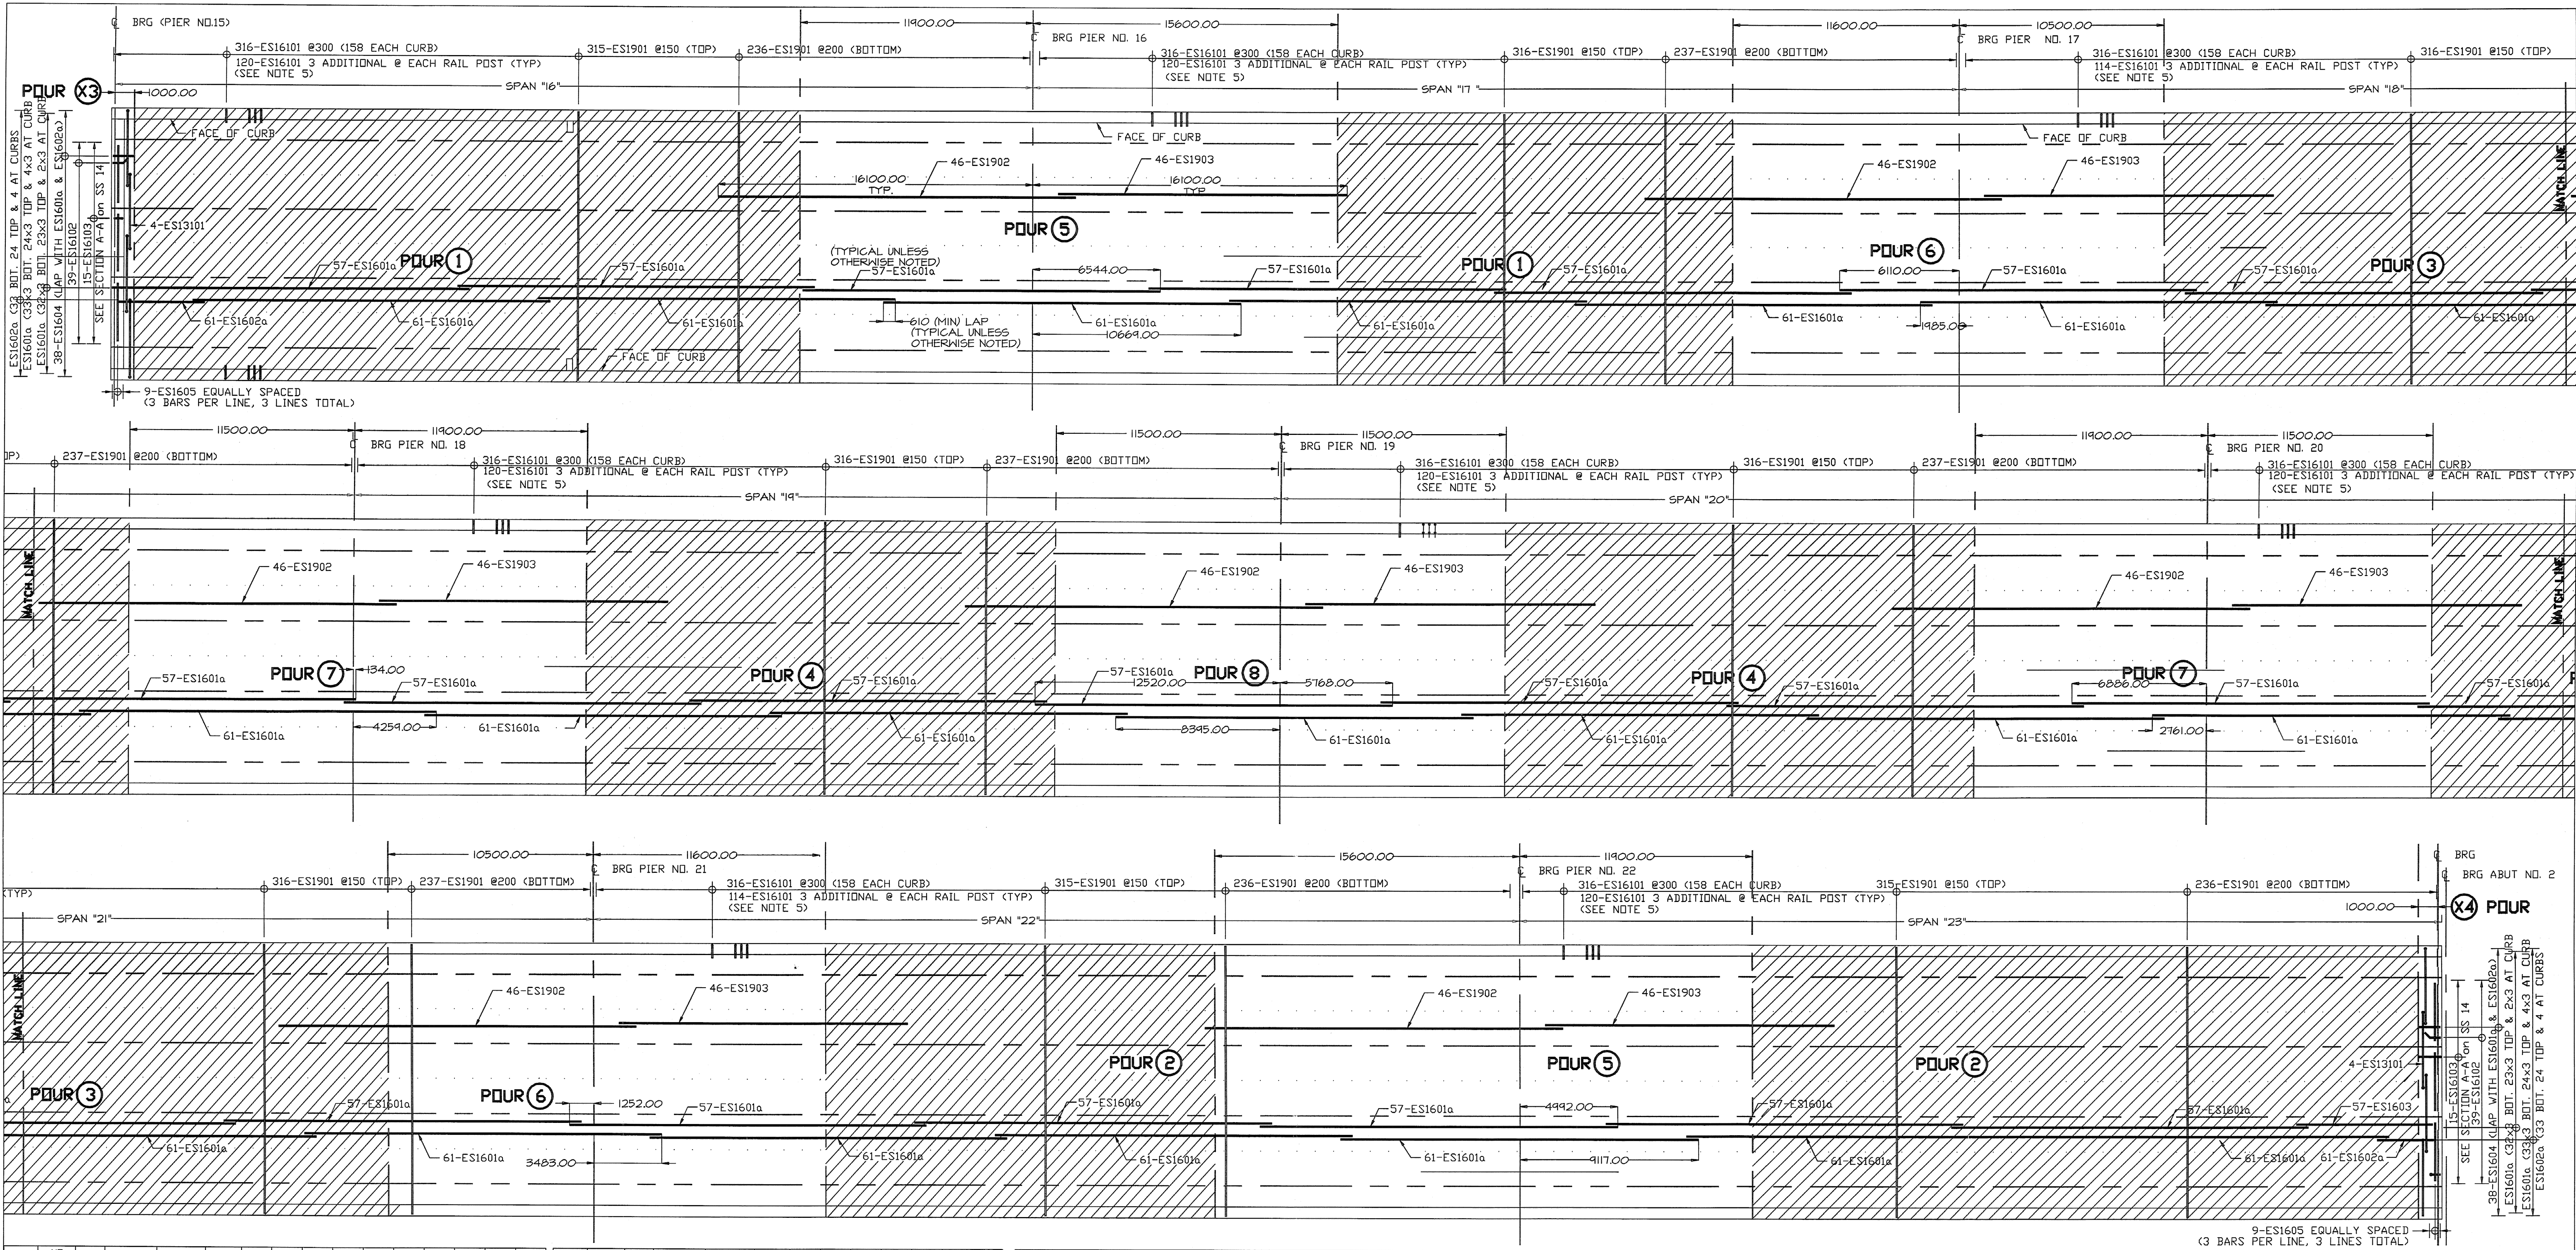

ITEM	NO PIECES	SIZE	LENGTH	MARK	TYPE	A	B	C	D	E	F	G	H	J	K
DECK - SPAN 16															
19															
20															
21	354	16	18 288	16ES1601a	STR										
22	61	16	4410	16ES1602a	STR										
23	38	16	1080	16ES1604	STR										
24	9	16	3000	16ES1605	STR										
25															
26	951	19	13 950	16ES1901	STR	▲									
27	47	19	14 833	16ES1902	STR										
28	46	19	18 288	16ES1903	STR										
29															
30	4	13	4310	16ES13101	17		205	3900	205						
31															
32	436	16	1760	16ES16101	S5	250	420	420	420			250			
33	39	16	910	16ES16102	19		360	550	0				255		255
34	15	16	1060	16ES16103	17		375	480	205						
35															
36															
DECK - SPAN 17															
37															
38															
39	354	16	18 288	17ES1601a	STR	▲									
40	8	16	1067	17ES1606	STR										
41															
42	554	19	13 950	17ES1701	STR	▲									
43	46	19	14 833	17ES1702	STR										
44	46	19	18 288	17ES1703	STR										
45															
46	436	16	1760	17ES16101	S5	250	420	420	420			250			
47															
48															