


TS102x102x6.4 x 12047

A6 ~ 6 REQ'D

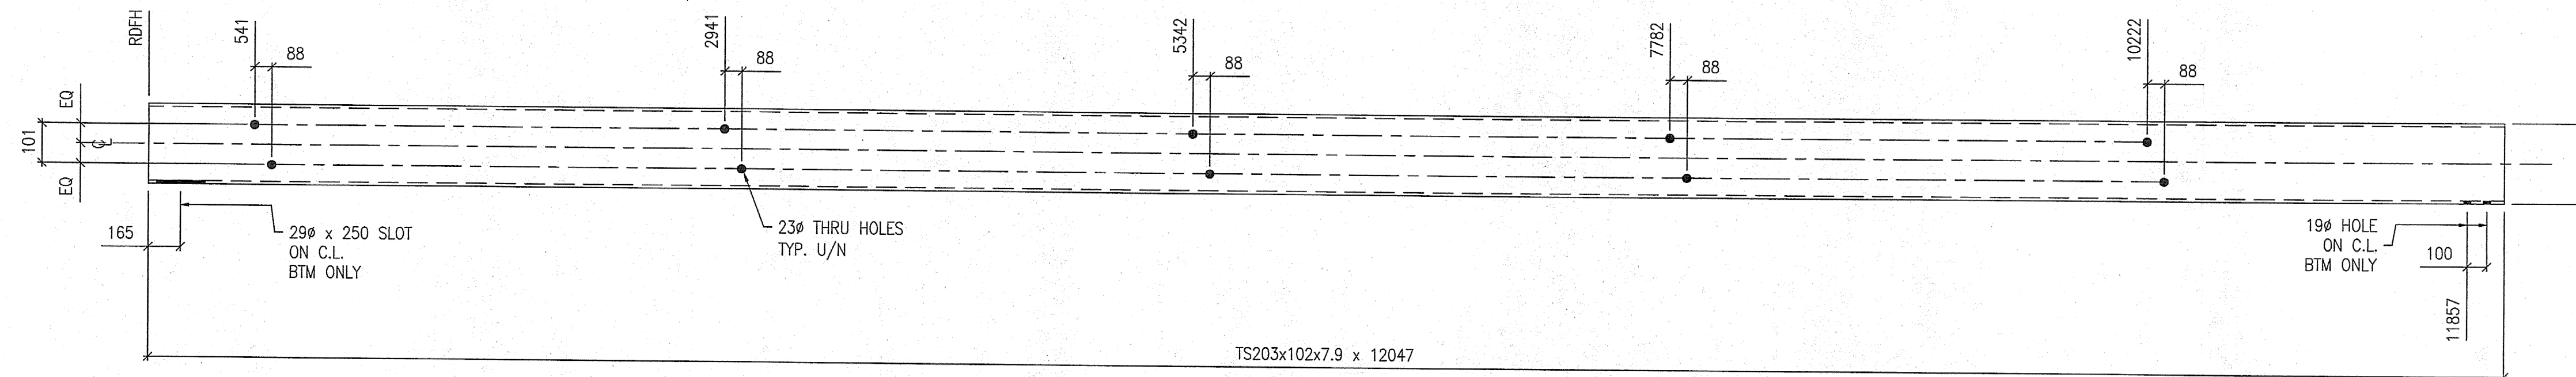

TS203x102x7.9 x 12047

B6 ~ 2 REQ'D

BILL OF MATERIAL					
MARK	QTY.	MATERIAL	LENGTH	GR.	REMARKS
A6	6	TS102x102x6.4	12047		GALV. HD
B6	2	TS203x102x7.9	12047		GALV. HD
TOTAL WEIGHT:					

FOR APPROVAL

SHOP DRAWING REVIEW

REVIEWED AS REQUIRED BY THE CONSTRUCTION CONTRACT DOCUMENTS AND APPROVED, BUT ONLY FOR CONFORMANCE TO THE DESIGN CONCEPT OF THE WORK, AND SUBJECT TO FURTHER LIMITATIONS AND REQUIREMENTS CONTAINED IN THE CONSTRUCTION CONTRACT DOCUMENTS.

REJECTED REVISE AND RESUBMIT FINISH AS CORRECTED

CORRECTIONS OR COMMENTS MADE ON THE SHOP DRAWINGS DURING THIS REVIEW DO NOT RELIEVE CONTRACTOR FROM COMPLIANCE WITH REQUIREMENTS OF THE DRAWINGS AND SPECIFICATIONS. THIS CHECK IS ONLY FOR REVIEW OF GENERAL CONFORMANCE WITH THE DESIGN CONCEPT OF THE PROJECT AND GENERAL COMPLIANCE WITH THE INFORMATION GIVEN IN THE CONTRACT DOCUMENTS. THE CONTRACTOR IS RESPONSIBLE FOR: CONFIRMING AND CORRELATING ALL QUANTITIES AND DIMENSIONS; SELECTING FABRICATION PROCESSES AND TECHNIQUES OF CONSTRUCTION; COORDINATING HIS WORK WITH THAT OF ALL OTHER TRADES; AND PERFORMING HIS WORK IN A SAFE AND SATISFACTORY MANNER.

VHB Venesse Hangen Brunell, Inc.
Engineers, Planners, and Scientists
Six Bedford Plaza, Kilton Rd.
Bedford, NH 03110 603.844.2528

Job Number: 50911
Reviewed By: *SMH*
Date: 7-7-05

NOTES:

- ALL PARTS TO BE GALVANIZED AFTER FABRICATION IN ACCORDANCE WITH AASHTO M 111M, EXCEPT THAT HARDWARE SHALL MEET THE REQUIREMENTS OF AASHTO M 232M.
- REFERENCE ERECTION DRAWING E24.

MAT'L : ASTM A500 GR.B		FIELD BOLTS		
HOLES : AS NOTED ON DWG.		GRADE: A325		
WELD :		*		
ELECTRODE : E70XX				
PREP : SEE GN-1				
PAINT : SEE GN-1				
REV.	DATE	BY	DESCRIPTION	CHK
1	11/01/05	JM	RE-ISSUED FOR APPROVAL	BH
0	09/06/04	JM	ISSUED FOR APPROVAL	BH
WORK NETC 4 RAIL-BRIDGE RAILING VT. ROUTE 78 OVER MISSISQUOI BAY ALBURG - SWANTON, VERMONT				
DRAWING BRIDGE RAILING DETAILS				
SCALE:	N.T.S.	SHEET 06 Δ		
DRAWN:	JM	CIANBRO CORPORATION PITTSFIELD MAINE		JOB 050004
CHECK:	BH			