


A7 ~ 150 REQ'D

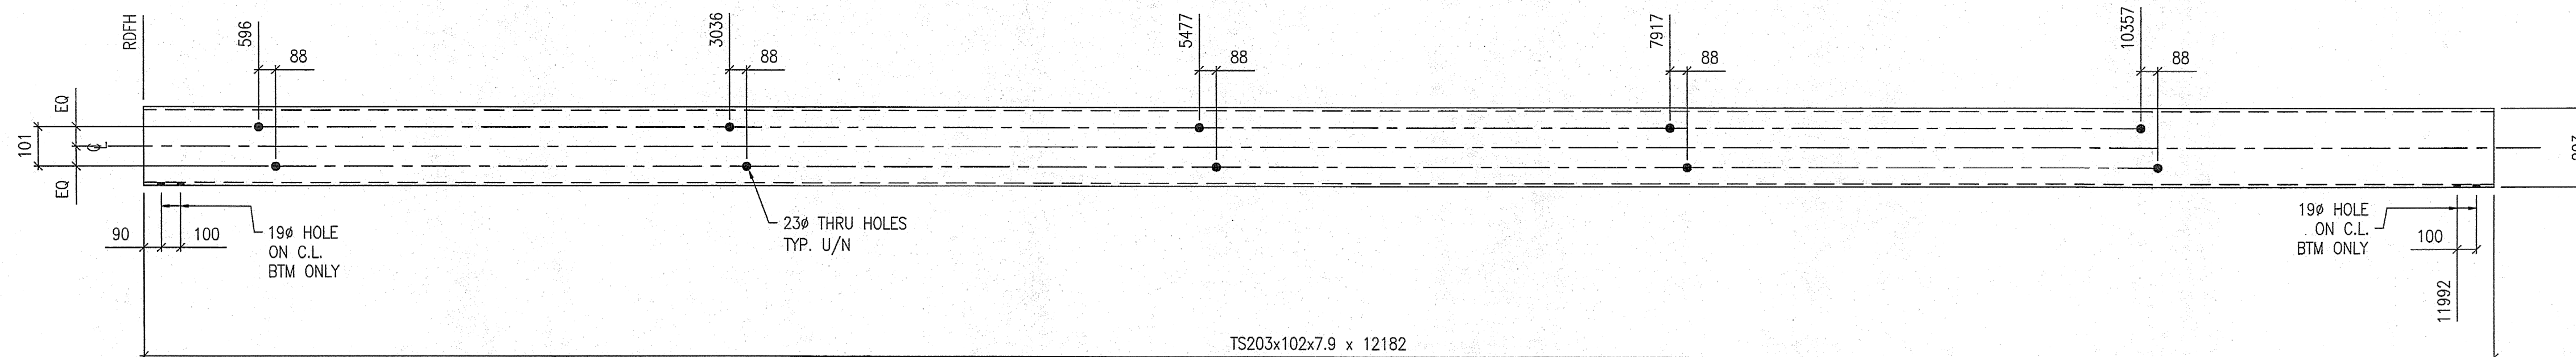

B7 ~ 50 REQ'D

BILL OF MATERIAL				
MARK	QTY.	MATERIAL	LENGTH	GR. REMARKS
SHIP	TEMP			
A7	150	TS102x102x6.4	12182	Galv. HD
B7	50	TS203x102x7.9	12182	Galv. HD
TOTAL WEIGHT:				

FOR APPROVAL

SHOP DRAWING REVIEW	
<input type="checkbox"/> REVIEWED AS REQUIRED BY THE CONSTRUCTION CONTRACT DOCUMENTS AND APPROVED, BUT ONLY FOR COMPLIANCE TO THE DESIGN CONCEPT OF THE WORK, AND SUBJECT TO FURTHER LIMITATIONS AND REQUIREMENTS CONTAINED IN THE CONSTRUCTION CONTRACT DOCUMENTS.	<input type="checkbox"/> FURNISH AS CORRECTED
<input type="checkbox"/> REJECTED	<input type="checkbox"/> REVISE AND RESUBMIT
CORRECTIONS OR COMMENTS MADE ON THE SHOP DRAWINGS DURING THIS REVIEW DO NOT RELIEVE CONTRACTOR FROM COMPLIANCE WITH REQUIREMENTS OF THE DRAWINGS AND SPECIFICATIONS. THIS CHECK IS ONLY FOR REVIEW OF GENERAL CONFORMANCE WITH THE DESIGN CONCEPT OF THE PROJECT AND GENERAL COMPLIANCE WITH THE INFORMATION GIVEN IN THE CONTRACT DOCUMENTS. THE CONTRACTOR IS RESPONSIBLE FOR: CONFIRMING AND CORRELATING ALL QUANTITIES AND DIMENSIONS; SELECTING FABRICATION PROCESSES AND TECHNIQUES OF CONSTRUCTION; COORDINATING HIS WORK WITH THAT OF ALL OTHER TRADES; AND PERFORMING HIS WORK IN A SAFE AND SATISFACTORY MANNER.	
VHB Vanessa Hengstenhusen, Inc. Engineers, Planners, and Scientists Six Bradford Farms, Kilton Rd. Bradford, NH 05110 603 644 0889	Job Number: 50911 Reviewed By: <i>[Signature]</i> Date: 7-7-05

NOTES:

1. ALL PARTS TO BE GALVANIZED AFTER FABRICATION IN ACCORDANCE WITH AASHTO M 111M, EXCEPT THAT HARDWARE SHALL MEET THE REQUIREMENTS OF AASHTO M 232M.
2. REFERENCE ERECTION DRAWING E24.

MATERIALS		FIELD BOLTS		
MAT'L : ASTM A500 GR.B		GRADE: A325		
HOLES : AS NOTED ON DWG.		*		
WELD :				
ELECTRODE : E70XX				
PREP : SEE GN-1				
PAINT : SEE GN-1				
REV.	DATE	BY	DESCRIPTION	CHK
1	11/01/05	JM	RE-ISSUED FOR APPROVAL	BH
0	09/06/04	JM	ISSUED FOR APPROVAL	BH
WORK NETC 4 RAIL-BRIDGE RAILING VT. ROUTE 78 OVER MISSISQUOI BAY ALBURG - SWANTON, VERMONT				
DRAWING BRIDGE RAILING DETAILS				
SCALE: N.T.S.	CIANBRO CORPORATION PITTSFIELD MAINE		SHEET 07	JOB 050004
DRAWN: JM				
CHECK: BH				