



BILL OF MATERIAL				
MARK	QTY.	MATERIAL	LENGTH	GR. REMARKS
A8	6	TS102x102x6.4	14412	GALV. HD
B8	2	TS203x102x7.9	14412	GALV. HD
TOTAL WEIGHT:				

FOR APPROVAL

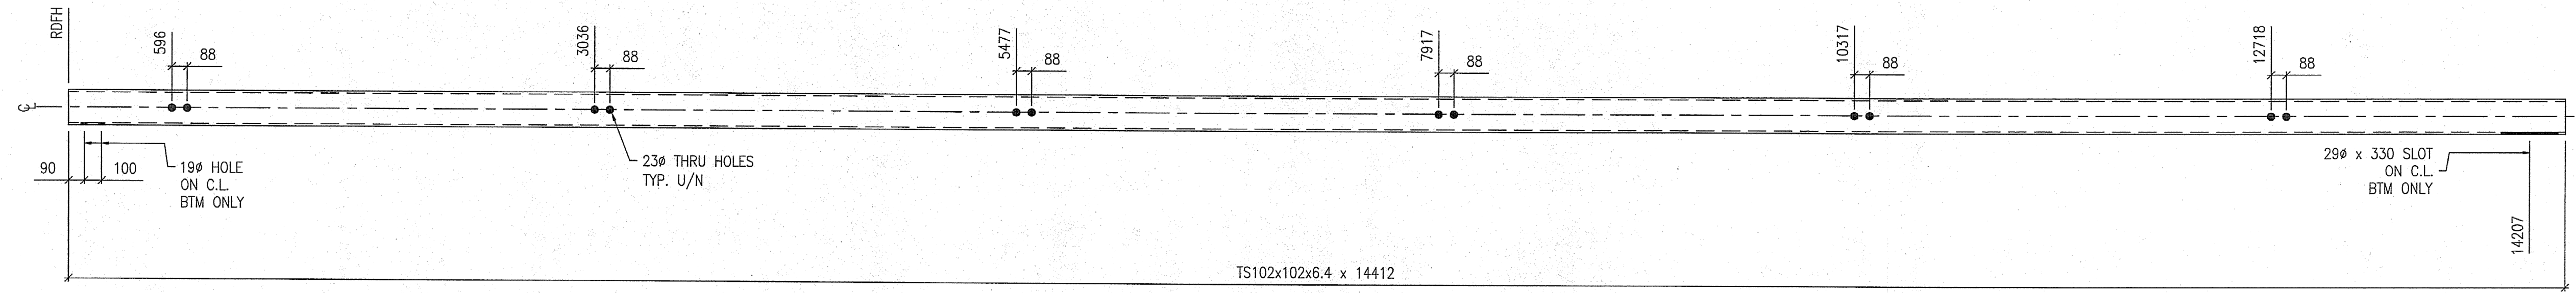

A8 ~ 6 REQ'D

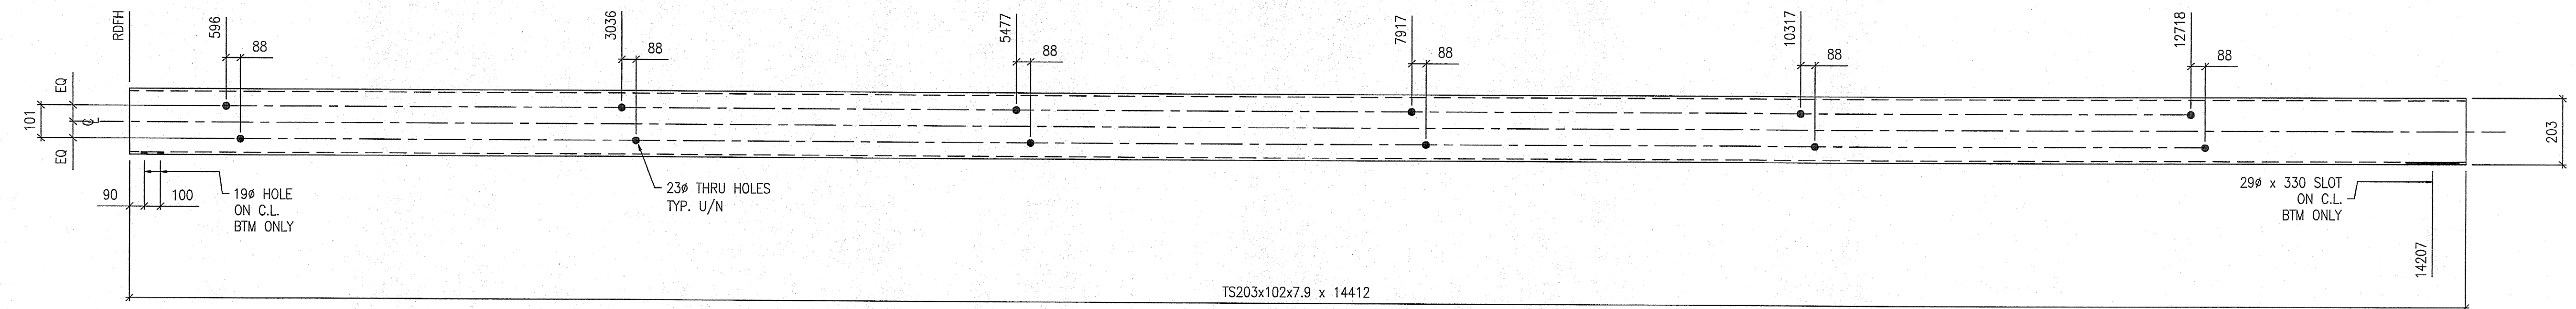

B8 ~ 2 REQ'D

SHOP DRAWING REVIEW	
<input type="checkbox"/> REVIEWED AS REQUIRED BY THE CONSTRUCTION CONTRACT DOCUMENTS AND APPROVED, BUT ONLY FOR CONFORMANCE TO THE DESIGN CONCEPT OF THE WORK AND SUBJECT TO FURTHER LIMITATIONS AND REQUIREMENTS CONTAINED IN THE CONSTRUCTION CONTRACT DOCUMENTS.	<input type="checkbox"/> REVISE AND RESUBMIT
<input type="checkbox"/> REJECTED	<input checked="" type="checkbox"/> FURNISH AS CORRECTED
CORRECTIONS OR COMMENTS MADE ON THE SHOP DRAWINGS DURING THIS REVIEW DO NOT RELIEVE CONTRACTOR FROM COMPLIANCE WITH REQUIREMENTS OF THE DRAWINGS AND SPECIFICATIONS. THIS CHECK IS ONLY FOR REVIEW OF GENERAL CONFORMANCE WITH THE DESIGN CONCEPT OF THE PROJECT AND GENERAL COMPLIANCE WITH THE INFORMATION GIVEN IN THE CONTRACT DOCUMENTS. THE CONTRACTOR IS RESPONSIBLE FOR CONFIRMING AND CORRELATING ALL QUANTITIES AND DIMENSIONS, SELECTING FABRICATION PROCESSES AND TECHNIQUES OF CONSTRUCTION, COORDINATING HIS WORK WITH THAT OF ALL OTHER TRADES, AND PERFORMING HIS WORK IN A SAFE AND SATISFACTORY MANNER.	
VHB Vanasse Hangen Brustlin, Inc. Engineers, Planners, and Scientists Six Bedford Farms, Kittery, Inc. Bedford, NH 03811 603 664 0889	Job Number: 50811 Reviewed By: [Signature] Date: 7-7-05

- NOTES:
- ALL PARTS TO BE GALVANIZED AFTER FABRICATION IN ACCORDANCE WITH AASHTO M 111M, EXCEPT THAT HARDWARE SHALL MEET THE REQUIREMENTS OF AASHTO M 232M.
 - REFERENCE ERECTION DRAWINGS E24 AND E25.

MAT'L : ASTM A500 GR.B	FIELD BOLTS
HOLES : AS NOTED ON DWG.	GRADE: A325
WELD :	
ELECTRODE : E70XX	
PREP : SEE GN-1	
PAINT : SEE GN-1	

REV.	DATE	BY	DESCRIPTION	CHK
1	11/01/05	JM	RE-ISSUED FOR APPROVAL	BH
0	09/06/04	JM	ISSUED FOR APPROVAL	BH

WORK NETC 4 RAIL-BRIDGE RAILING
VT. ROUTE 78 OVER MISSISQUOI BAY
ALBURG - SWANTON, VERMONT

DRAWING BRIDGE RAILING DETAILS

SCALE: N.T.S.	CIANBRO CORPORATION PITTSFIELD MAINE	SHEET 08
DRAWN: JM		JOB 050004
CHECK: BH		