


A10 ~ 348 REQ'D

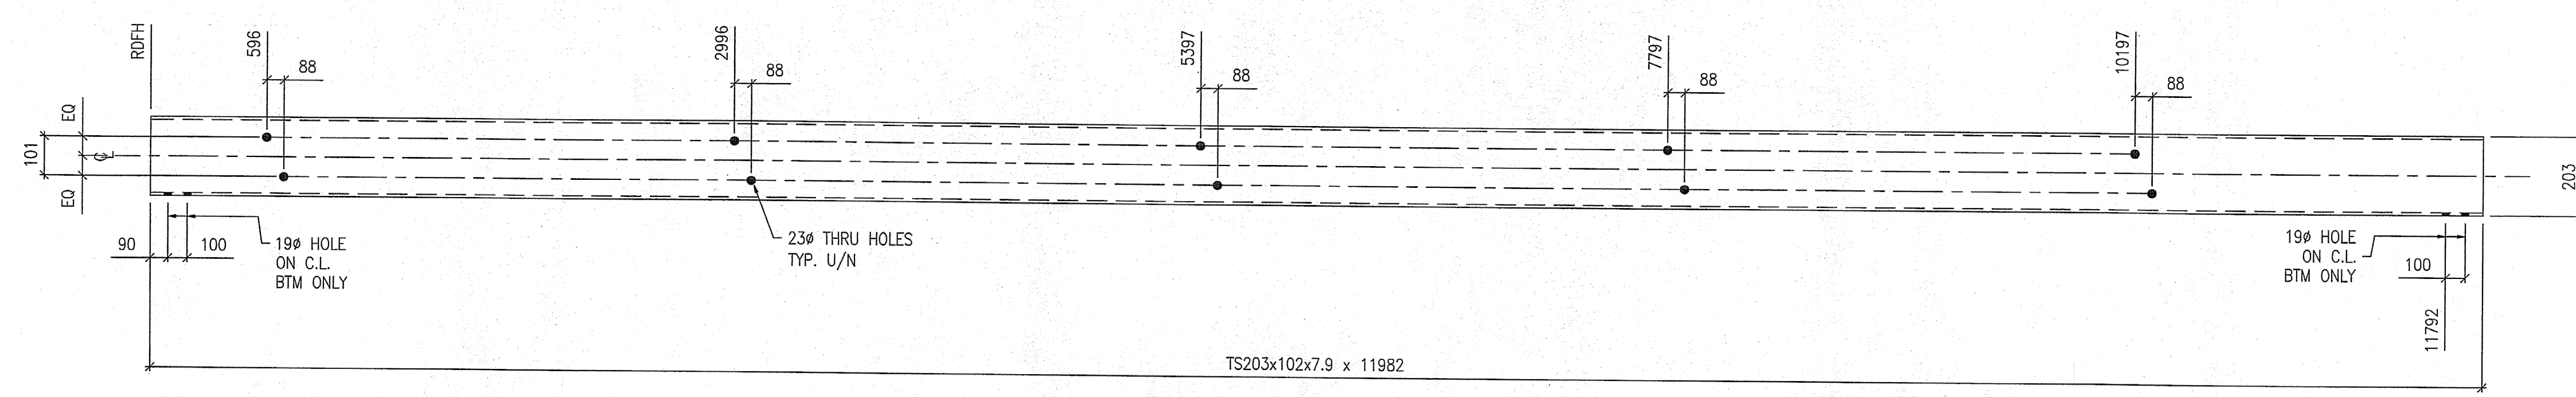

B10 ~ 116 REQ'D

BILL OF MATERIAL					
MARK	QTY.	MATERIAL	LENGTH	GR.	REMARKS
A10	348	TS102x102x6.4	11982		GLV. HD
B10	116	TS203x102x7.9	11982		GLV. HD
TOTAL WEIGHT:					

FOR APPROVAL

SHOP DRAWING REVIEW			
<input type="checkbox"/> REVIEWED AS REQUIRED BY THE CONSTRUCTION CONTRACT DOCUMENTS AND APPROVED, BUT ONLY FOR CONFORMANCE TO THE DESIGN CONCEPT OF THE WORK, AND SUBJECT TO FURTHER LIMITATIONS AND REQUIREMENTS COVERED IN THE CONSTRUCTION CONTRACT DOCUMENTS.	<input type="checkbox"/> REJECTED	<input type="checkbox"/> REVISE AND RESUBMIT	<input checked="" type="checkbox"/> FINISH AS CORRECTED
CORRECTIONS OR COMMENTS MADE ON THE SHOP DRAWINGS DURING THIS REVIEW DO NOT RELIEVE CONTRACTOR FROM COMPLIANCE WITH REQUIREMENTS OF THE DRAWINGS AND SPECIFICATIONS. THIS CHECK IS ONLY FOR REVIEW OF GENERAL CONFORMANCE WITH THE DESIGN CONCEPT OF THE PROJECT AND GENERAL COMPLIANCE WITH THE INFORMATION GIVEN IN THE CONTRACT DOCUMENTS. THE CONTRACTOR IS RESPONSIBLE FOR CONFIRMING AND CORRELATING ALL QUANTITIES AND DIMENSIONS, SELECTING FABRICATION PROCESSES AND TECHNIQUES OF CONSTRUCTION, COORDINATING HIS WORK WITH THAT OF ALL OTHER TRADES, AND PERFORMING HIS WORK IN A SAFE AND SATISFACTORY MANNER.			
VHB Vanesse Hangen Brunstin, Inc. Engineers, Planners, and Scientists Six Bedford Farms, Milton Rd. Bedford, NH 03110 603-661-5888		Job Number: 50111	Reviewed By: [Signature]
		Date: 7-2-05	

- NOTES:
- ALL PARTS TO BE GALVANIZED AFTER FABRICATION IN ACCORDANCE WITH AASHTO M 111M, EXCEPT THAT HARDWARE SHALL MEET THE REQUIREMENTS OF AASHTO M 232M.
 - REFERENCE ERECTION DRAWINGS E25 AND E26.

MAT'L : ASTM A500 GR.B		FIELD BOLTS	
HOLES : AS NOTED ON DWG.		GRADE: A325	
WELD :			
ELECTRODE : E70XX			
PREP : SEE GN-1			
PAINT : SEE GN-1			
REV.	DATE	BY	DESCRIPTION
1	11/01/05	JM	RE-ISSUED FOR APPROVAL
0	09/06/04	JM	ISSUED FOR APPROVAL
			CHK
WORK		NETC 4 RAIL-BRIDGE RAILING VT. ROUTE 78 OVER MISSISQUOI BAY ALBURG - SWANTON, VERMONT	
DRAWING		BRIDGE RAILING DETAILS	
SCALE:	N.T.S.	SHEET	10
DRAWN:	JM	CORPORATION	050004
CHECK:	BH	PITTSFIELD MAINE	