


BILL OF MATERIAL					
MARK	QTY.	MATERIAL	LENGTH	GR.	REMARKS
A14	6	TS102x102x6.4	5921		GRV. HD
B14	2	TS203x102x7.9	5921		GRV. HD
TOTAL WEIGHT:					

FOR APPROVAL

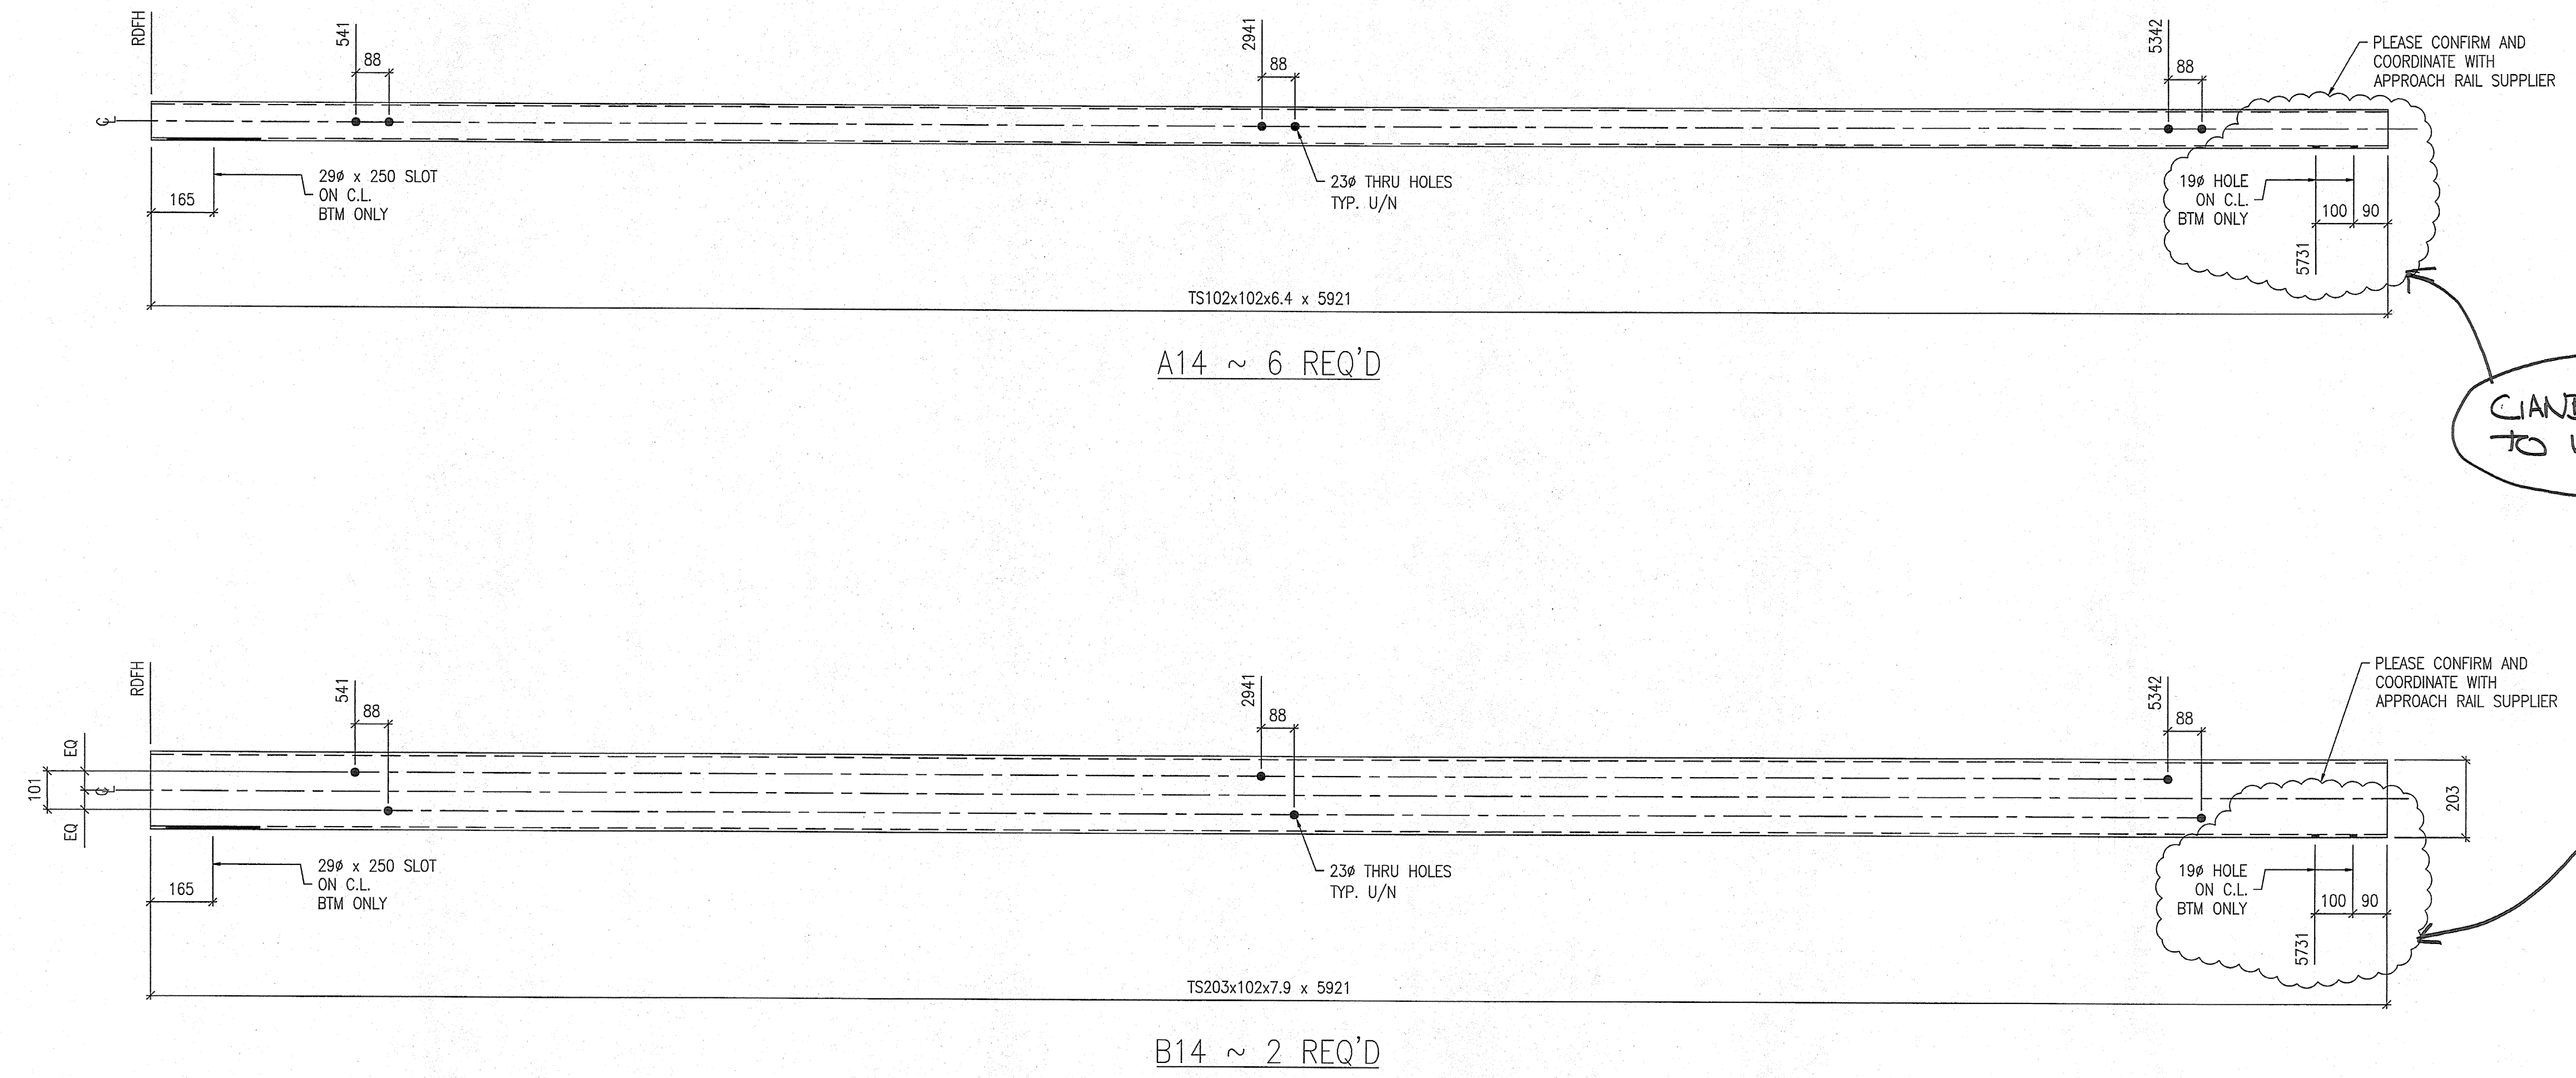

SEE E26 FOR APPROVAL OF BRIDGE RAILING

SHOP DRAWING REVIEW	
<input type="checkbox"/> REVIEWED AS REQUIRED BY THE CONSTRUCTION CONTRACT DOCUMENTS AND APPROVED, BUT ONLY FOR COMPLIANCE TO THE DESIGN CONCEPT OF THE WORK, AND SUBJECT TO FURTHER LIMITATIONS AND REQUIREMENTS CONTAINED IN THE CONSTRUCTION CONTRACT DOCUMENTS.	<input type="checkbox"/> FURNISH AS CORRECTED
<input type="checkbox"/> REJECTED	<input type="checkbox"/> REVISE AND RESUBMIT
CORRECTIONS OR COMMENTS MADE ON THE SHOP DRAWINGS DURING THIS REVIEW DO NOT RELIEVE CONTRACTOR FROM COMPLIANCE WITH REQUIREMENTS OF THE DRAWINGS AND SPECIFICATIONS. THIS CHECK IS ONLY FOR REVIEW OF GENERAL COMPLIANCE WITH THE DESIGN CONCEPT OF THE PROJECT AND GENERAL COMPLIANCE WITH THE INFORMATION GIVEN IN THE CONTRACT DOCUMENTS. THE CONTRACTOR IS RESPONSIBLE FOR: CONFIRMING AND CORRELATING ALL QUANTITIES AND DIMENSIONS; SELECTING FABRICATION PROCESSES AND TECHNIQUES OF CONSTRUCTION; COORDINATING HIS WORK WITH THAT OF ALL OTHER TRADES; AND PERFORMING HIS WORK IN A SAFE AND SATISFACTORY MANNER.	
VHB Vanessa Hanger Bristol, Inc. Engineers, Planners, and Scientists Six Bedford Farms, Kilton Rd. Bedford, NH 03110 603 644 0885	Job Number: 50511 Reviewed By: <i>[Signature]</i> Date: 7-7-05

- NOTES:
- ALL PARTS TO BE GALVANIZED AFTER FABRICATION IN ACCORDANCE WITH AASHTO M 111M, EXCEPT THAT HARDWARE SHALL MEET THE REQUIREMENTS OF AASHTO M 232M.
 - REFERENCE ERECTION DRAWINGS E26.

MAT'L : ASTM A500 GR.B	FIELD BOLTS
HOLES : AS NOTED ON DWG.	GRADE: A325
WELD :	*
ELECTRODE : E70XX	
PREP : SEE GN-1	
PAINT : SEE GN-1	
1 11/01/05 JM RE-ISSUED FOR APPROVAL	BH
0 18/06/04 JM ISSUED FOR APPROVAL	BH
REV. DATE BY DESCRIPTION	CHK
WORK	NETC 4 RAIL-BRIDGE RAILING VT. ROUTE 78 OVER MISSISQUOI BAY ALBURG - SWANTON, VERMONT
DRAWING	BRIDGE RAILING DETAILS
SCALE: N.T.S.	SHEET 14 Δ
DRAWN: JM	CIANBRO CORPORATION PITTSFIELD MAINE
CHECK: BH	JOB 050004