




FOR APPROVAL

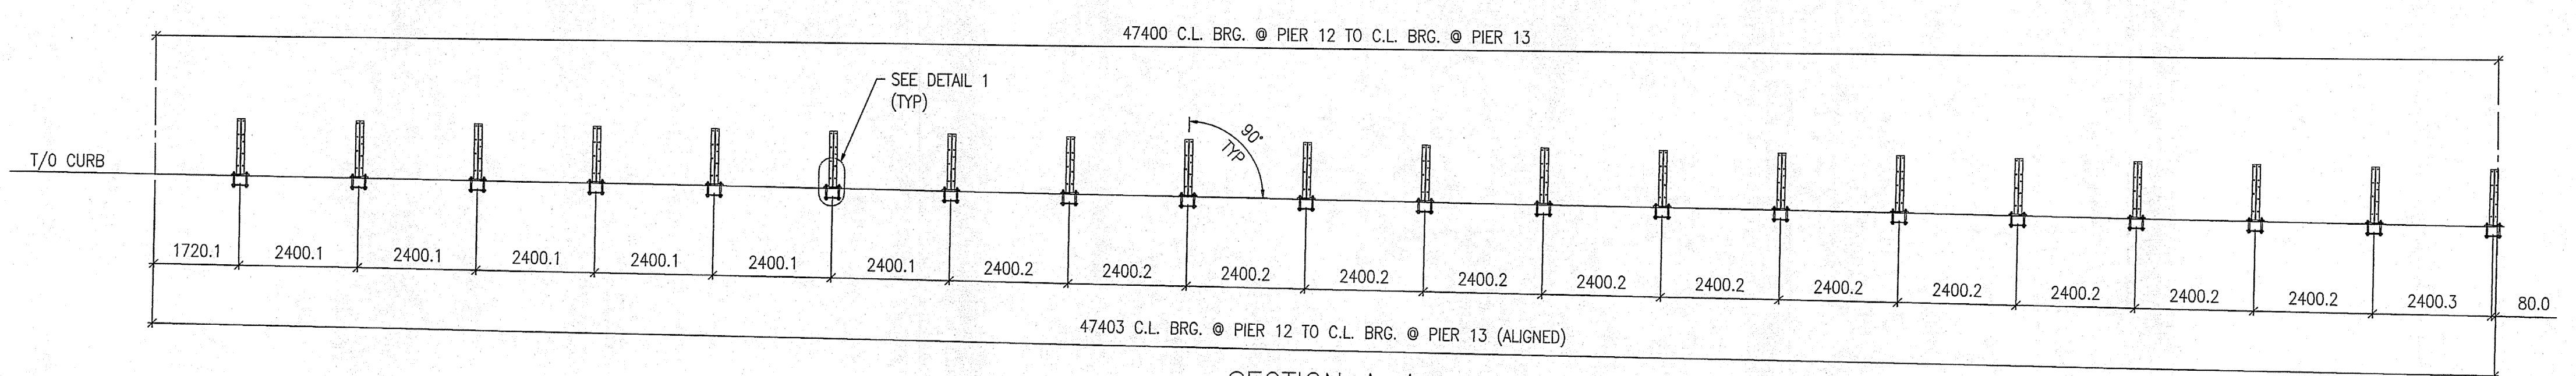


SECTION A-A
VIEW A'-A' (SIM)

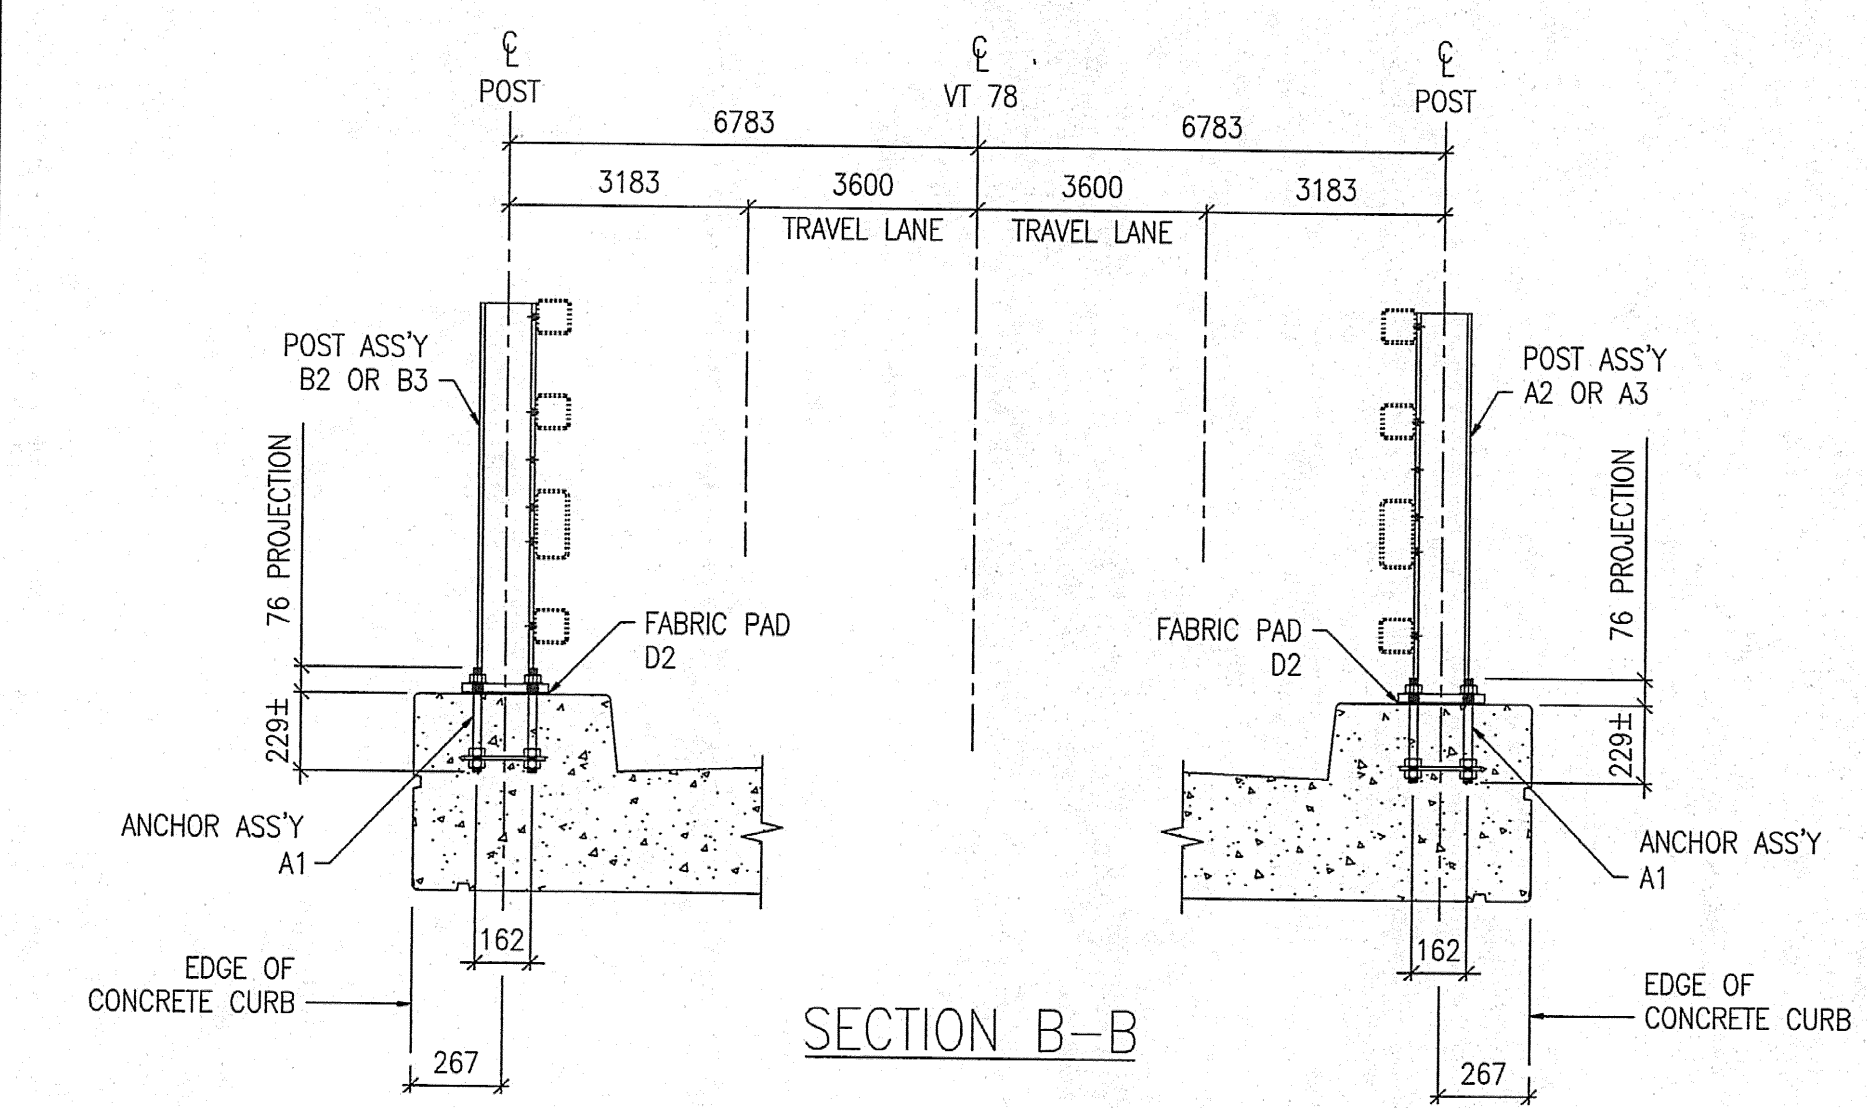

SECTION B-B

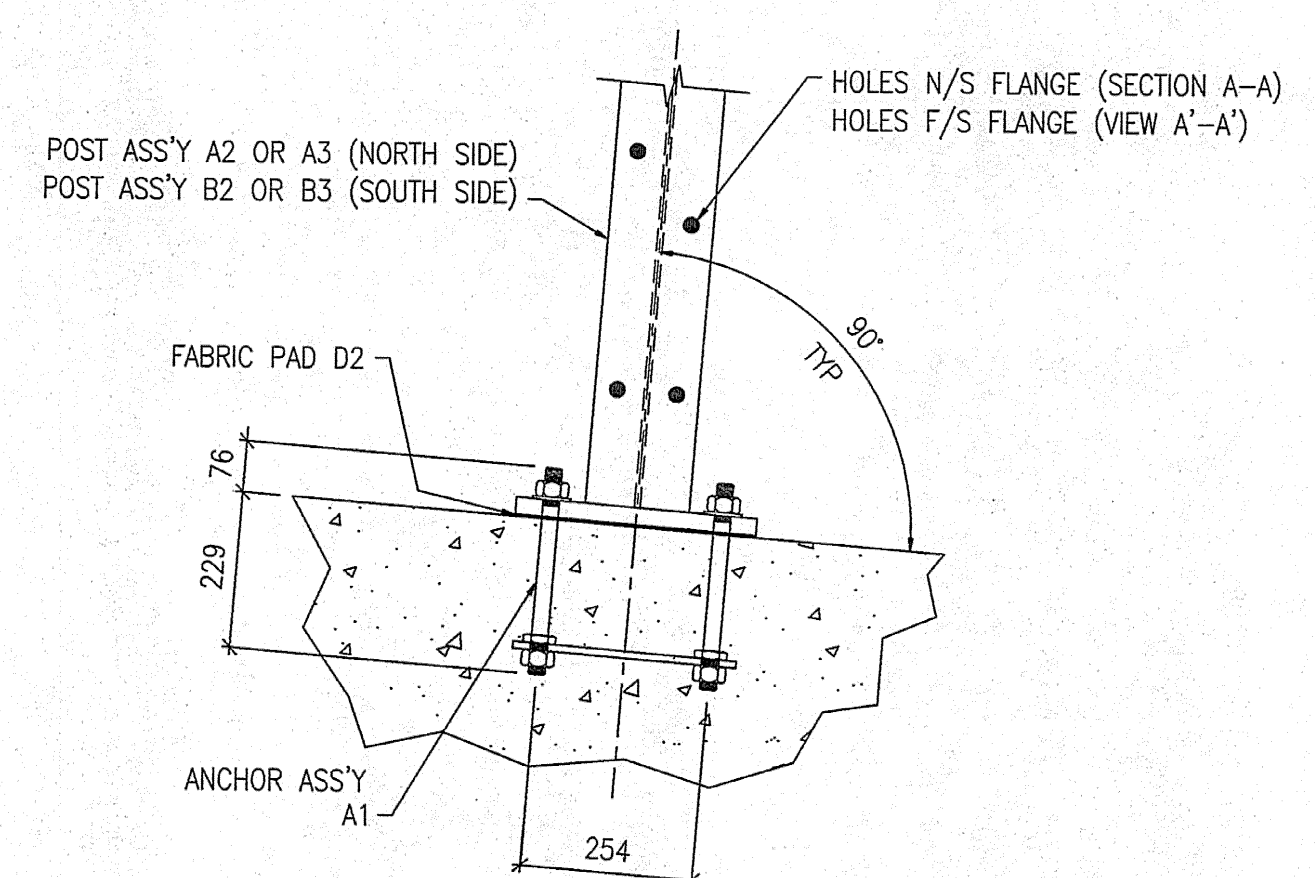

DETAIL 1

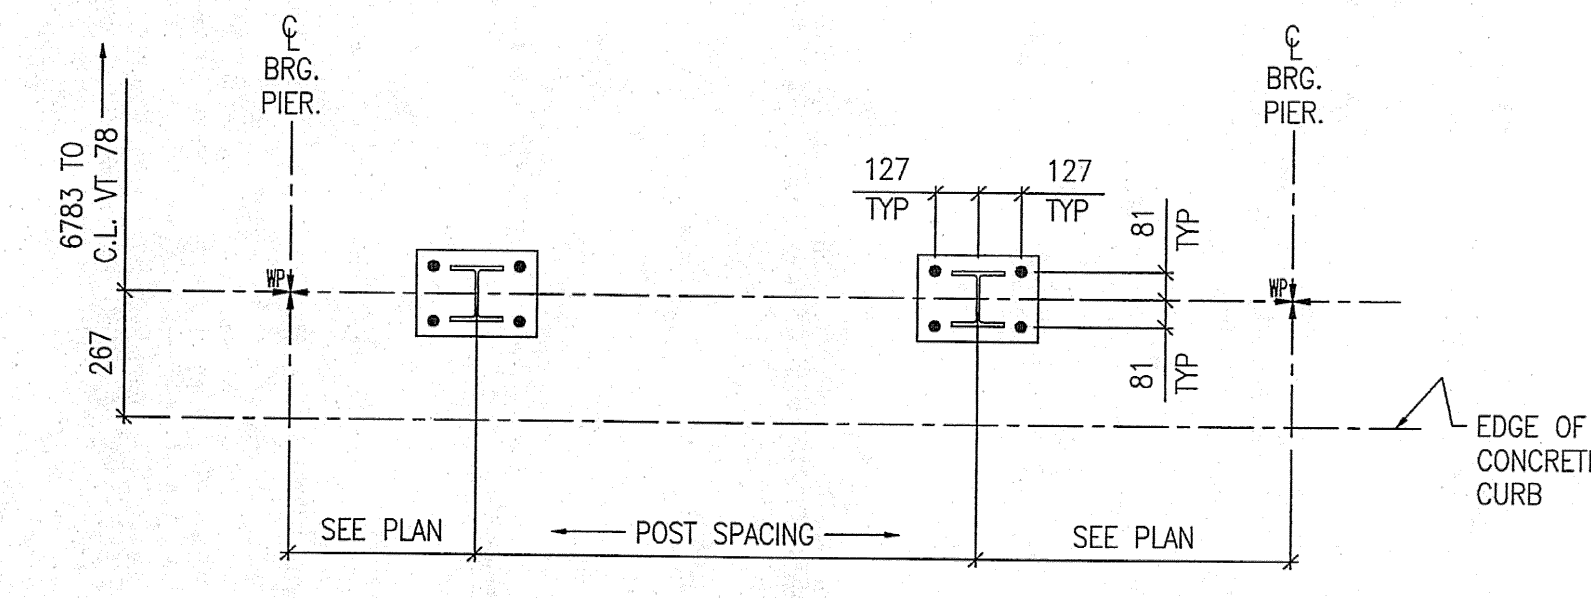

TYPICAL RAILING POST LAYOUT

SHOP DRAWING REVIEW

REVIEWED AS REQUIRED BY THE CONSTRUCTION CONTRACT DOCUMENTS AND APPROVED ONLY FOR CONFORMANCE TO THE DESIGN CONCEPT OF THE WORK AND SUBJECT TO THE LIMITATIONS AND REQUIREMENTS CONTAINED IN THE CONSTRUCTION CONTRACT DOCUMENTS.

REJECTED REVISE AND REQUIRY FINISH AS CORRECTED

CORRECTIONS OR COMMENTS MADE ON THE SHOP DRAWINGS DURING THIS REVIEW OF THE DRAWINGS SHALL BE THE RESPONSIBILITY OF THE CONTRACTOR. THE CONTRACTOR IS RESPONSIBLE FOR CORRECTING ALL QUANTITIES AND DIMENSIONS; COORDINATING HIS WORK WITH THAT OF ALL OTHER TRADES AND PERFORMING HIS WORK IN A SAFE AND SATISFACTORY MANNER.

VHB Vanessa Hengen Brustin, Inc.
Engineers, Planners, and Scientists
Six Bedford Farms, Milton Rd.
Bedford, NH 03110 603 644 0388

Job Number: 5511
Reviewed By: SMH
Date: 7-7-05

- NOTES:**
- FOR BRIDGE RAILING ERECTION PLAN SEE DRAWING E25.
 - ALL RAIL POST ASSEMBLIES TO BE ERECTED WITH FLANGE HOLES FACING CENTER OF BRIDGE.

MAT'L : SEE GN-1		FIELD BOLTS		
HOLES : 22Ø (7/8") U.N.O.		GRADE: A325		
WELD :				
ELECTRODE : E70XX				
PREP : SEE GN-1				
PAINT : SEE GN-1				
1	11/01/05	JM	RE-ISSUED FOR APPROVAL	BH
0	09/06/04	JM	ISSUED FOR APPROVAL	BH
REV.	DATE	BY	DESCRIPTION	CHK
WORK				
NETC 4 RAIL-BRIDGE RAILING				
VT. ROUTE 78 OVER MISSISQUOI BAY				
ALBURG - SWANTON, VERMONT				
DRAWING				
RAIL POST ANCHOR PLAN - SPAN 13				
SCALE:	N.T.S.	SHEET		E13 Δ
DRAWN:	JM	JOB		050004
CHECK:	BH			