


APPROACH RAIL ELEVATION
 (NORTH EAST RAIL SHOWN, SOUTH WEST RAIL SIMILAR)
 (SOUTH EAST RAIL AND NORTH WEST RAIL OPPOSITE HAND)

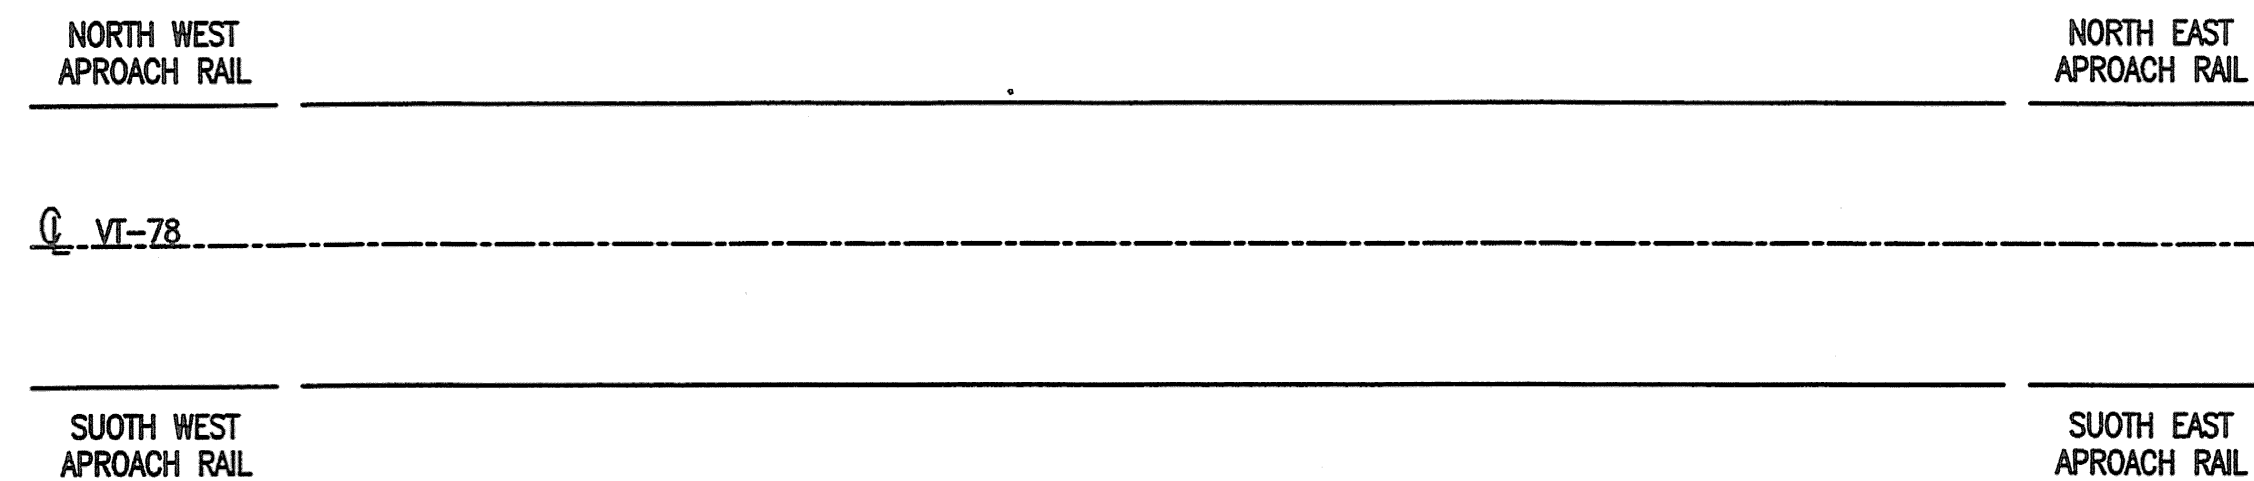

KEY PLAN

SHOP DRAWING REVIEW	
<input type="checkbox"/> REVIEWED AS REQUIRED BY THE CONSTRUCTION CONTRACT DOCUMENTS AND APPROVED, BUT ONLY FOR CONFORMANCE TO THE DESIGN CONCEPT OF THE WORK, AND SUBJECT TO FURTHER LIMITATIONS AND REQUIREMENTS CONTAINED IN THE CONSTRUCTION CONTRACT DOCUMENTS.	<input type="checkbox"/> FURNISH AS CORRECTED
<input type="checkbox"/> REJECTED	<input type="checkbox"/> REVISE AND RESUBMIT
CORRECTIONS OR COMMENTS MADE ON THE SHOP DRAWINGS DURING THIS REVIEW DO NOT RELIEVE CONTRACTOR FROM COMPLIANCE WITH REQUIREMENTS OF THE DRAWINGS AND SPECIFICATIONS. THIS CHECK IS ONLY FOR REVIEW OF GENERAL CONFORMANCE WITH THE DESIGN CONCEPT OF THE PROJECT AND GENERAL COMPLIANCE WITH THE INFORMATION GIVEN IN THE CONTRACT DOCUMENTS. THE CONTRACTOR IS RESPONSIBLE FOR CONFIRMING AND CORRELATING ALL QUANTITIES AND DIMENSIONS; SELECTING FABRICATION PROCESSES AND TECHNIQUES OF CONSTRUCTION; COORDINATING HIS WORK WITH THAT OF ALL OTHER TRADES; AND PERFORMING HIS WORK IN A SAFE AND SATISFACTORY MANNER.	
VHB Versasse Hengen Bruslin, Inc. Engineers, Planners, and Scientists 50 Bedford Plaza, Keene, NH Bedford, NH 03110 603 644 0889	Job Number: 50911 Reviewed By: SMJ Date: 8-15-06

MAT'L : SEE GN-1	FIELD BOLTS
HOLES :	GRADE: A325
WELD :	
ELECTRODE : E70XX	
PREP : SEE GN-1	
PAINT : SEE GN-1	

REV.	DATE	BY	DESCRIPTION	CHK
3	07/15/06	TS	REV. PER APP.	RC
2	08/03/06	MN	REV. PER CIANBRO RFI 008 AND APP.	RC
1	28/10/05	KC	REV. PER APPROVAL COMMENTS	BH

WORK NETC 4 RAIL-APPROACH RAILING-PROJECT NO. BRFO36-1(1)
 VT. ROUTE 78 OVER MISSISQUOI BAY - BRIDGE NO. 2
 ALBURG - SWANTON, VERMONT

DRAWING APPROACH RAIL LAYOUT

SCALE: N.T.S.	CIANBRO CORPORATION PITTSFIELD MAINE	SHEET E27
SUPERVISOR: T.S.		JOB 050004
DRAWN: SG		
CHECK: BH		

NOTES:

1. WORK THIS DRAWING WITH E24, E25 AND E26.