

TYPICAL SECTIONS


- 3" BITUMINOUS CONCRETE PAVEMENT, 1 1/4" III OVER 1 3/4" II (TWO LIFTS)
- 5" PLANT MIXED BASE COURSE, ITEM 303.25 (TO BE PLACED IN TWO COURSES)
- 24" SUBBASE OF GRAVEL, ITEM 301.15
- 1-1/4" SHOULDERS : BITUMINOUS CONCRETE PAVEMENT ITEM 406.25
- 0'-24" SAND BORROW (IN CUT) ITEM 203.31] TO BE PLACED AS NOTED ON THE PLANS
- 0'-12" GRANULAR BORROW (IN FILL) ITEM 203.32] OR AS DIRECTED BY THE ENGINEER

GENERAL NOTES


| SEED, ITEM 651.10 TO BE APPLIED AS DIRECTED BY THE ENGINEER | | | |
|--|-------|------------------------------------|------------|
| %WT | LBS/A | NAME | PUR% GERM% |
| 3.33 | 2 | CROWNING VETCH | 97 75 |
| 90.00 | 30 | CREeping RED FESCUE | 98 85 |
| 8.33 | 5 | TIMOTHY | 99 85 |
| 16.67 | 10 | PERENNIAL RYE GRASS (VAR. PENNINE) | 95 85 |
| 8.34 | 5 | ALFALFA (VAR. SARANAC) | 99 85 |
| 8.33 | 5 | BIRDFOOT TREFOIL (VAR. EMPIRE) | 98 85 |
| 5.00 | 3 | HIGHLAND BENT GRASS | 92 85 |
| 100.00 | 60 | LBS/ACRE | |

THE SEED MIXTURE SHALL NOT HAVE A WEED CONTENT EXCEEDING 0.40% BY WEIGHT AND SHALL BE FREE OF ALL NOXIOUS WEED SEED


- MARKER POSTS, (WOOD OR STEEL AS SPECIFIED) TO BE PLACED AS DIRECTED BY THE ENGINEER
 - FERTILIZER, ITEM 651.15
FORMULA 10-20-10 TO BE USED WITH SEED, ITEM 651.15 APPLIED AT THE RATE OF 500 LBS/ACRE
 - AGRICULTURAL LIMESTONE, ITEM 651.20 TO BE APPLIED AT RATE OF 2 TONS/ACRE OR AS DIRECTED BY THE ENGINEER
 - HAY MULCH, ITEM 651.25 TO BE PLACED ON EARTH SLOPES AT THE RATE OF 2 TONS/ACRE
 - TOPSOIL, ITEM 653.10 TO BE USED WITH SEED, ITEM 651.10 IN RESIDENTIAL AREAS, AS DIRECTED BY THE ENGINEER
 - SEE STANDARD SHEET B-5 FOR TYPICAL SLOPE ROUNDING
 - SEE STANDARD SHEET D-2 FOR PAY LIMITS OF SAND BORROW WHEN USED IN CONJUNCTION WITH UNDERDRAIN
 - ALLOWABLE THICKNESS TOLERANCES
- | | |
|---------------------|--------|
| SUB-BASE | ± 1" |
| CONTROLLED MATERIAL | ± 1" |
| PAVEMENT | ± 1/4" |
| BASE COURSE | ± 1/2" |

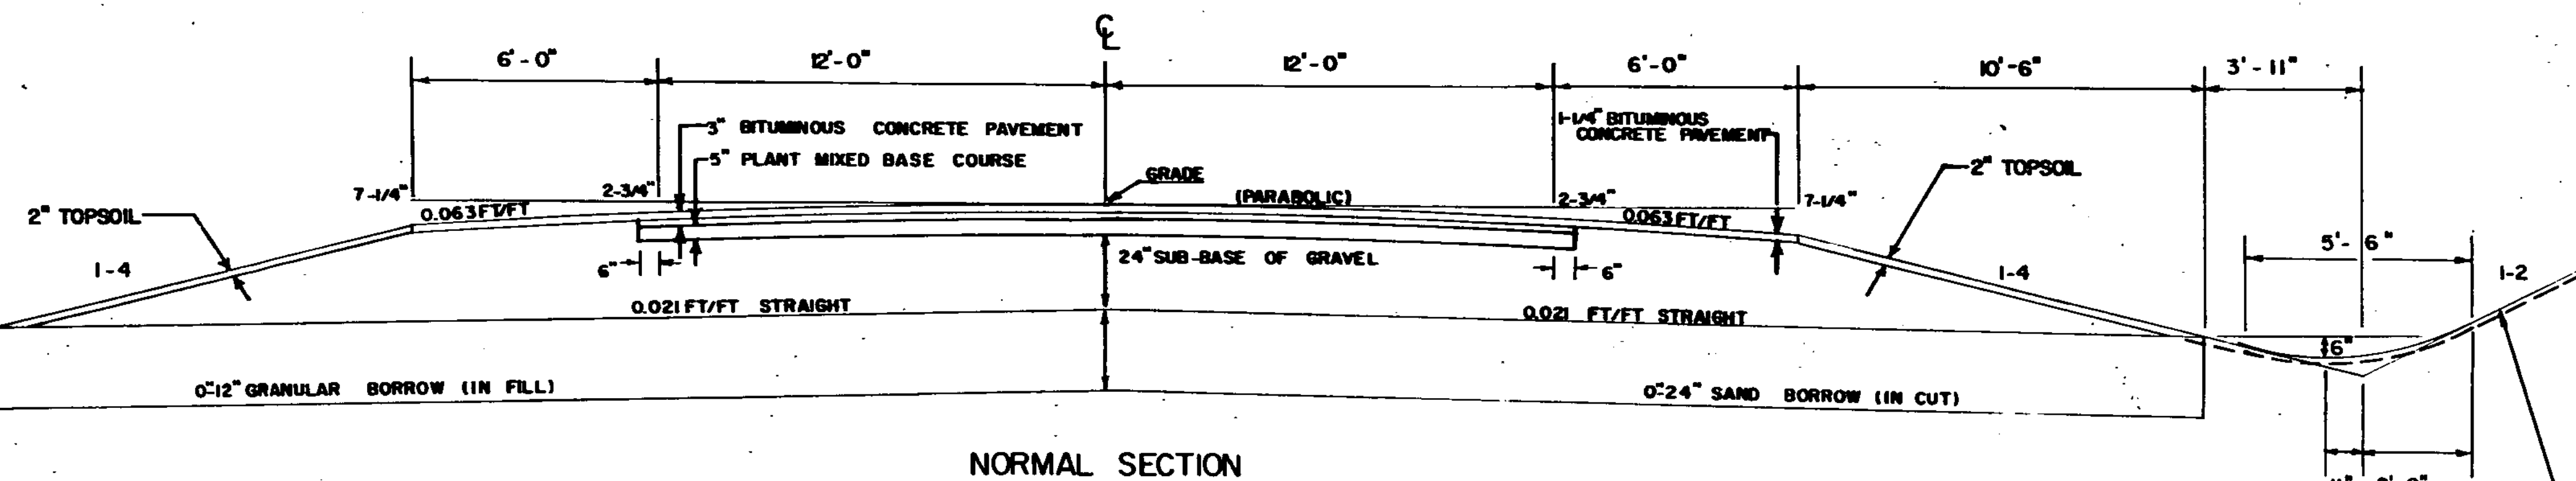


NORMAL SECTION

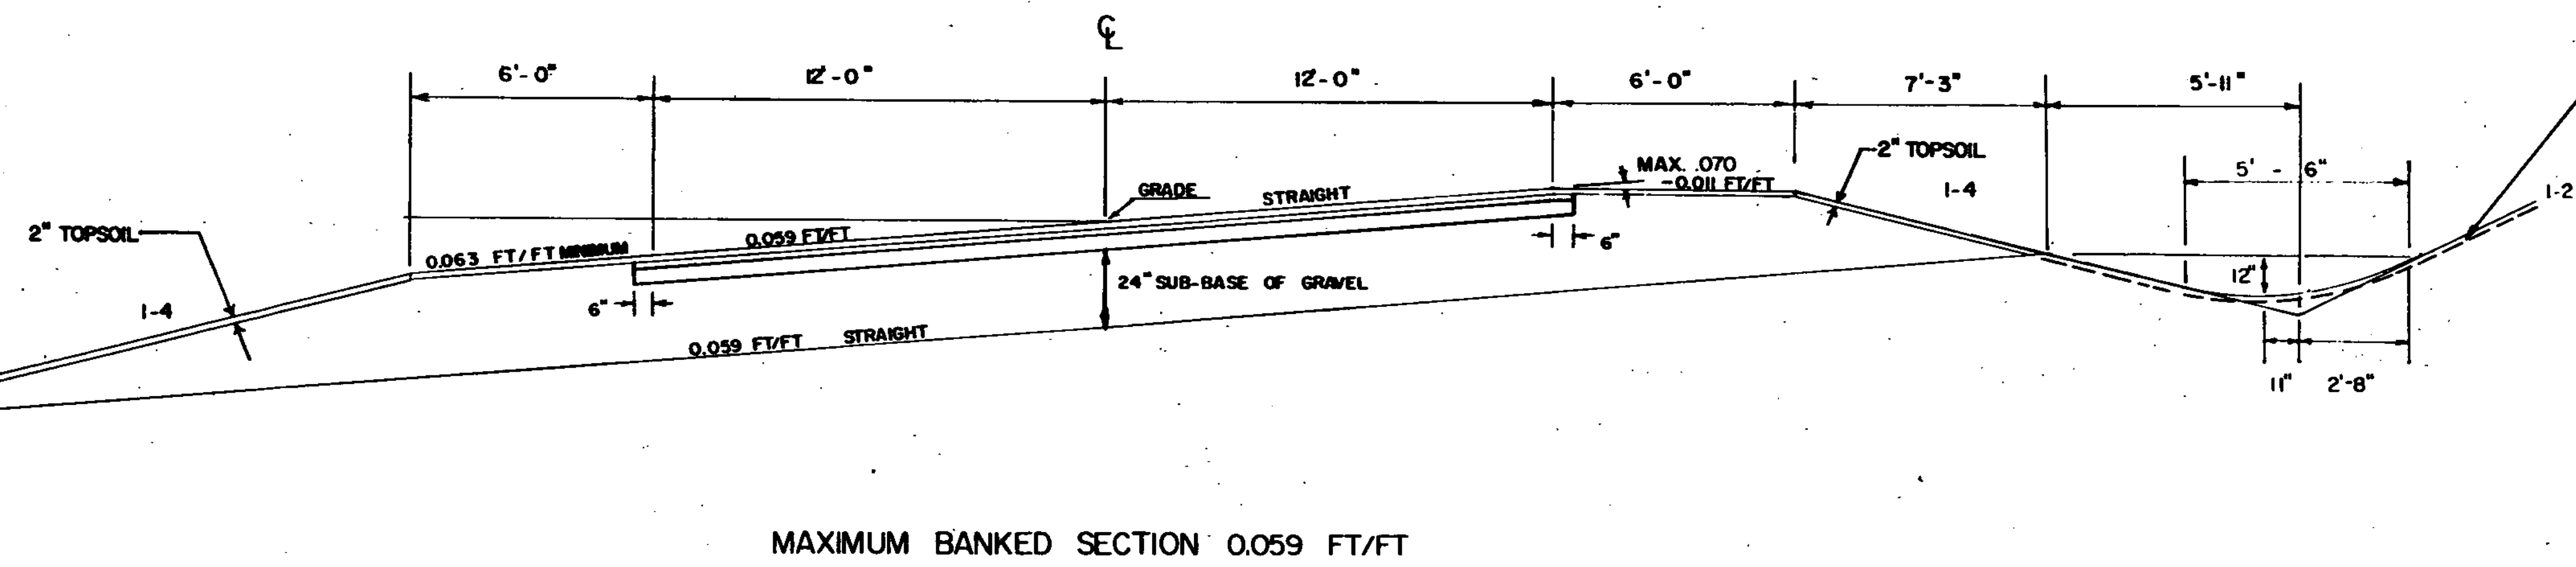


MAXIMUM BANKED SECTION 0.059 FT/FT

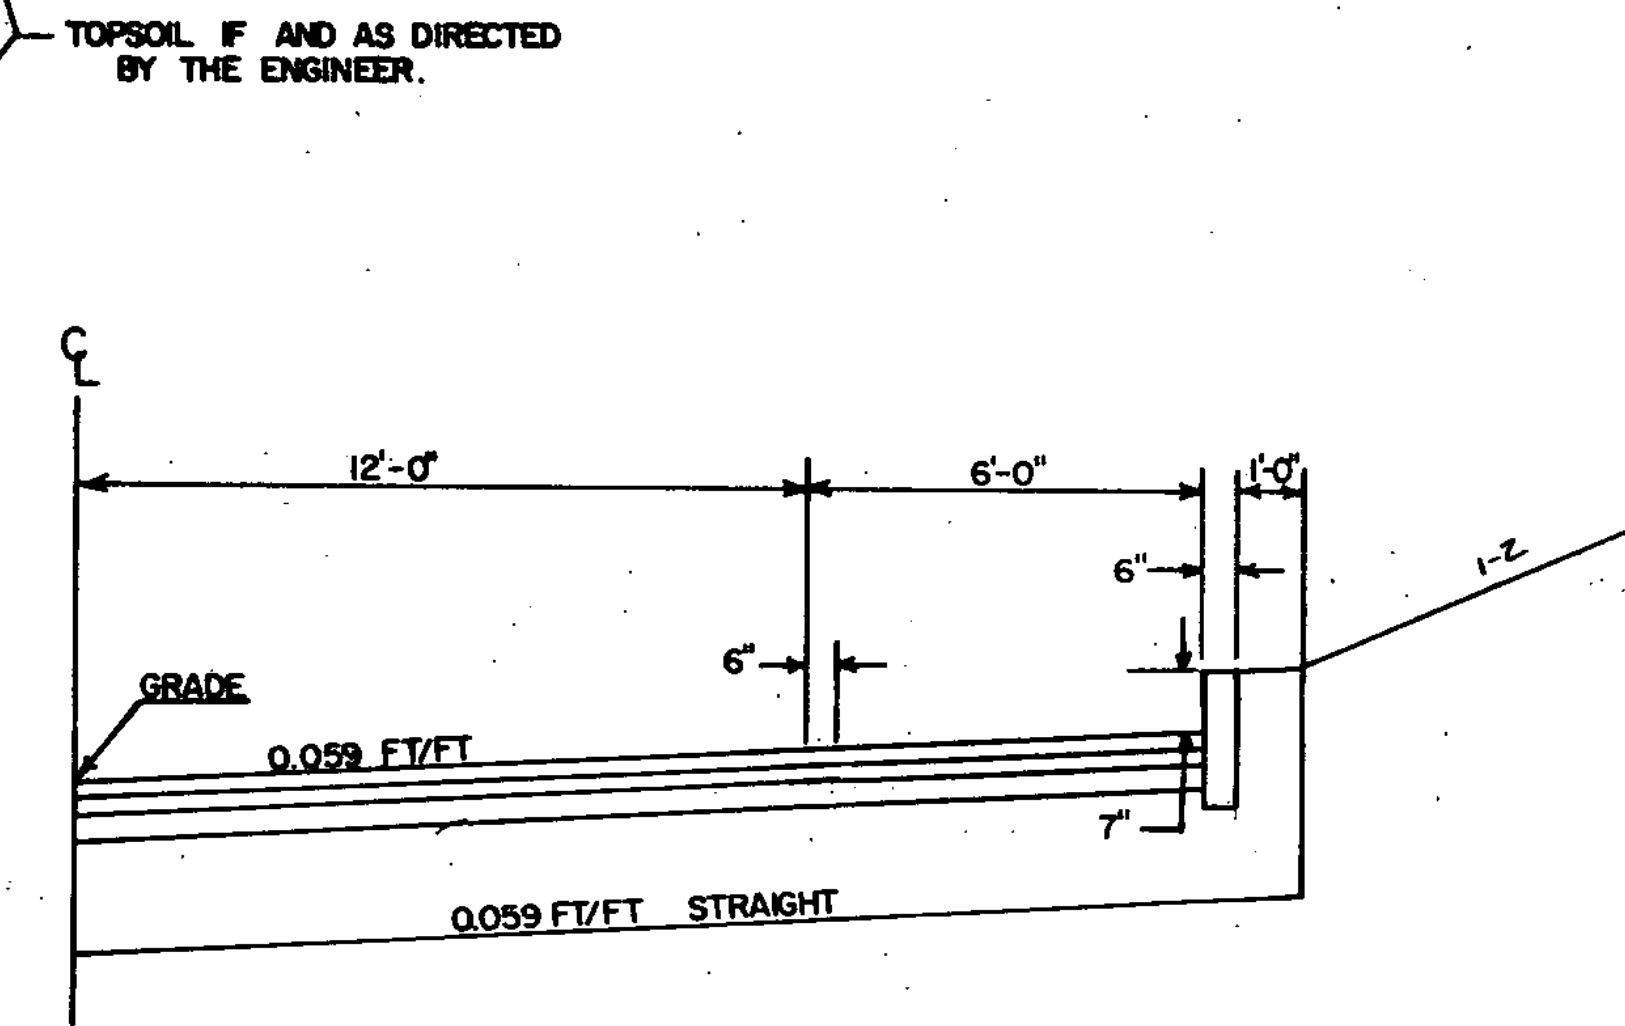


CURBED SECTION - MAXIMUM BANKING = 0.059 FT/FT
STA. 18+25 RT. - 20+00 RT.

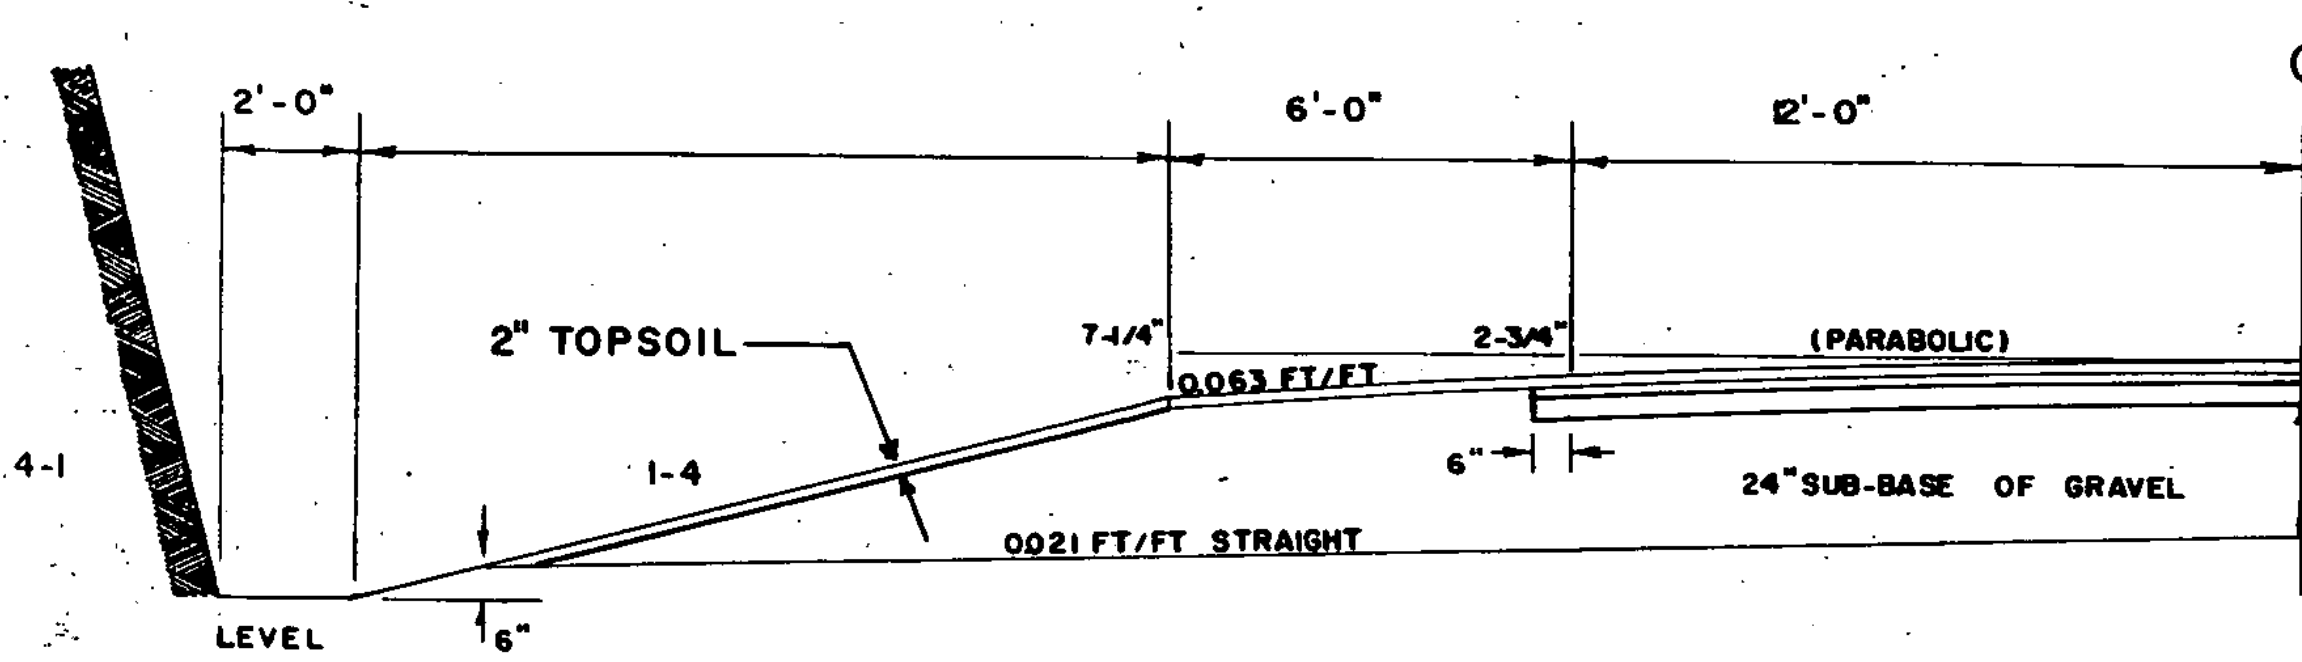

NORMAL SECTION IN SOLID ROCK EXCAVATION
(SEE STANDARD SHEET A-62 FOR ADDITIONAL DETAILS)

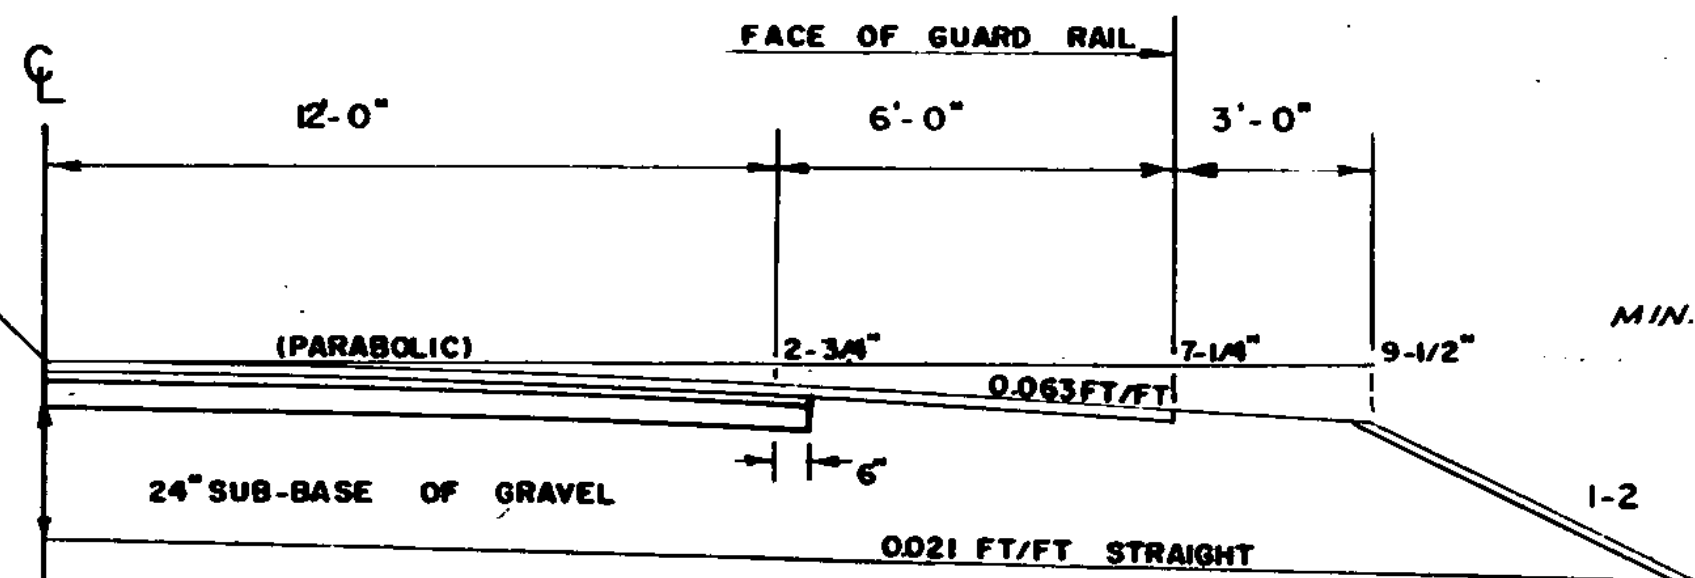

NORMAL SECTION WITH GUARD RAIL

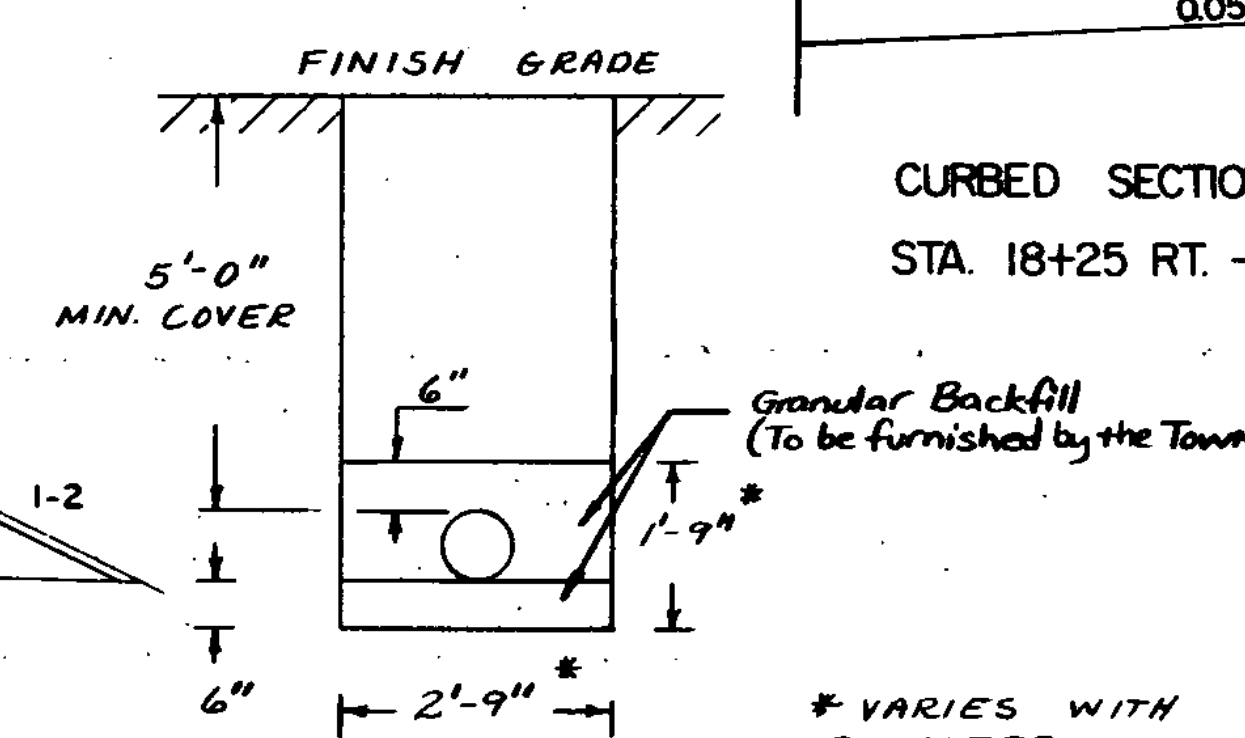

TYPICAL TRENCH FOR WATER MAIN
ML 17+00 Lt. ~ TR 2 5+80 Lt.

TOWN OF HINESBURG

STATE OF VERMONT
AGENCY OF TRANSPORTATION

DRAWN BY: PRH 2/82 TRACED BY: PRH 2/82

PROJ. NO F 021-1(B)S SHEET 2 OF 76