


BEGIN R.O.W. PROJECT FO 21-1(8)S
STA. 17+00 C

BUSIER, BRIAN & KATHY

THIS SHEET TO BE USED
FOR R.O.W. INFORMATION ONLY

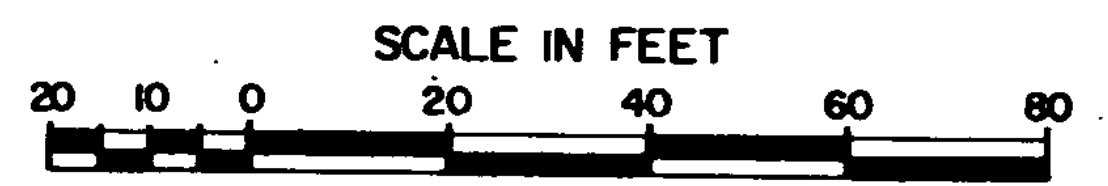

HINESBURG
F 021-1(8)S
SHEET 9 OF 76