



MAINLINE TIES

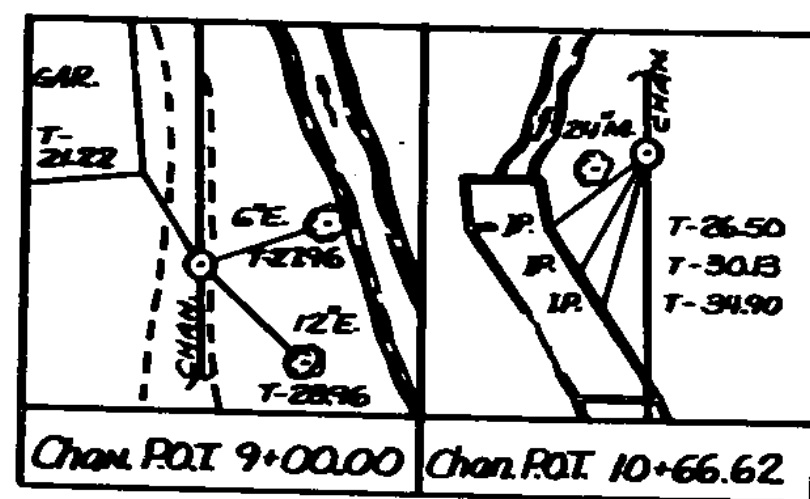

CHANNEL LINE TIES

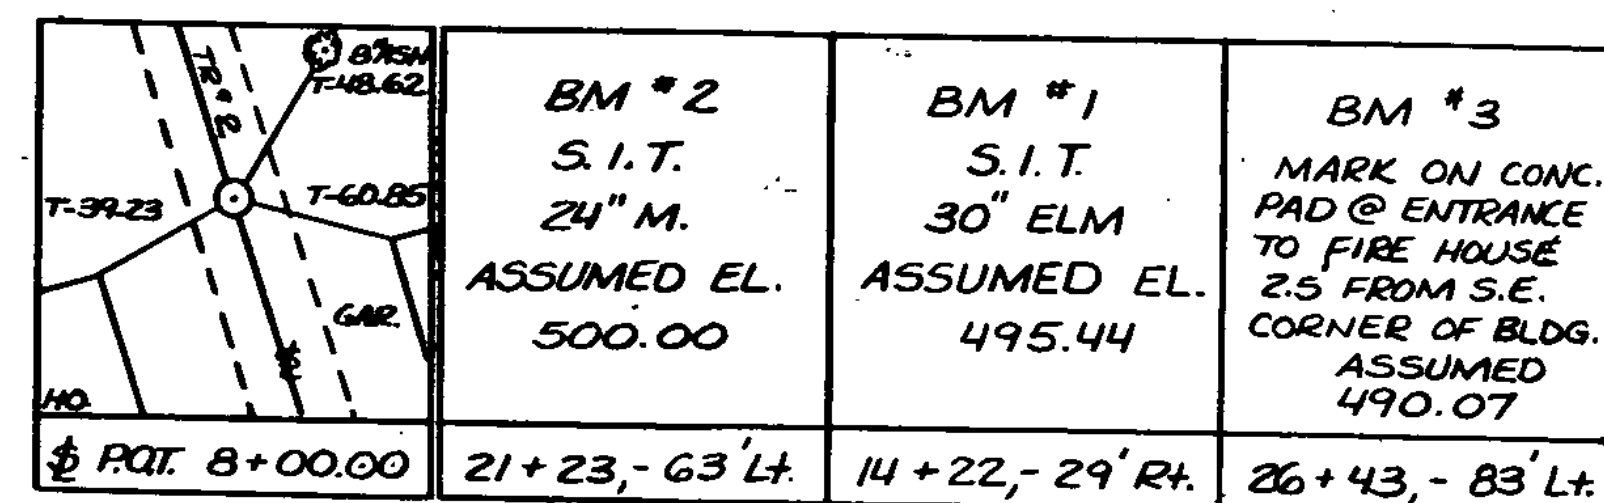

SIDELINE TIES

BENCHMARKS



ALL TIES ORIENTED TO THIS NORTH ARROW
ALL SKETCHES NOT TO SCALE

