


PC 18+99.42
 D=7°30' LT
 Full Bank .059

18+23 LT
 Begin Vertical Granite
 Curb

18+25
 BEGIN PROJECT F 021-1(8)S
 END APPROACH

18+25 RT
 Begin Vertical Granite Curb

18+16 RT
 Construct Drive (20' wide, Stone)
 See Special Provision

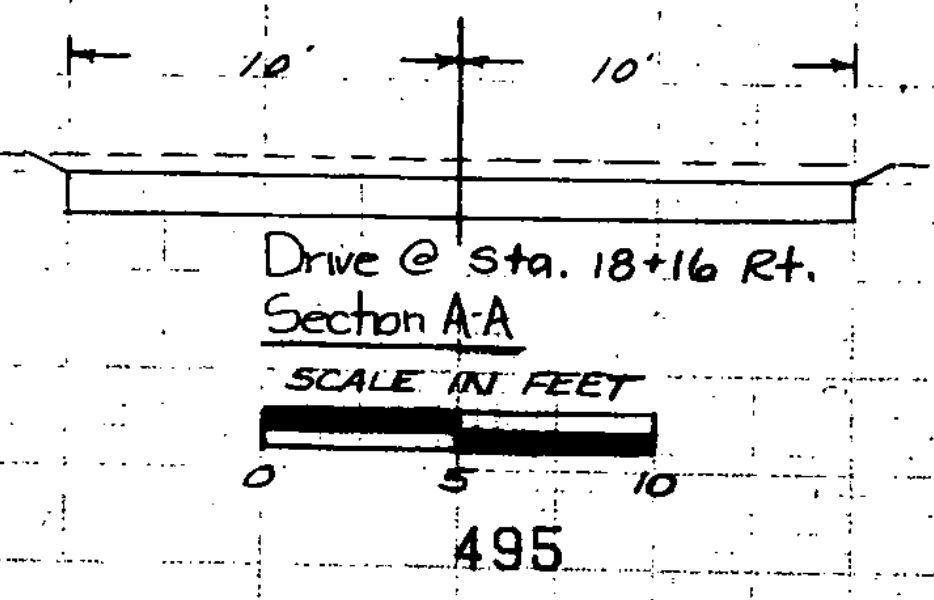

Drive @ Sta. 18+16 Rt.
 Section A-A
 SCALE IN FEET

FROM STA. 18+16	TO STA. 19+50
PROJECT NAME	HINEBURD MAINLINE
NO.	F021-1(8)S
SURVEYED BY	MORREAU
SHEET 102 OF 76 SHEETS	PLOTTED 10/27/00 JULY 1998