
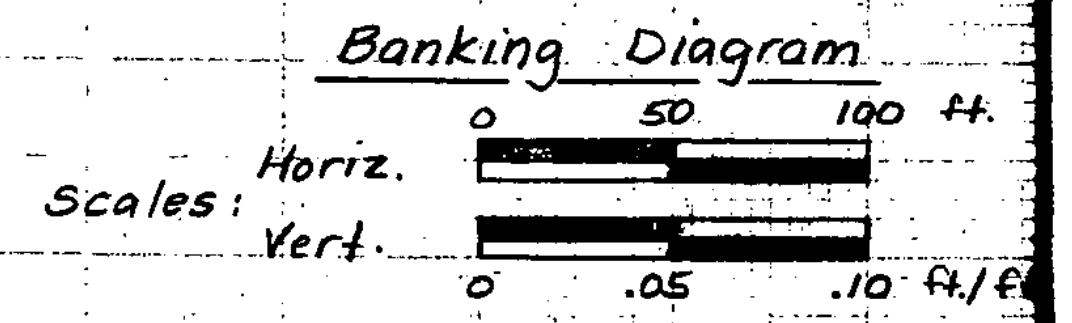


DRIVE TYPICAL

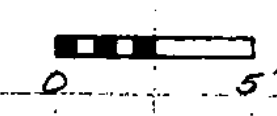

FROM STA. 18+85	TO STA. 20+50
PROJECT NAME HINEBURG MAINLINE	
NO. F021-1(8)18	PLOTTED 10/27/76
SURVEYED BY MOREAU	JULY 1980
SHEET 63 OF 76 SHEETS	

SCALE 1" = 100'