
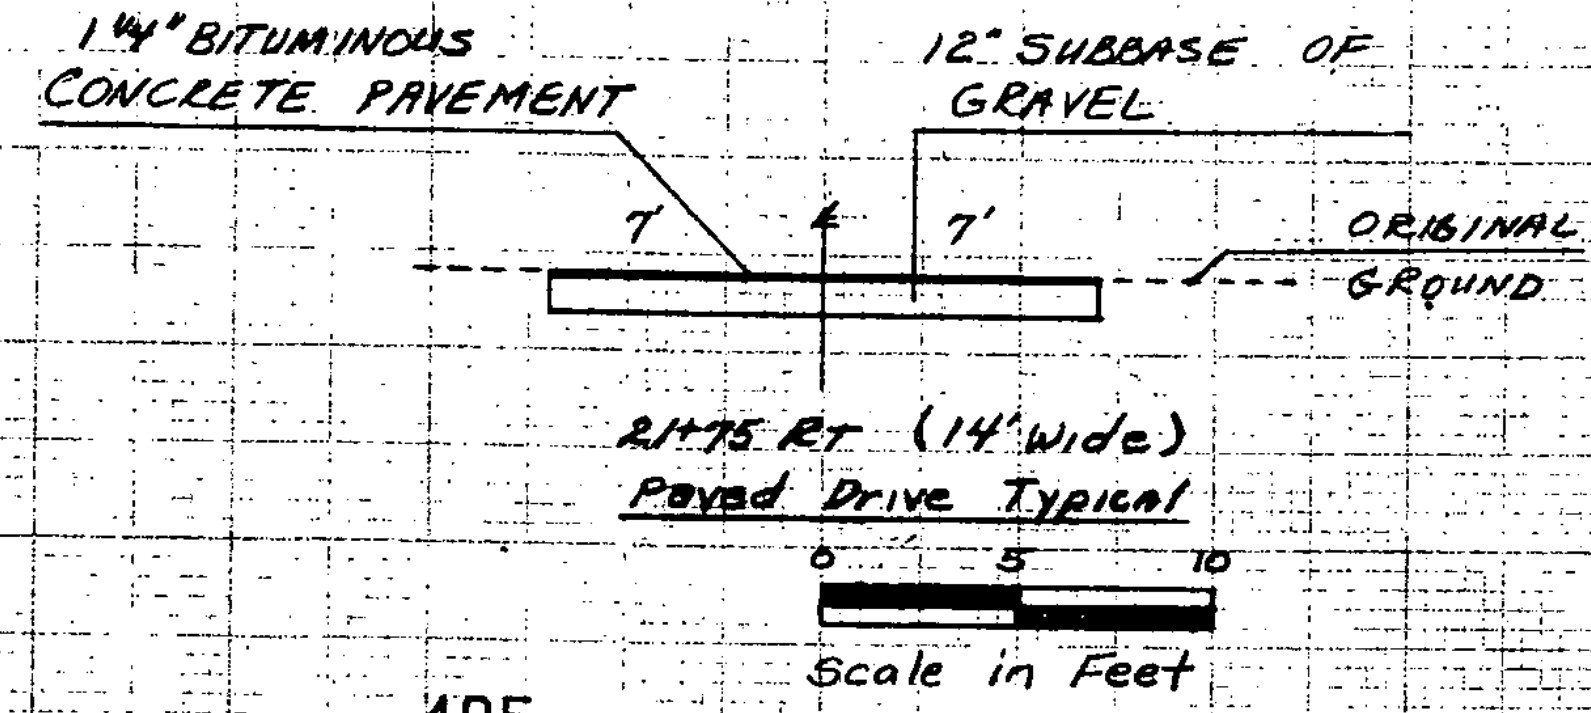


END PROJECT F 021-1(B) S
BEGIN APPROACH

23+50 End Approach

22+50 Begin Approach
End Project F 021-1(B) S

Approach Taper Detail

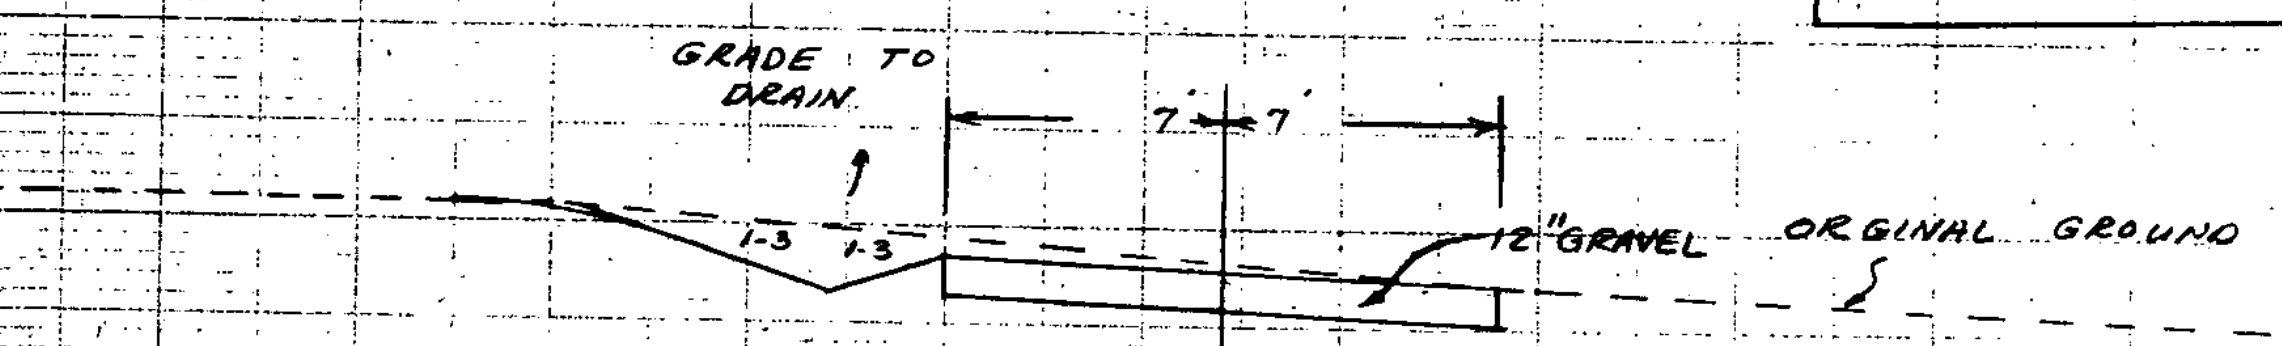

21+67 Lt
Construct Drive (14' Wide)

21+75 Rt
Construct Drive (14' Wide) Paved

FROM STA. 21+75	TO STA. 22+66
PROJECT NAME	HINEBURG MAINLINE
NO.	F021-1(B)S
SURVEYED BY	MOREAU
SHEET 65 OF 76 SHEETS	PLOTTED 10/27/80 JULY 1980

SCALE: 1" = 10'