


TR #2 5+76 RT.
 Construct Drive (26' Wide)
 Existing 15" C&MP W/RCOI Remove
 New 18" x 32" RC&MP .044

505

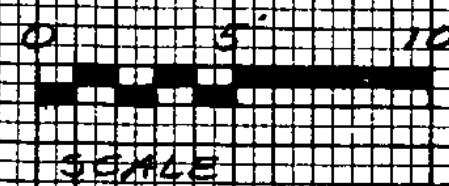

Hinesburg East (B) S
 Sheet 69 of 76