


Temporary 4" ReflectORIZED White Lines
 Lt. 190+00~192+00, match=12' Lt.
 Rt. 192+00~194+00, 12' Rt.
 Temporary 4" ReflectORIZED Yellow Lines
 Lt. 190+00~194+00, (Obt.)

Construct Drive
 191183.41
 193174 Lt
 193140 Rt

□ Tree To be Removed
 ○ Tree To be Saved


PLAN
 SURVEYED BY: []
 DRAWN BY: []
 CHECKED BY: []
 DATE: []

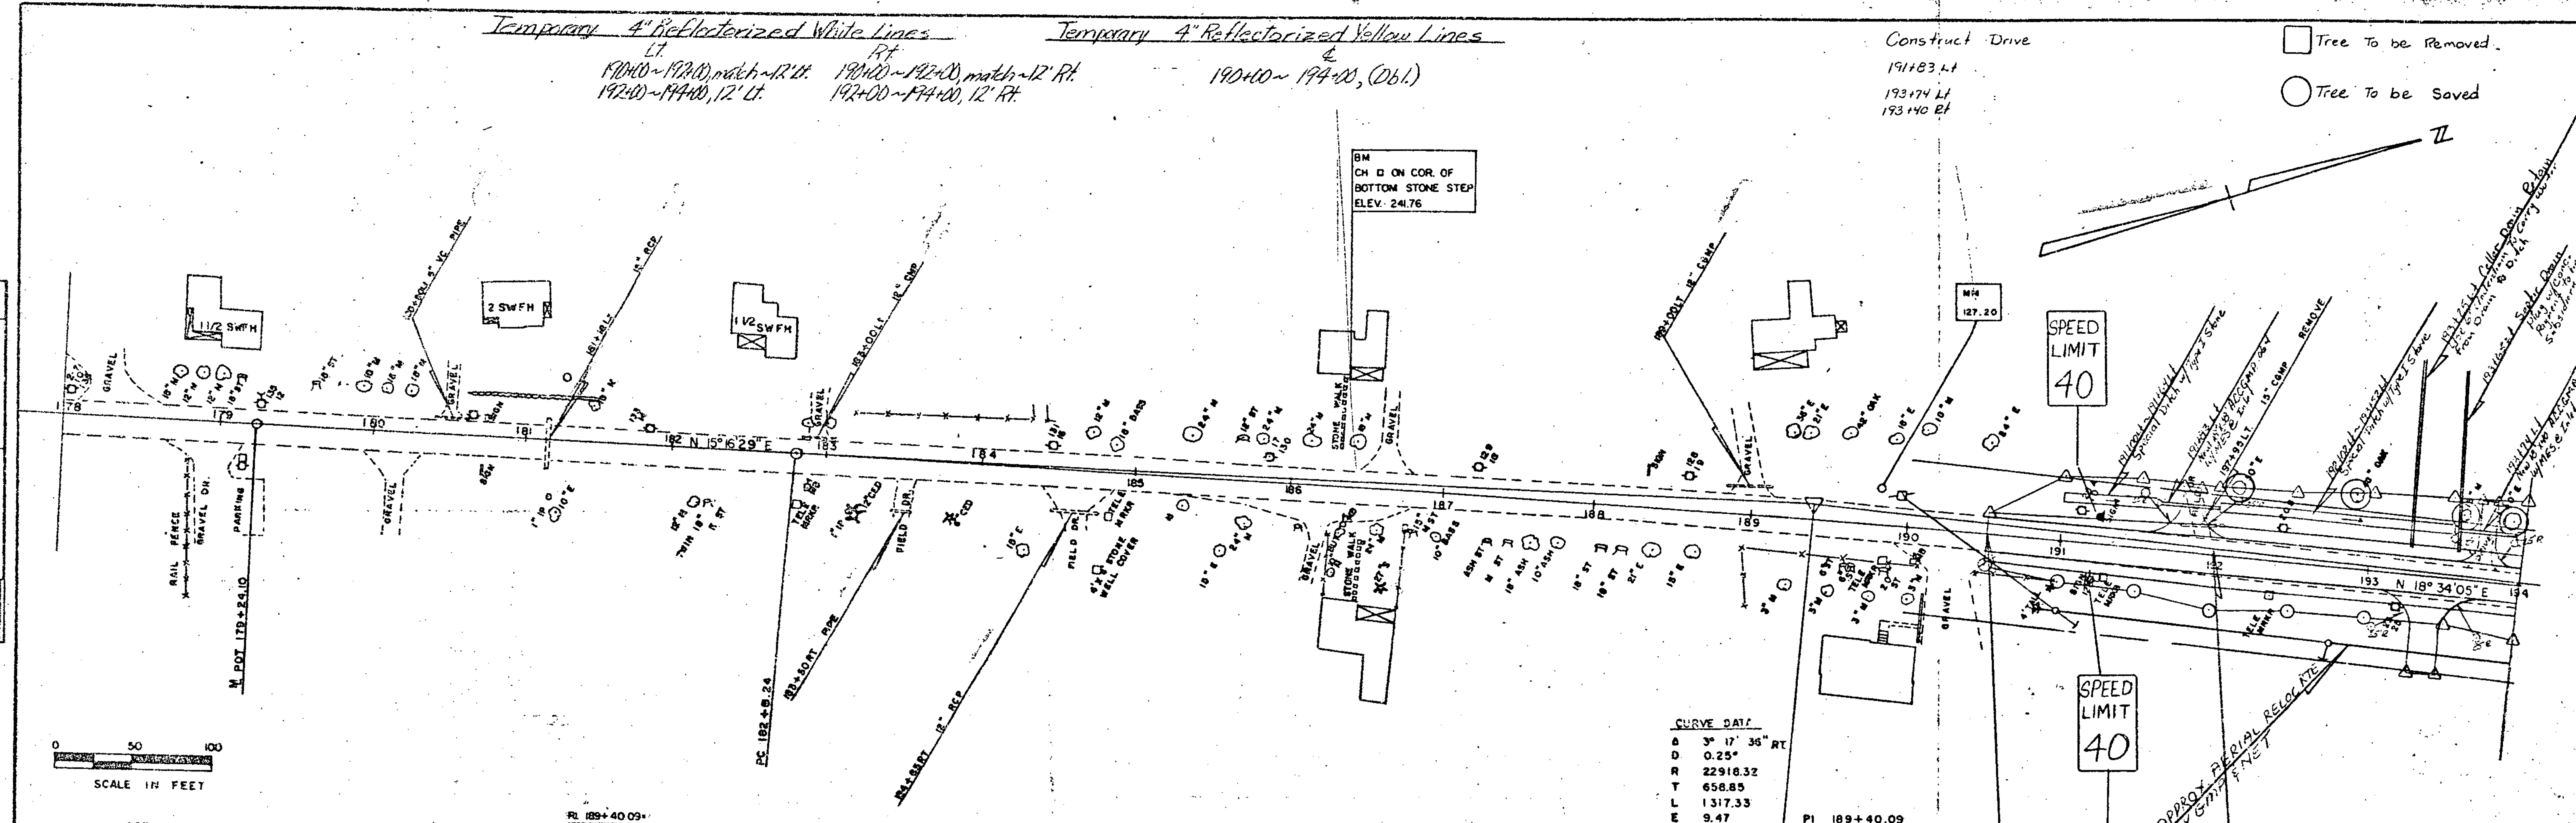

SCALE IN FEET
 0 50 100

CURVE DATA
 $\Delta = 3^\circ 17' 35''$ RT
 $D = 0.25'$
 $R = 22918.32$
 $T = 658.85$
 $L = 1317.33$
 $E = 9.47$
 $NO BANKING$
 PI 189+40.09
 183+39.72

PROFILE
 SURVEYED BY: []
 DRAWN BY: []
 CHECKED BY: []
 DATE: []

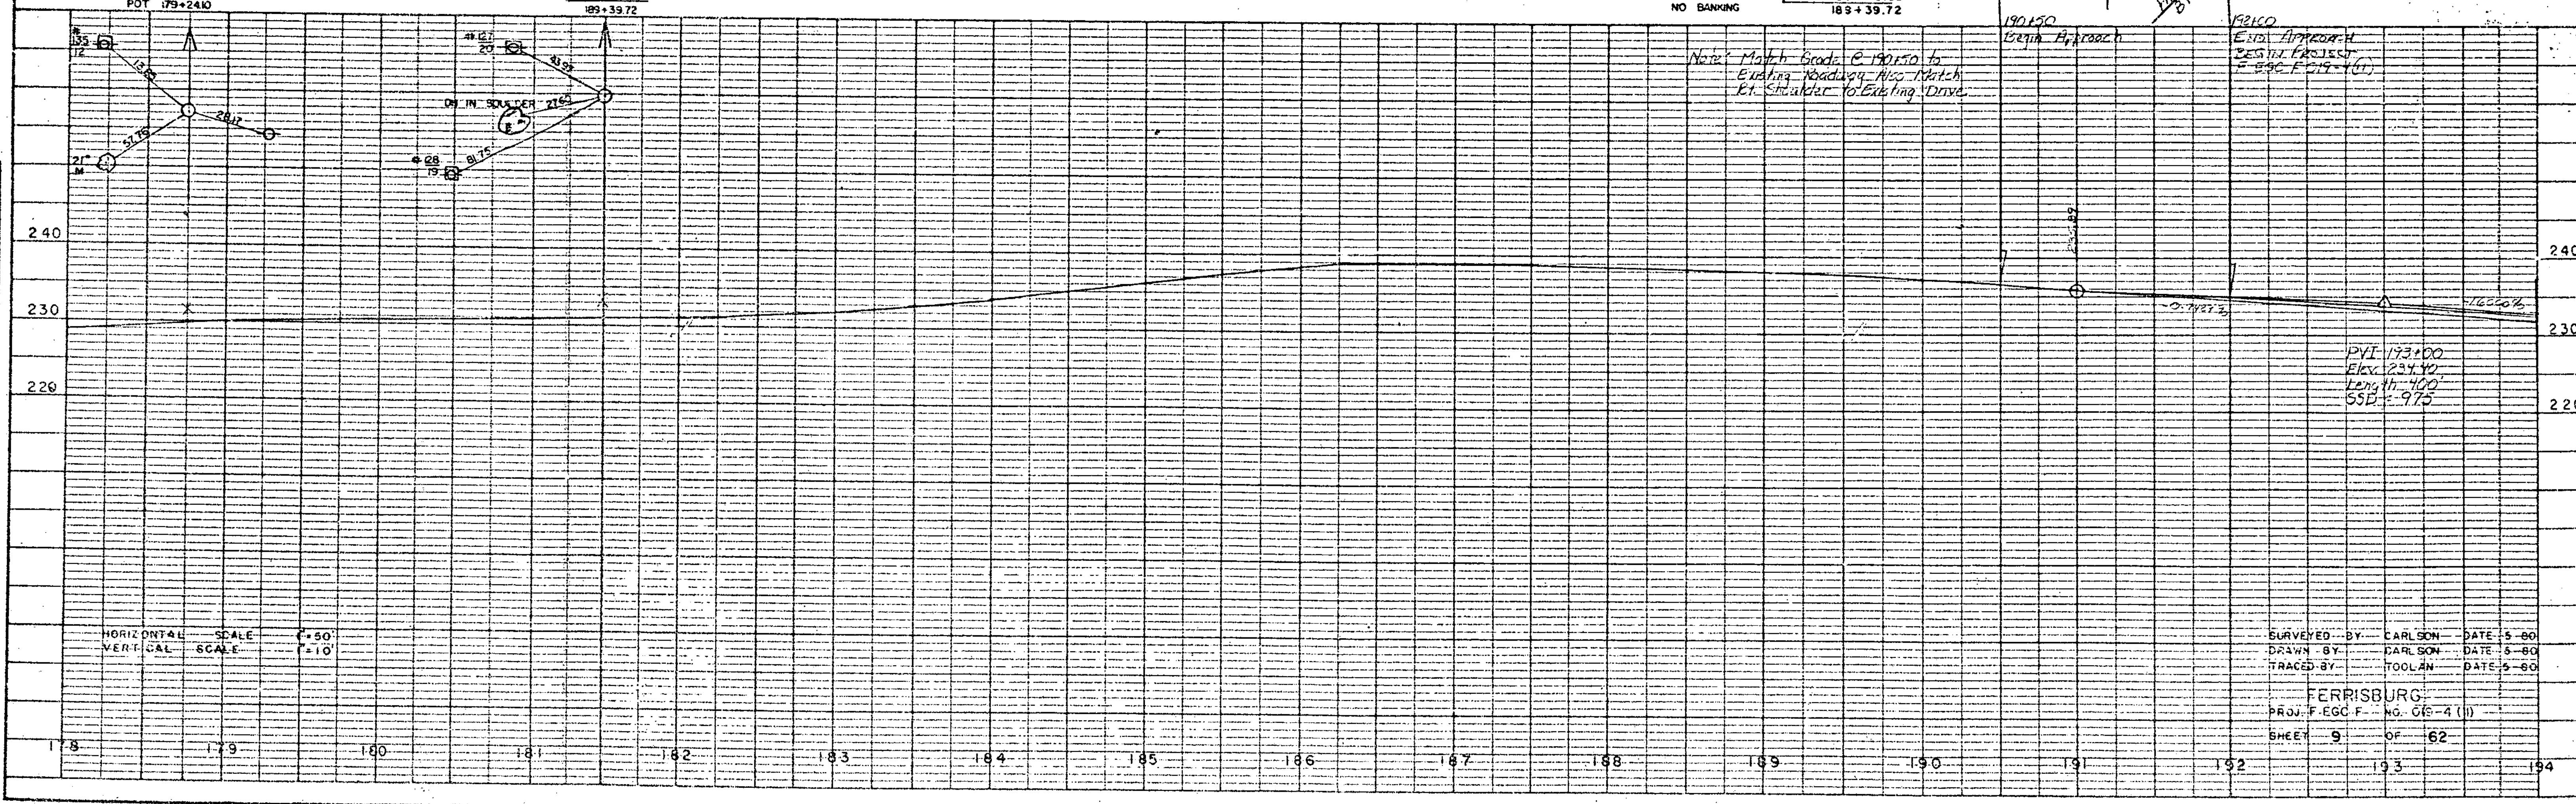

HORIZONTAL SCALE = 1" = 50'
 VERTICAL SCALE = 1" = 10'

SURVEYED BY: CARLSON DATE: 5-60
 DRAWN BY: CARLSON DATE: 5-60
 TRACED BY: TOOLAN DATE: 5-60
 FERRISBURG
 PROJ. F.E.G.F. NG. C/S-4 (1)
 SHEET 9 OF 62