



Temporary 4" Reflectorized White Lines
 Lt. 194+00-210+00, 12' Lt. 194+00-210+00, 12' Rt.

Temporary 4" Reflectorized Yellow Lines
 194+00-208+55, (Dbl)
 208+55-210+00; Solid Lt., Dashed Rt.

○ Tree To be Saved
 □ Tree To be Removed

PLAN
 SURVEYED BY
 DRAWN BY
 CHECKED BY
 DATE
 NO.

PROFILE
 SURVEYED BY
 DRAWN BY
 CHECKED BY
 DATE
 NO.

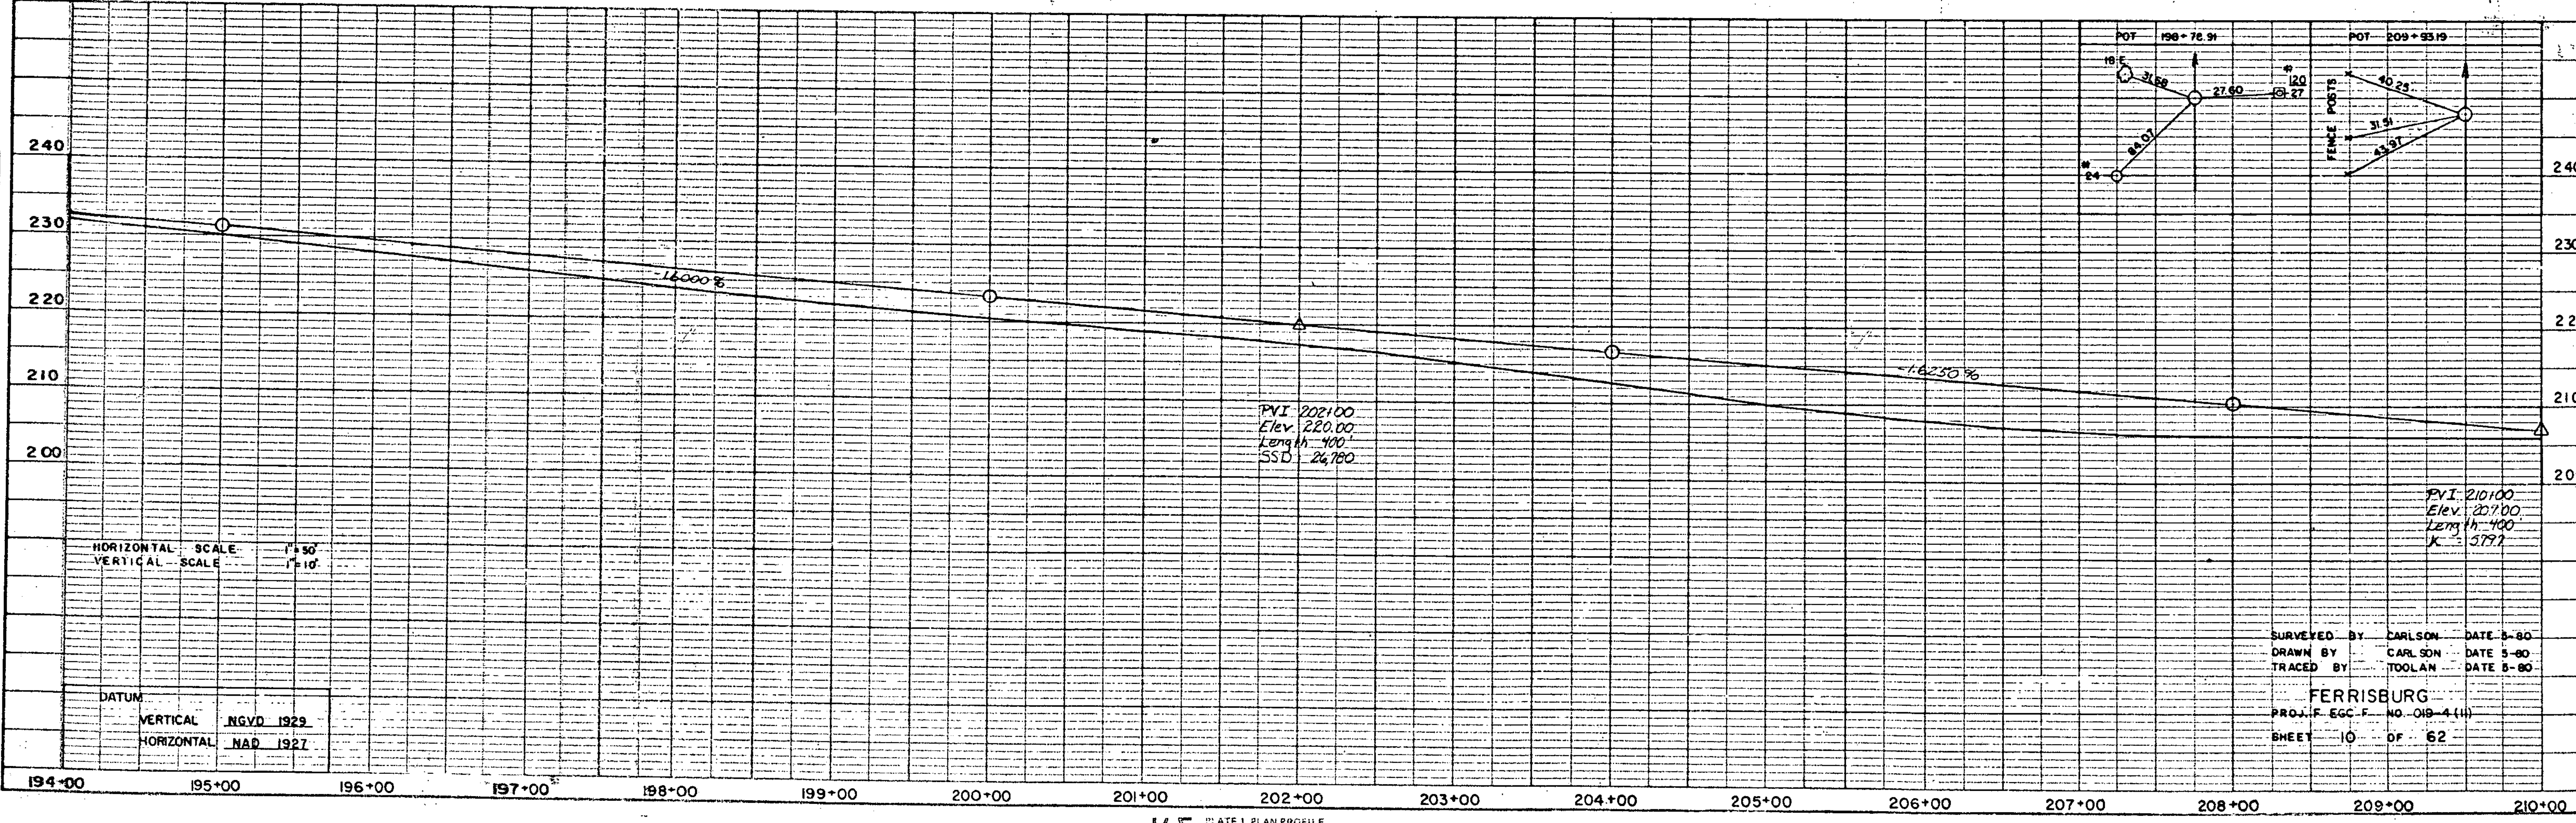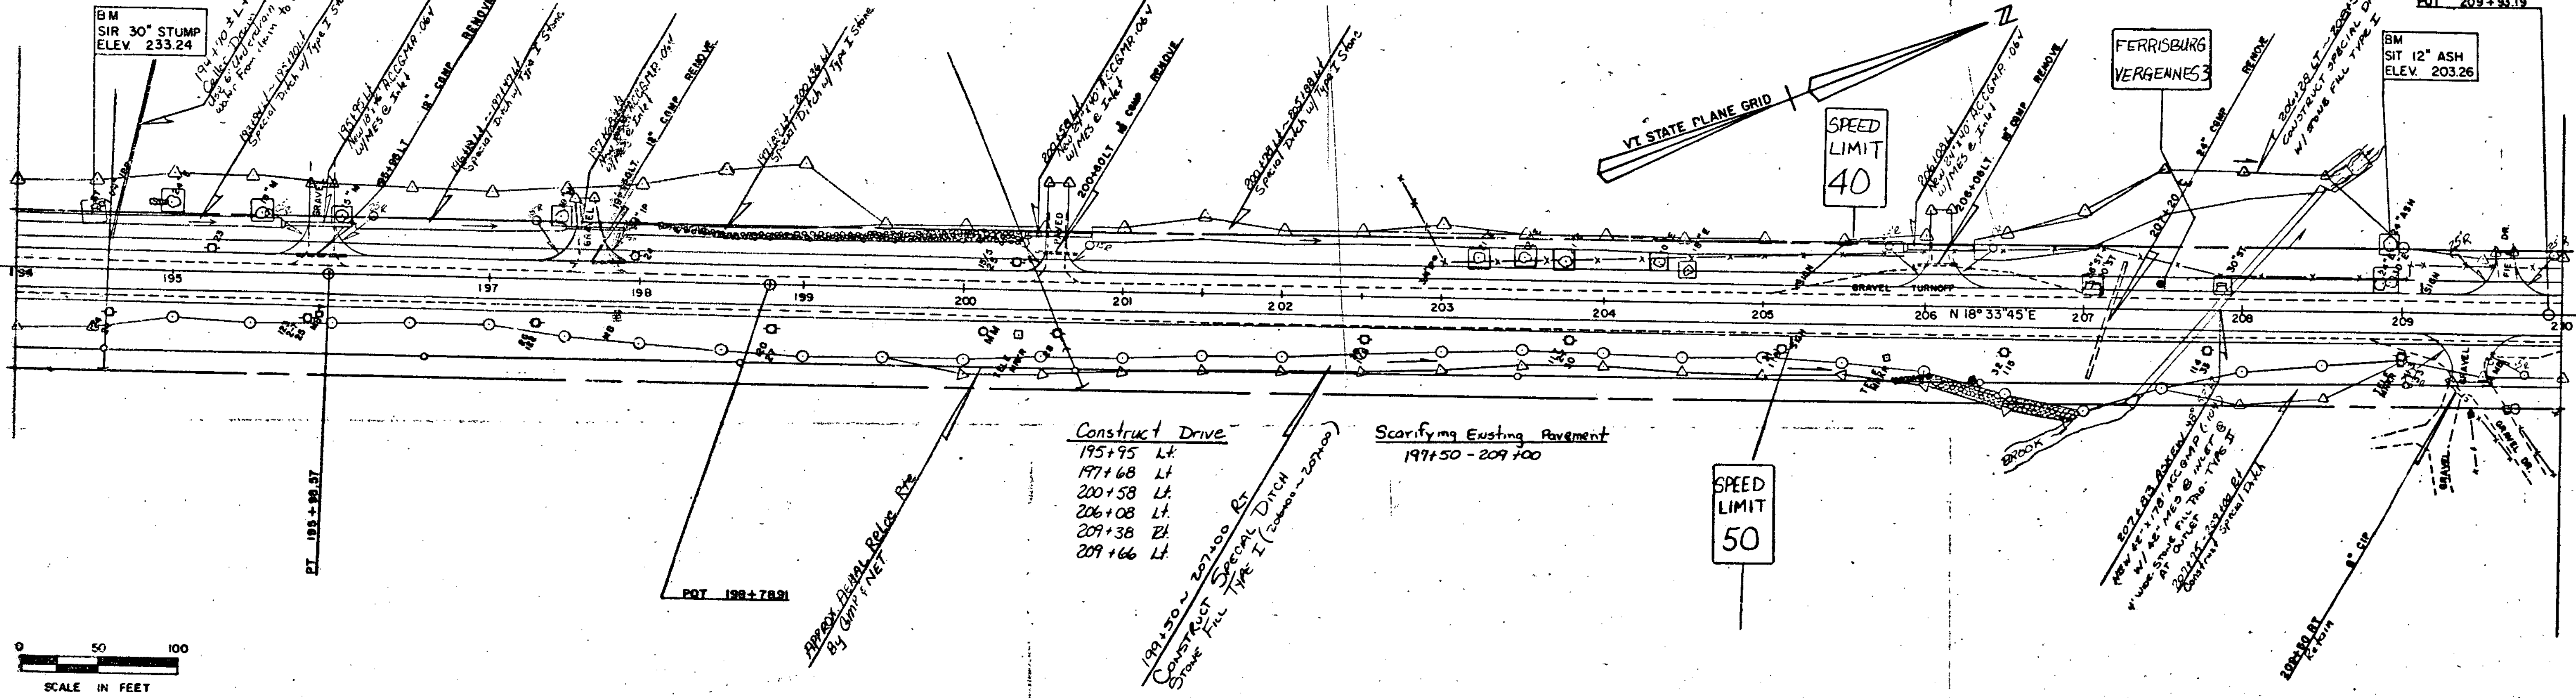

SURVEYED BY CARLSON DATE 5-80
 DRAWN BY CARLSON DATE 5-80
 TRACED BY TOOLAN DATE 5-80
 FERRISBURG
 PROJ. EGC F. NO. 018-4(11)
 SHEET 10 OF 62