

○ Tree to be Saved
 □ Tree to be Removed


Construct Drive
 228+60 Rt
 229+39 Lt

Temporary 4" Reflectorized White Lines
 Lt. 226+00~231+00, 12' Lt. 226+00~231+00, 12' Rt.
 Rt. 231+00~232+50, 12' Lt~match 231+00~232+50, 12' Rt~match

Temporary 4" Reflectorized Yellow Lines
 Lt. 226+00~228+60, Dashed
 Rt. 228+60~232+50, Double


PLAN
 SURVEYED BY
 DATE
 NOTE BOOK
 NO. OF WAY CHECKED

PROFILE
 SURVEYED BY
 DATE
 NOTE BOOK
 NO. OF WAY CHECKED

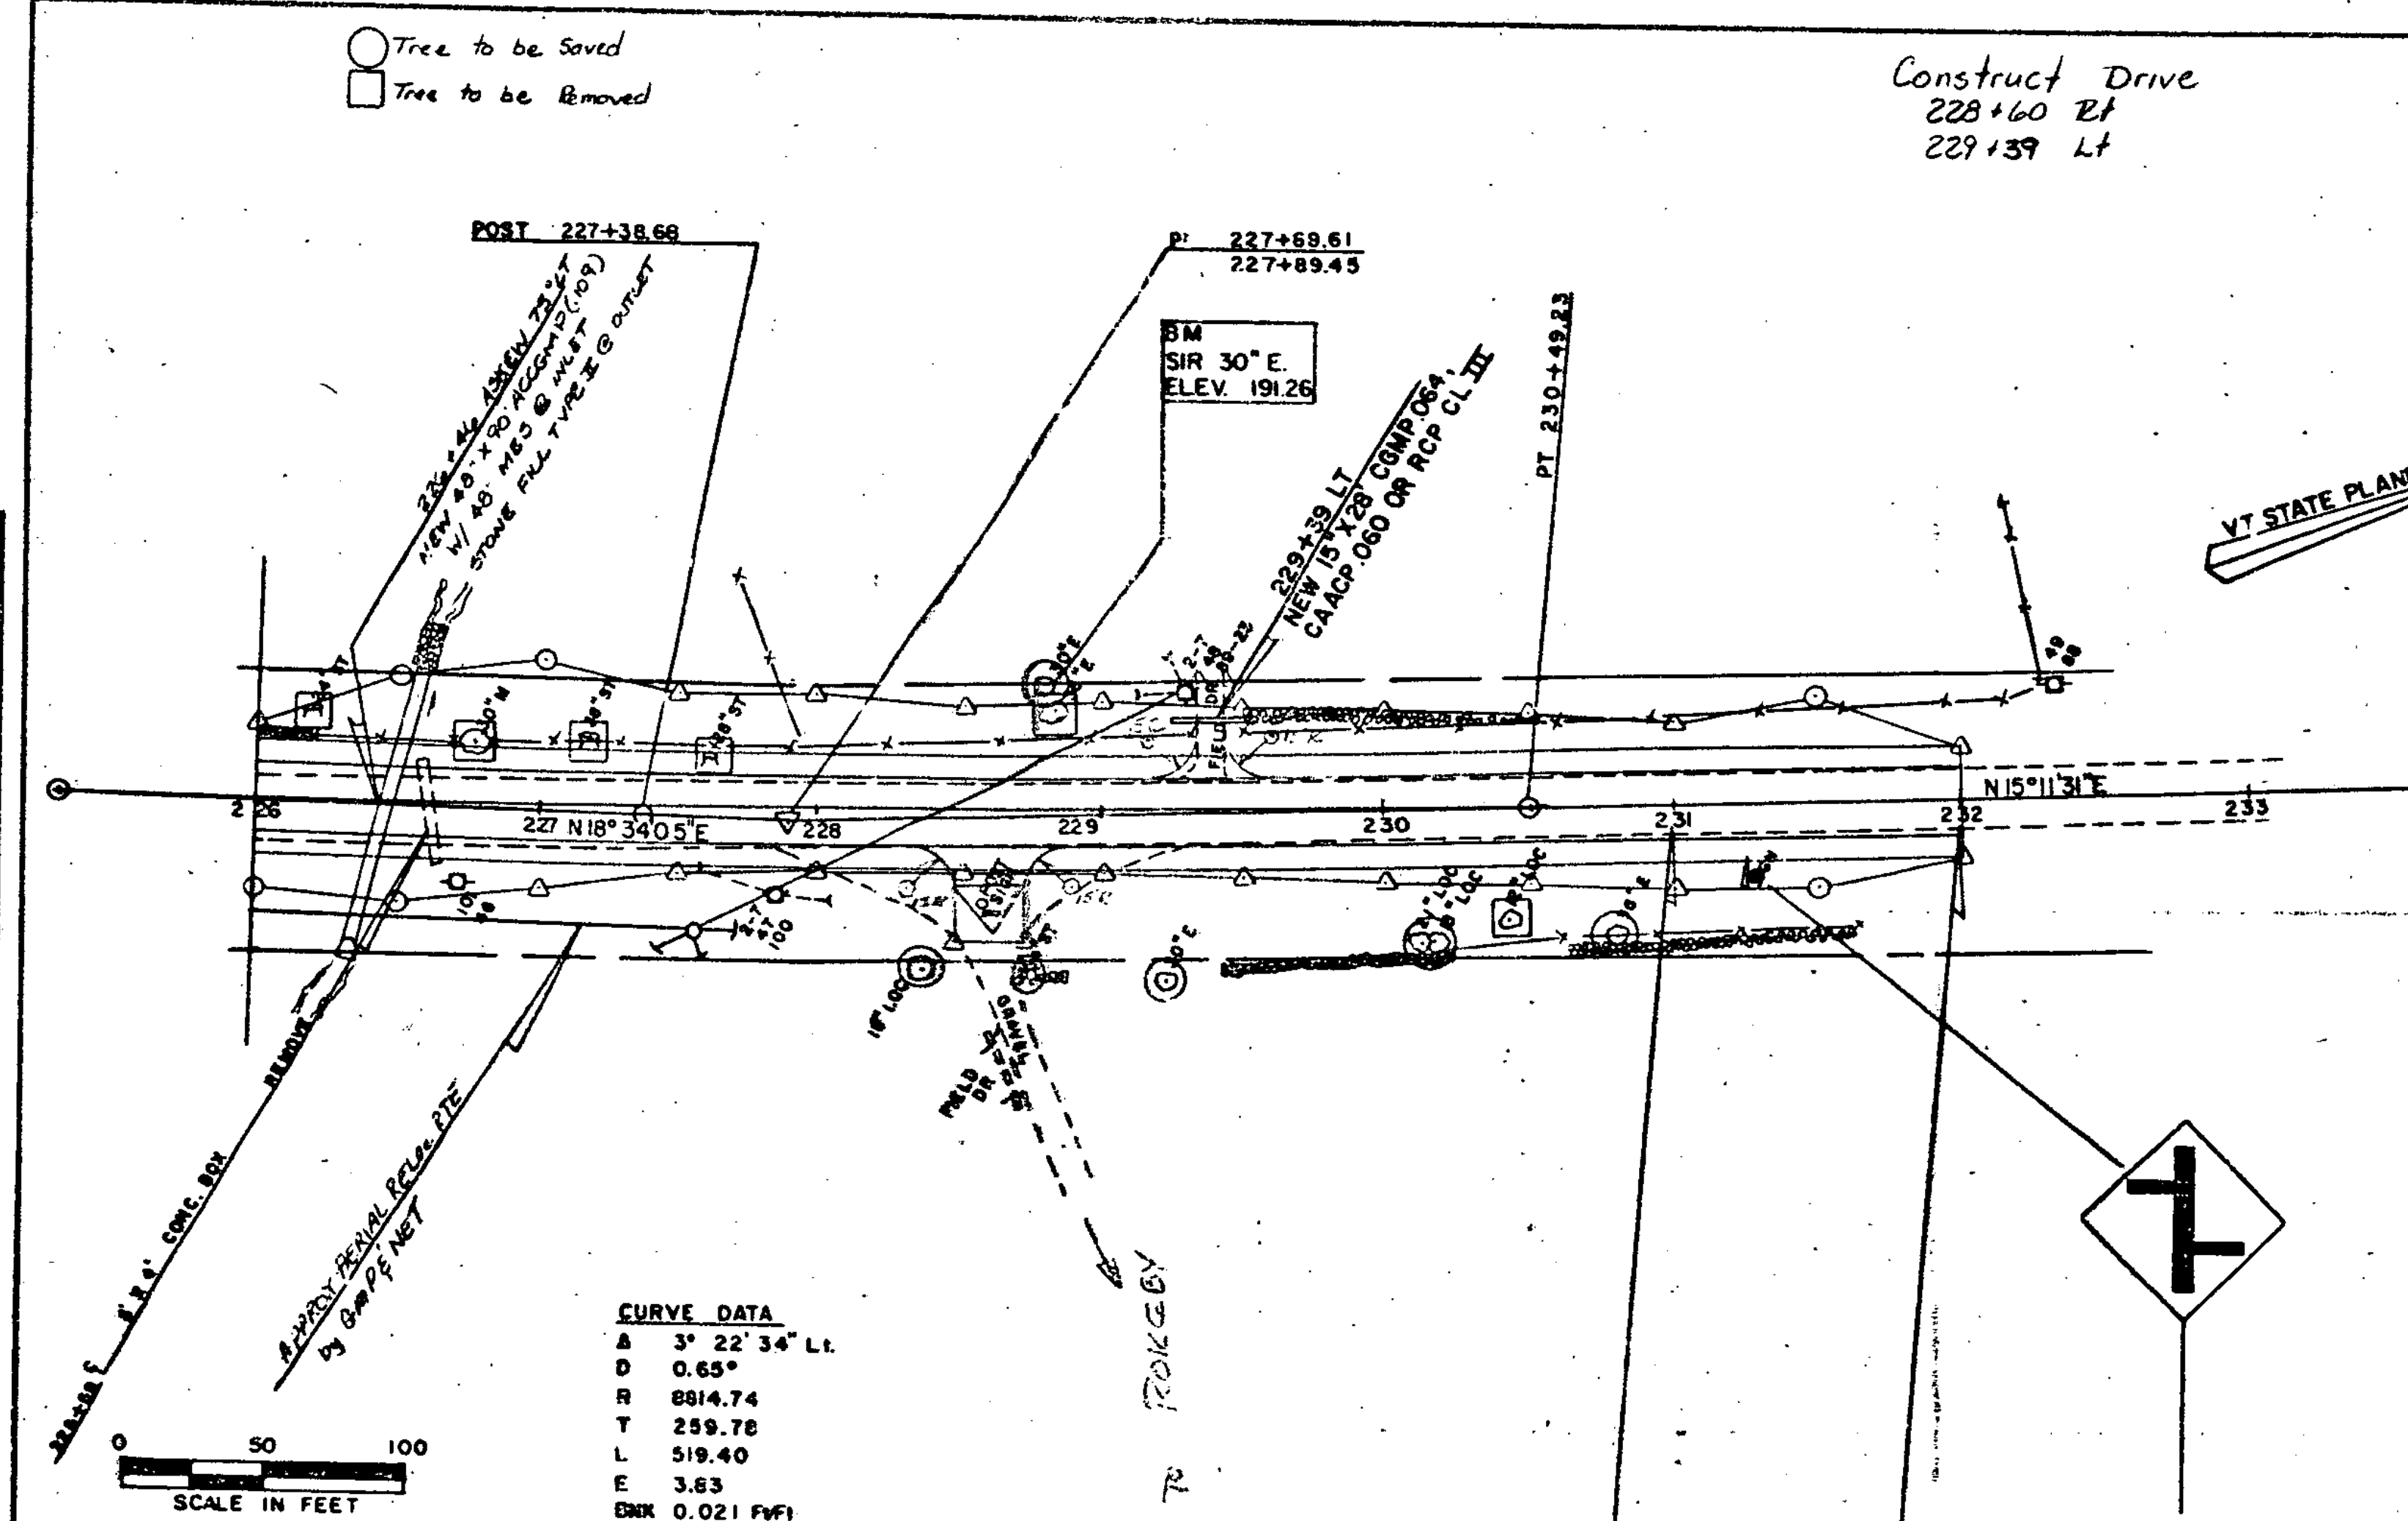

CURVE DATA

A	3° 22' 34" Lt.
D	0.65°
R	8814.74
T	259.78
L	519.40
E	3.63
GRN	0.021 FWT

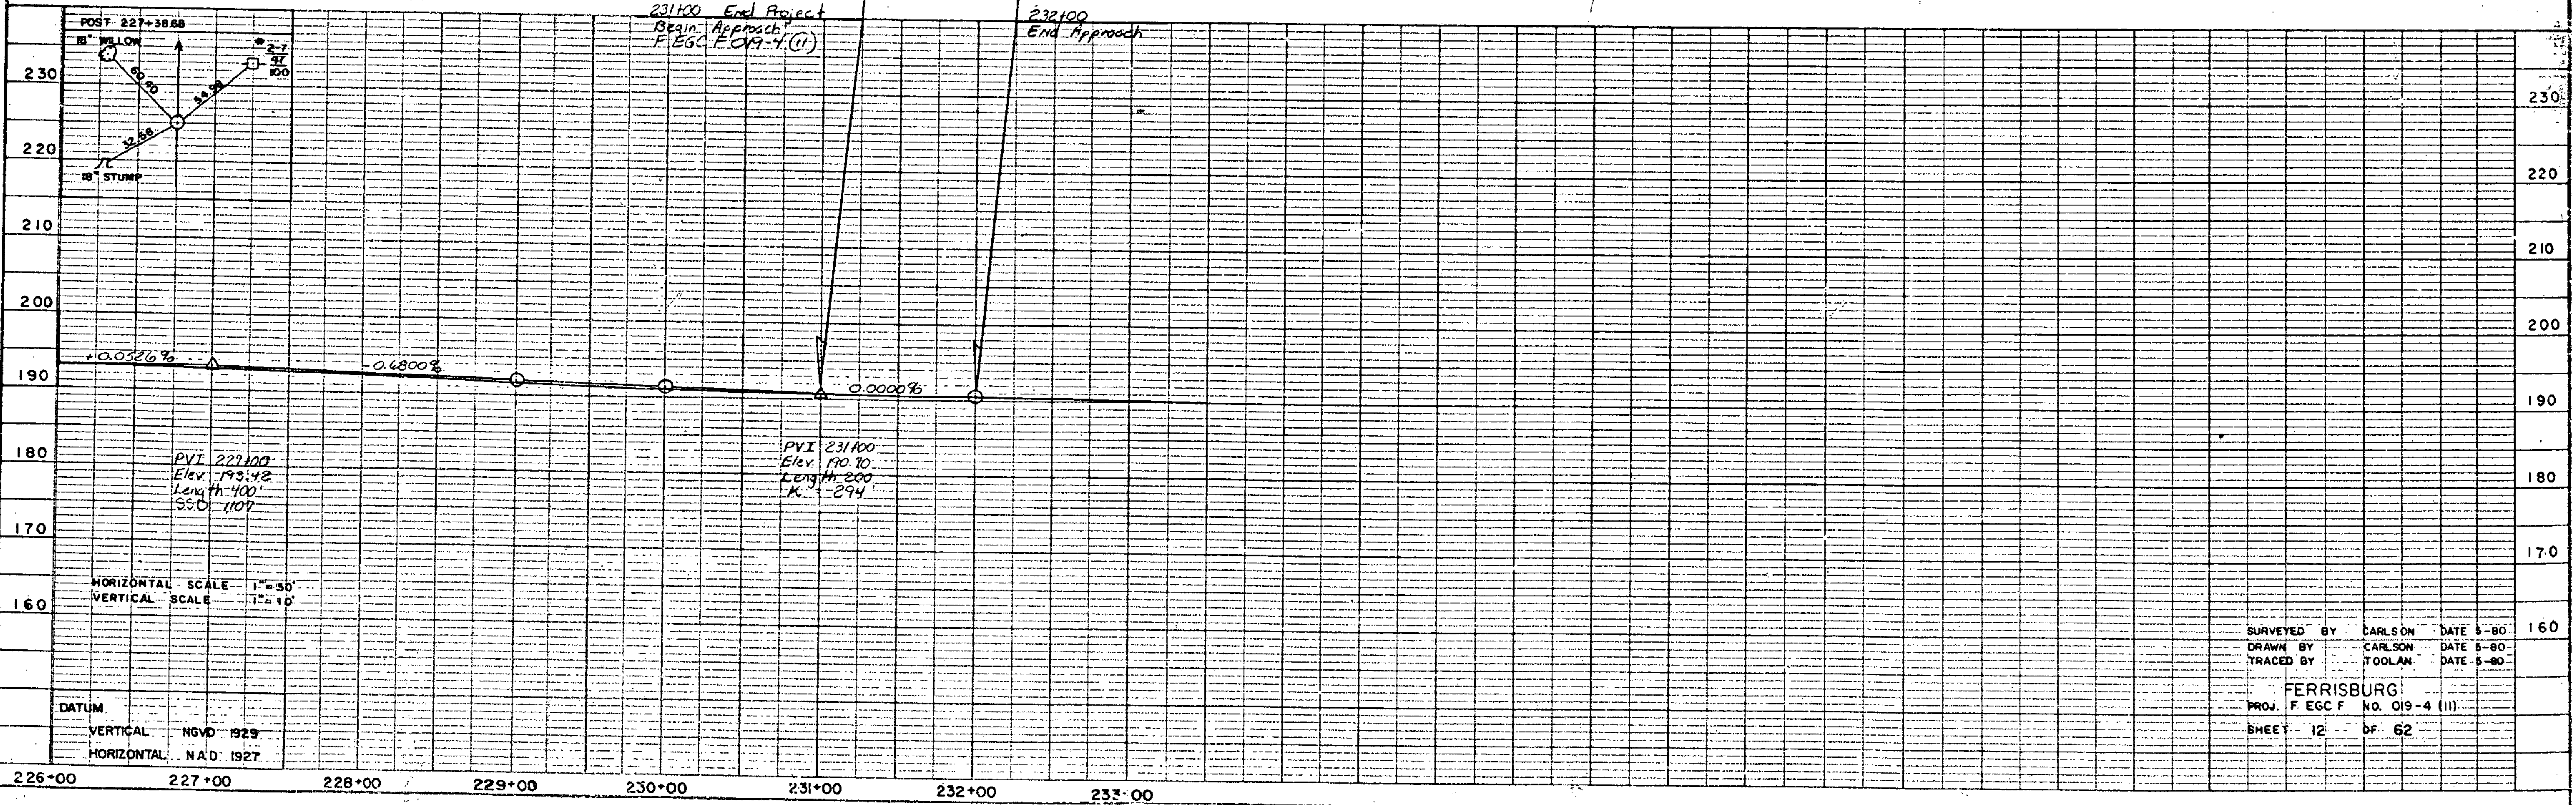

SURVEYED BY CARLSON DATE 5-80
 DRAWN BY CARLSON DATE 5-80
 TRACED BY TOOLAN DATE 5-80
 FERRISBURG
 PROJ. F EGC F NO. 019-4 (11)
 SHEET 12 OF 62

DATUM
 VERTICAL NGVD 1929
 HORIZONTAL NAD 1927

226+00 227+00 228+00 229+00 230+00 231+00 232+00 233+00