

PLAN
DATE
BY
CHECKED
APPROVED
NO. OF SHEETS
SHEET NO.

PROFILE
DATE
BY
CHECKED
APPROVED
NO. OF SHEETS
SHEET NO.



Item 675.55 SETTING BRASS PEGS
Sta. 188+17.56' Lt
Sta. 191+10.56' Rt
Sta. 191+10.56' Rt

Center line to be replaced
according to the existing site
distance diagram by State Forces

ITEM 675.50 REMOVING SIGNS
Sta. 188+17.74
Sta. 191+10 Lt
Sta. 191+10 Rt

Construction Drive
191+87 Lt
192+74 Lt
193+40 Rt

□ Tree to be Removed
○ Tree to be Saved

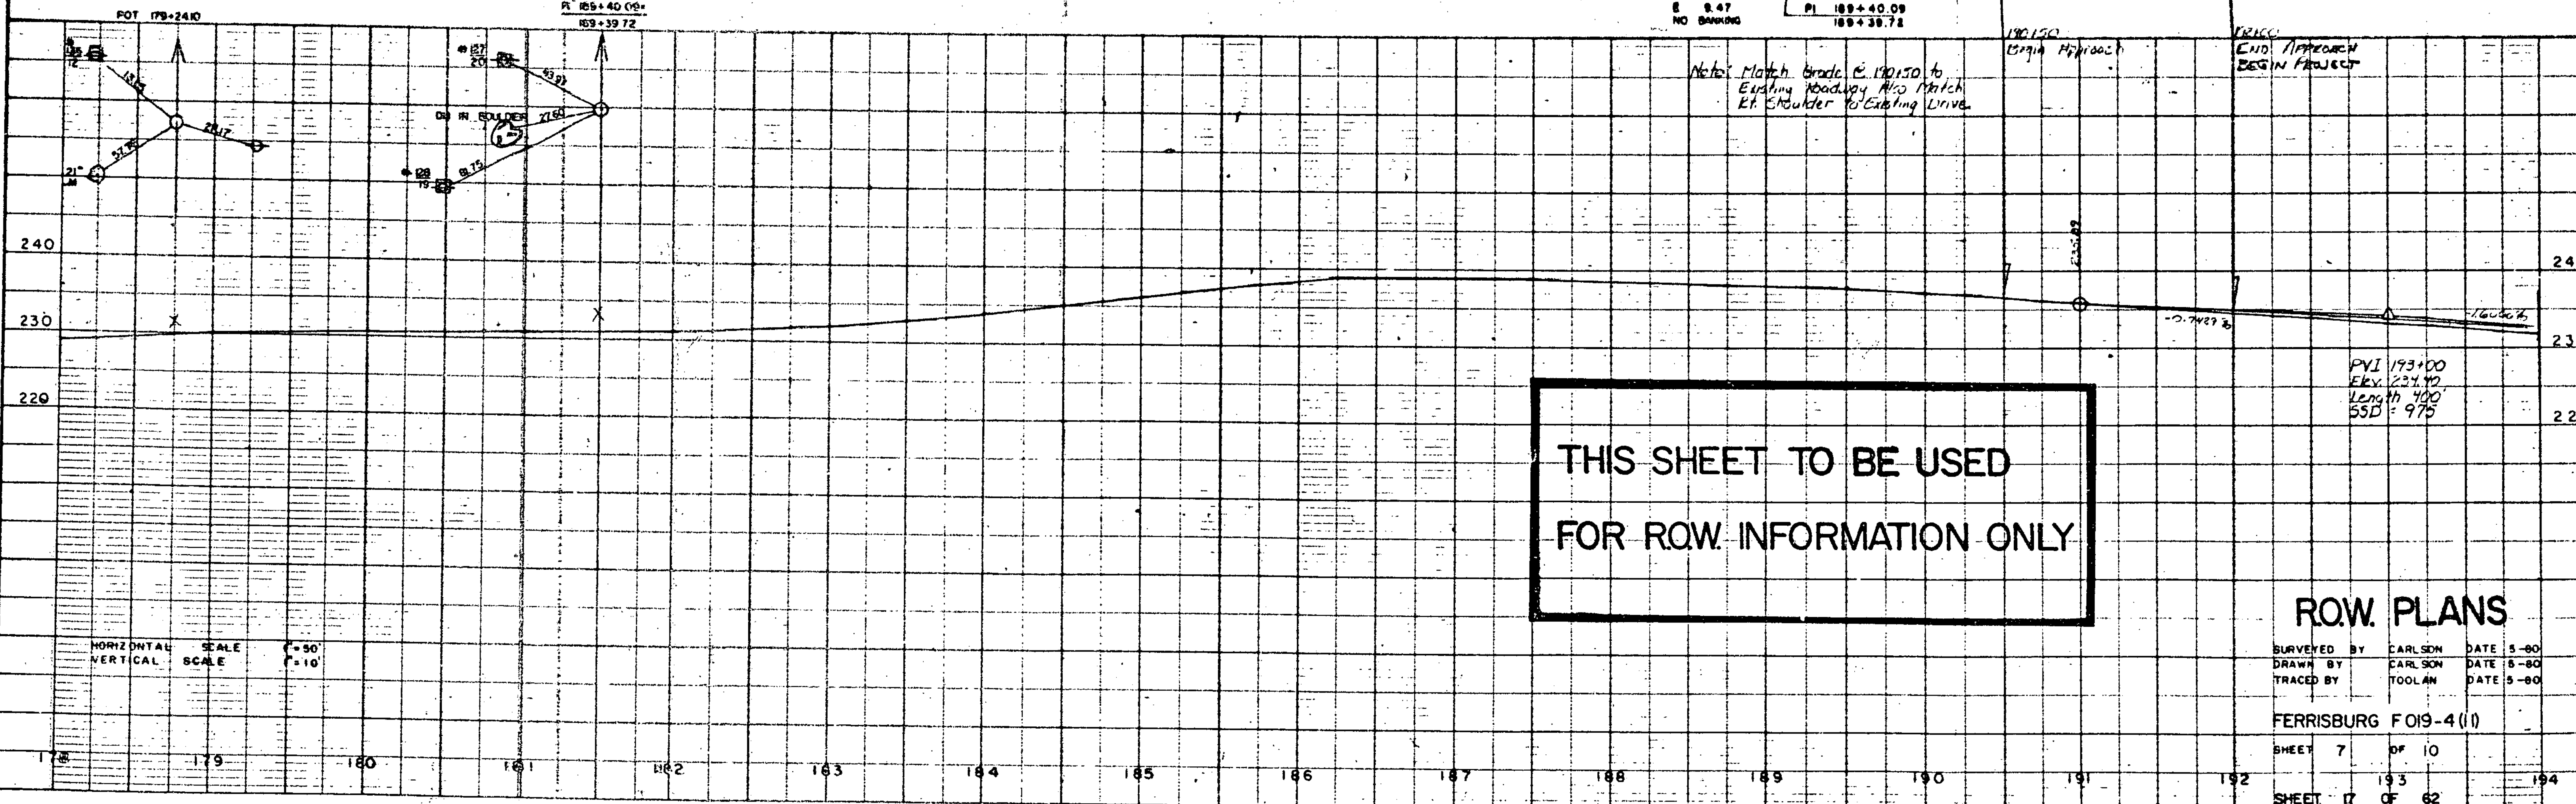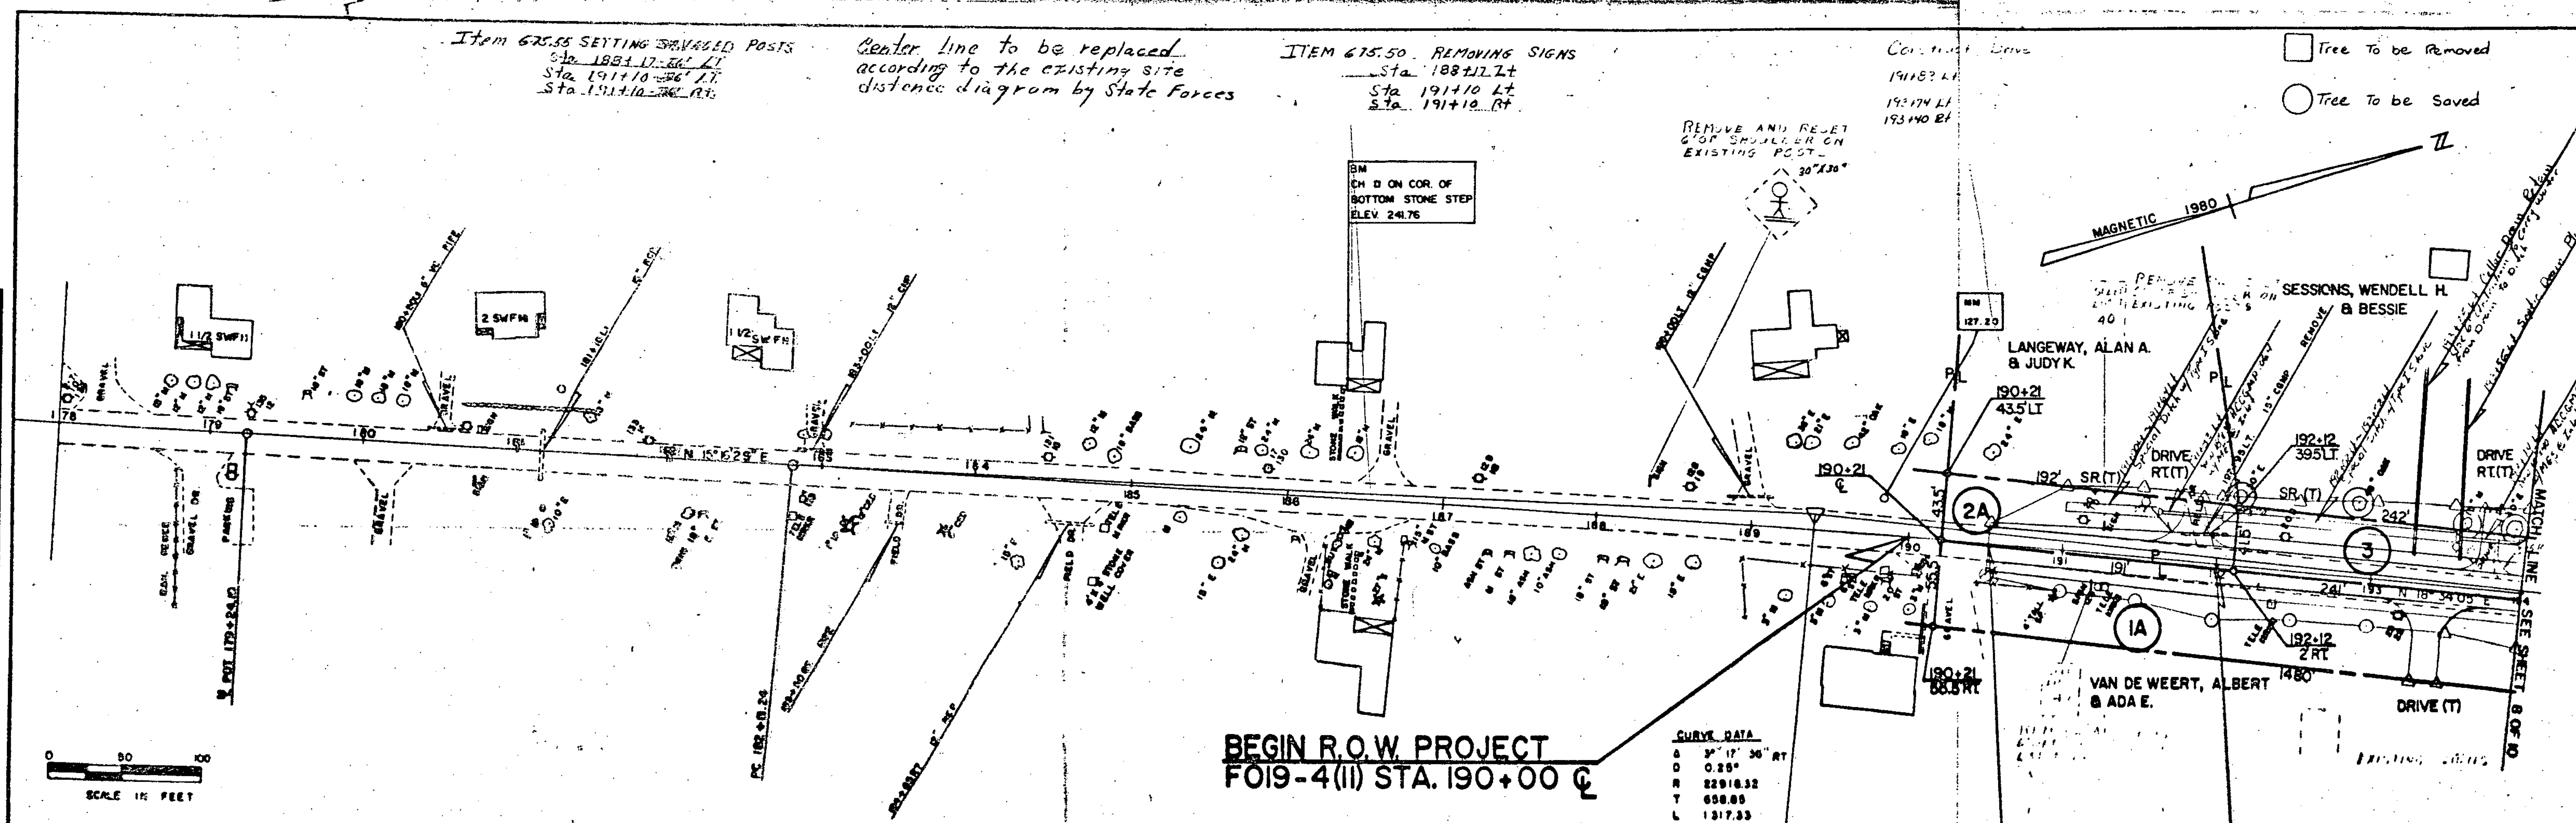

ROW PLANS

SURVEYED BY CARLSON DATE 5-80
DRAWN BY CARLSON DATE 5-80
TRACED BY TOOLAN DATE 5-80

FERRISBURG FO19-4(II)
SHEET 7 OF 10
SHEET 17 OF 62