


ITEM 675.50 REMOVING SIGNS
 STA 205+03 RT
 STA 205+03 LT
 STA 207+10 LT

ITEM 675.55 SETTING SALVAGED POSTS
 STA 205+03 RT
 STA 205+03 LT
 STA 207+10 LT

**THIS SHEET TO BE USED
 FOR ROW INFORMATION ONLY**

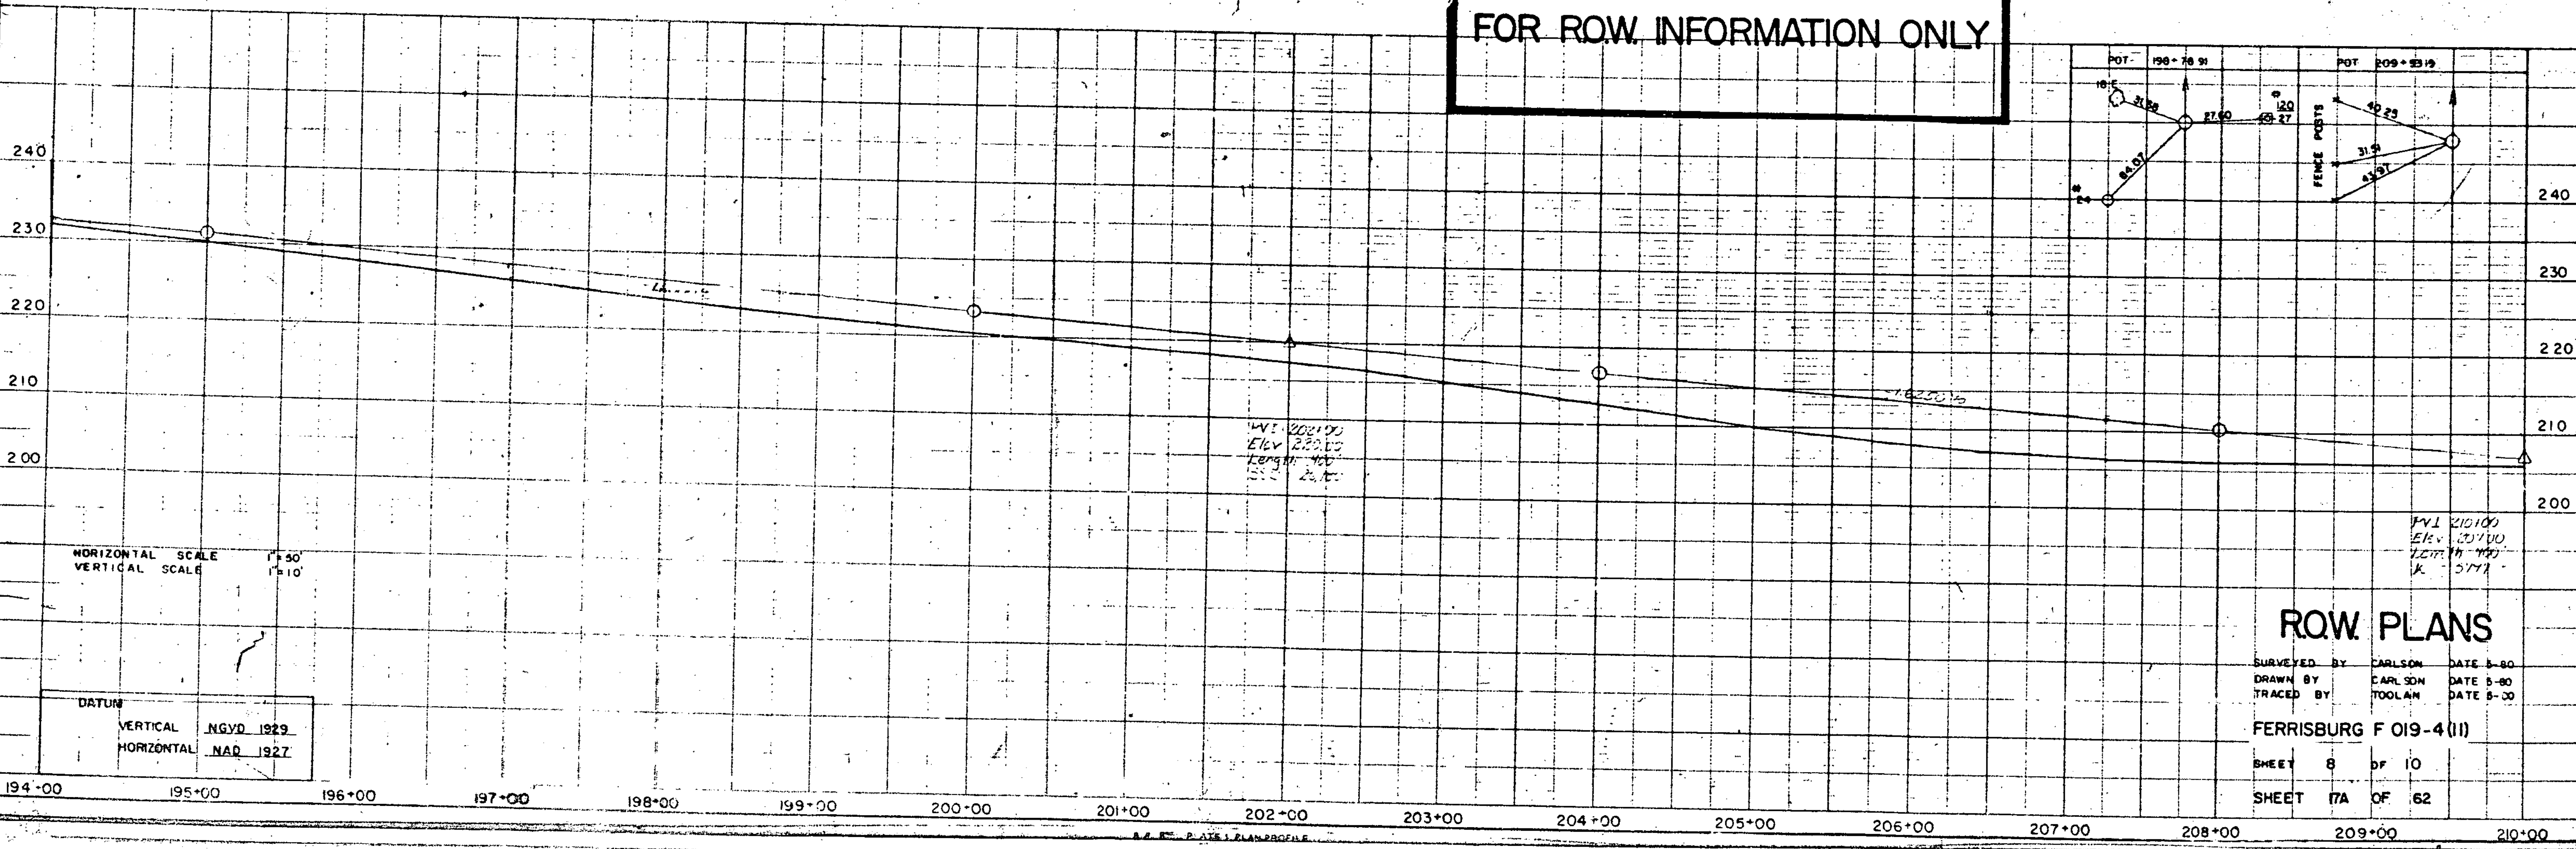

ROW PLANS

SURVEYED BY CARLSON DATE 5-80
 DRAWN BY CARLSON DATE 5-80
 TRACED BY TOOLAN DATE 5-80

FERRISBURG F 019-4 (II)

SHEET 8 OF 10
 SHEET 17A OF 62

PLAN
 NOTE BOOK

PROFILE
 NOTE BOOK