

- Tree to be Saved
- Tree to be Removed

Item 675.50 REMOVING SIGNS Sta 218+16 RT  
 Item 675.55 SETTING SALVAGED POST Construct Drive Sta 218+18 26 RT  
 Scouring Existing Pavement 215+00 - 220+00

- 219+50 RT
- 221+16 RT
- 222+92 RT
- 223+77 RT
- 224+41 RT
- 224+45 LT

LANGEWAY, ALAN A. & JUDY K.

LANGEWAY, ALAN A. & JUDY K.

LANGEWAY, ALAN A. & JUDY K.

GEBO, ADRIEN J. & NORA R.

SMITH, LOREN M.



COSGROVE, ROBERT F. & CONSTANCE M.

VAN DE WEERT, KENNETH A. & MARILYN

VAN DE WEERT, ALBERT & ADA E.

PLAN
DATE
BY
CHECKED
APPROVED
DATE
BY
CHECKED
APPROVED
DATE
BY
CHECKED
APPROVED
DATE

PROFILE
DATE
BY
CHECKED
APPROVED
DATE
BY
CHECKED
APPROVED
DATE
BY
CHECKED
APPROVED
DATE

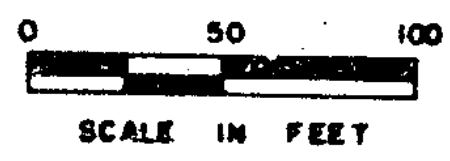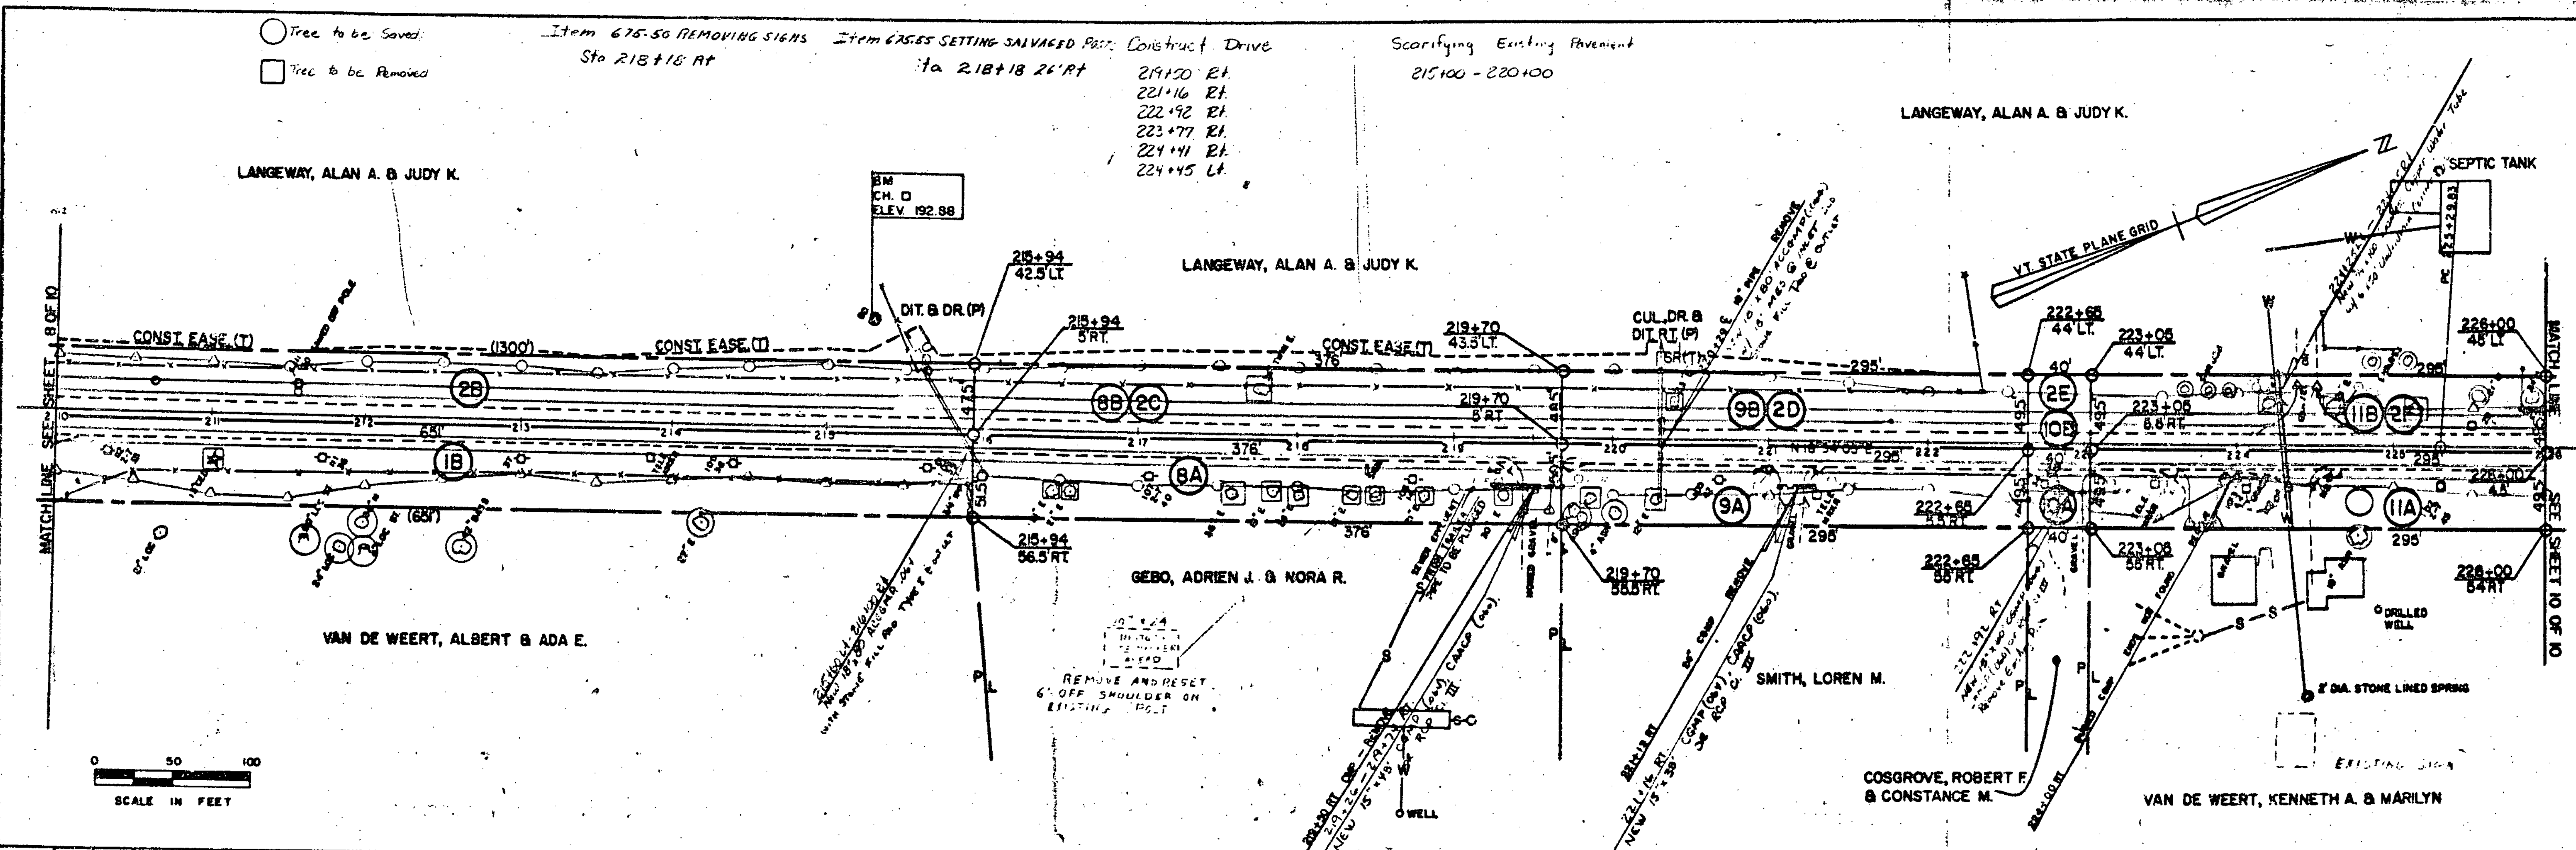

THIS SHEET TO BE USED FOR ROW INFORMATION ONLY



ROW PLANS

SURVEYED BY CARLSON DATE 5-60  
 DRAWN BY CARLSON DATE 5-60  
 TRACED BY TOULAN DATE 5-60

FERRISBURG FO19-4 (II)

SHEET 9 OF 10

SHEET 18 OF 32

HORIZONTAL SCALE 1" = 50'  
 VERTICAL SCALE 1" = 10'

DATUM  
 VERTICAL NAD 1927  
 HORIZONTAL NAD 1927