


Tree to be saved Item 675.50 REMOVING SIGNS ITEM 5000 SETTING OF LAPPED POSTS Construct Drive
 Tree to be removed Sta. 231+20.00 Sta. 231+20'-26" RT. Sta. 228+60 RT
 227+139 Lt.


THE ROWLAND E. ROBINSON MEMORIAL ASSOCIATION, INC.

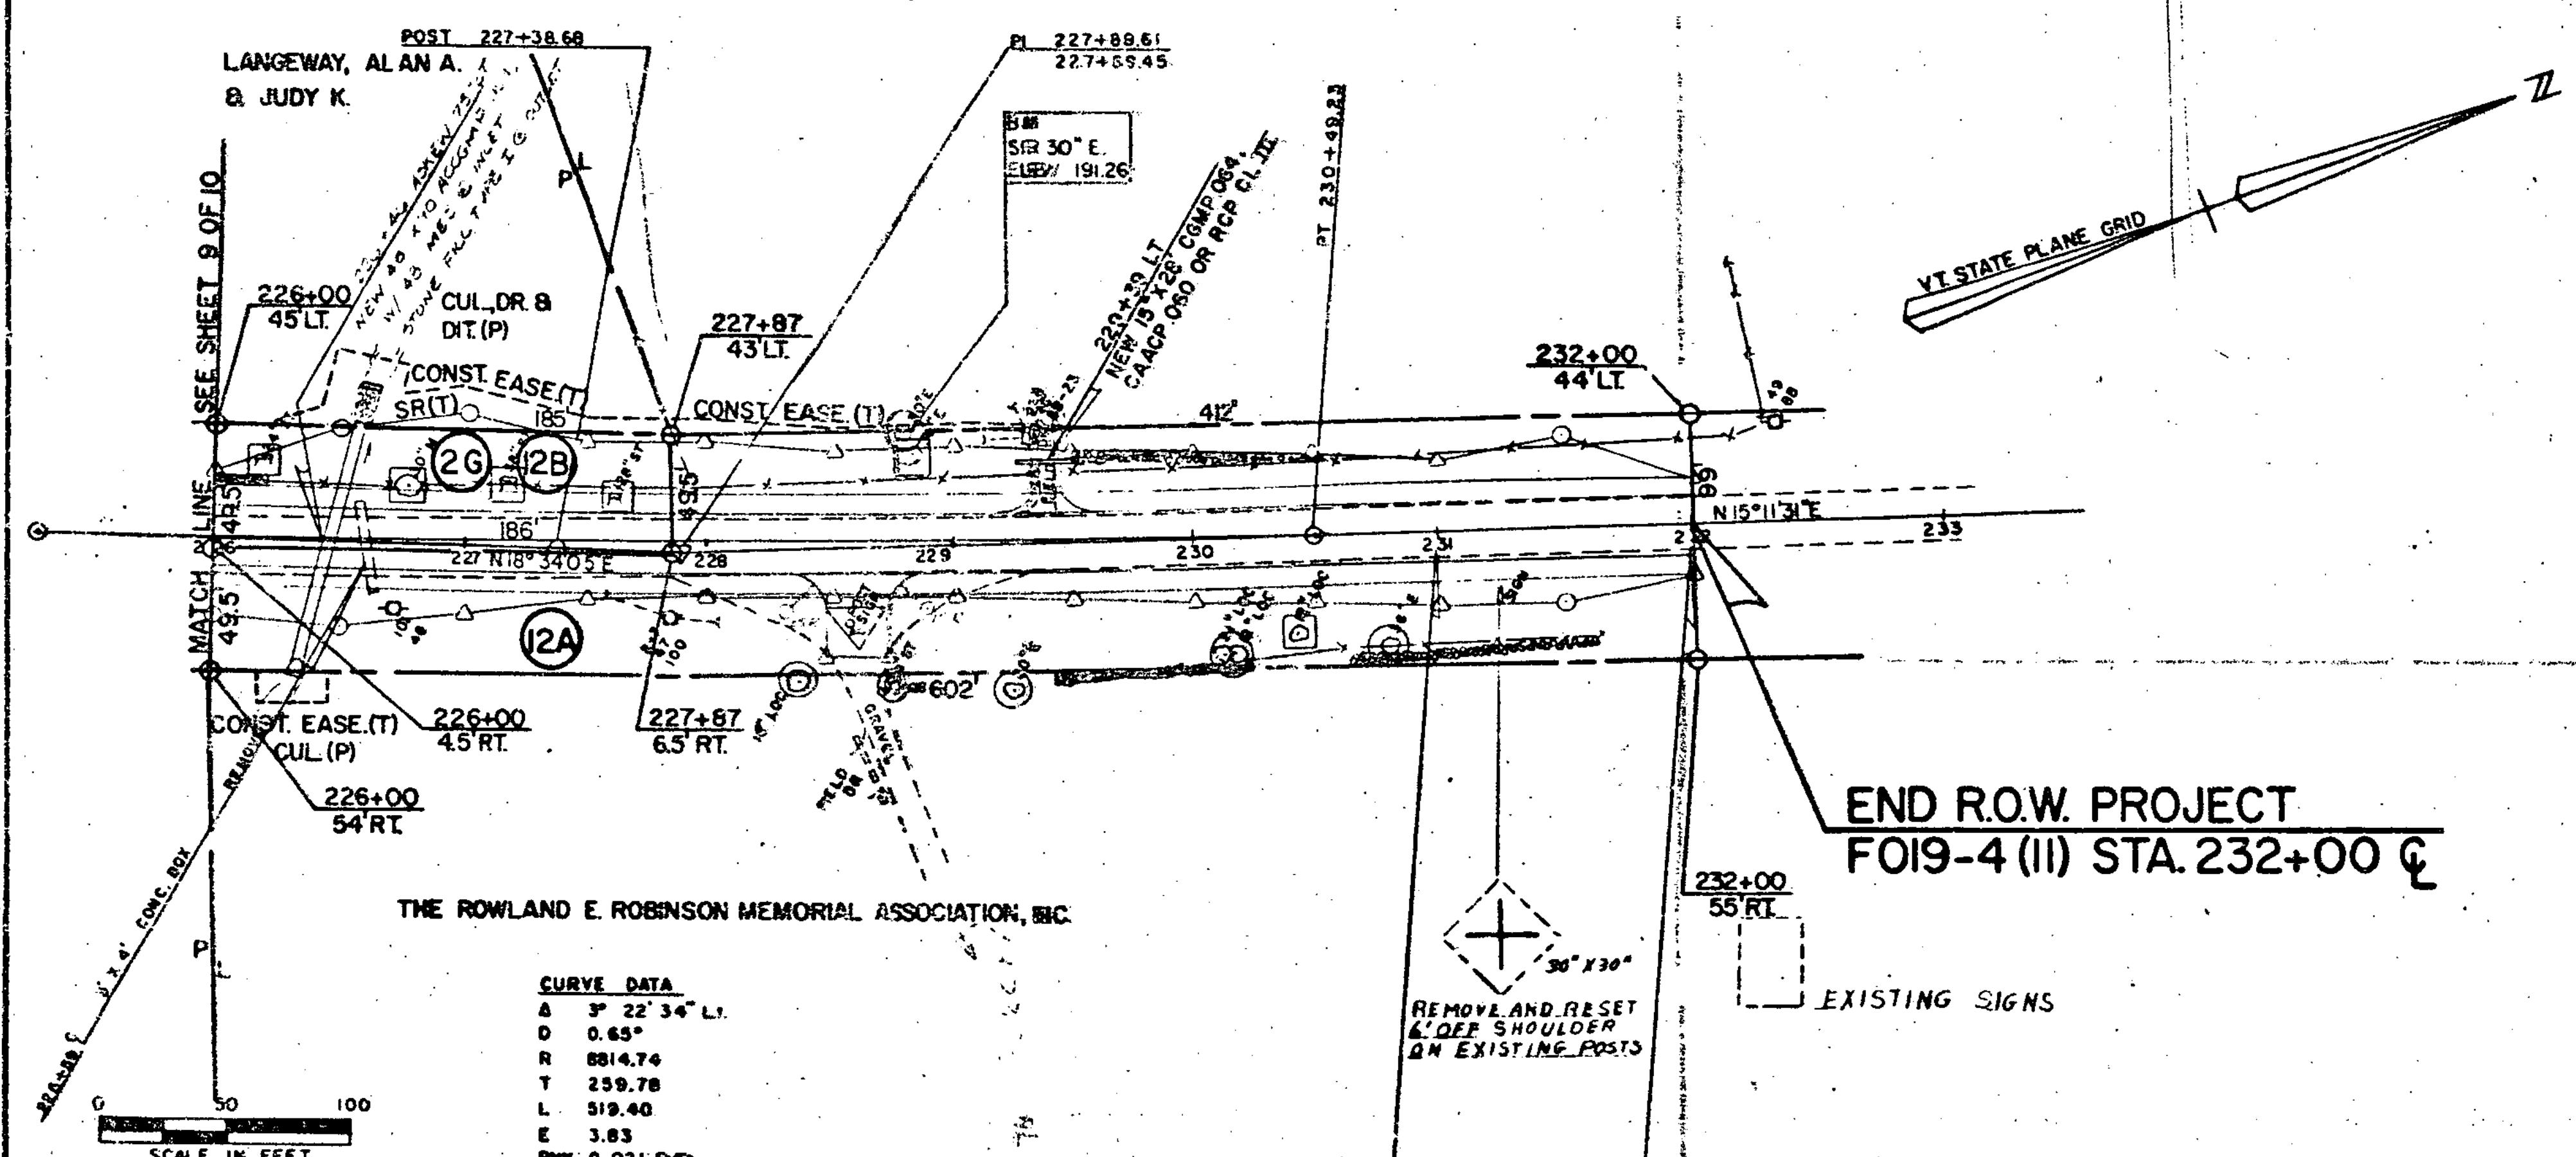

CURVE DATA

A	3° 22' 34" Lt.
D	0.65°
R	8814.74
T	259.78
L	519.40
E	3.83
BKX	0.021 PVI


END R.O.W. PROJECT
FOI9-4 (II) STA. 232+00 C

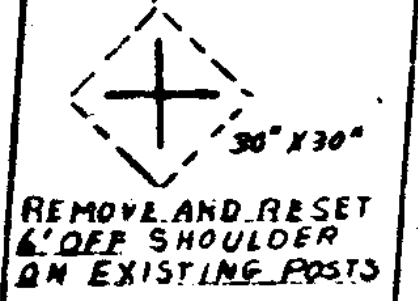

EXISTING SIGNS

PLAN
 SURVEYOR
 DATE
 NOTE BOOK
 NO.

PROFILE
 SURVEYOR
 DATE
 NOTE BOOK
 NO.

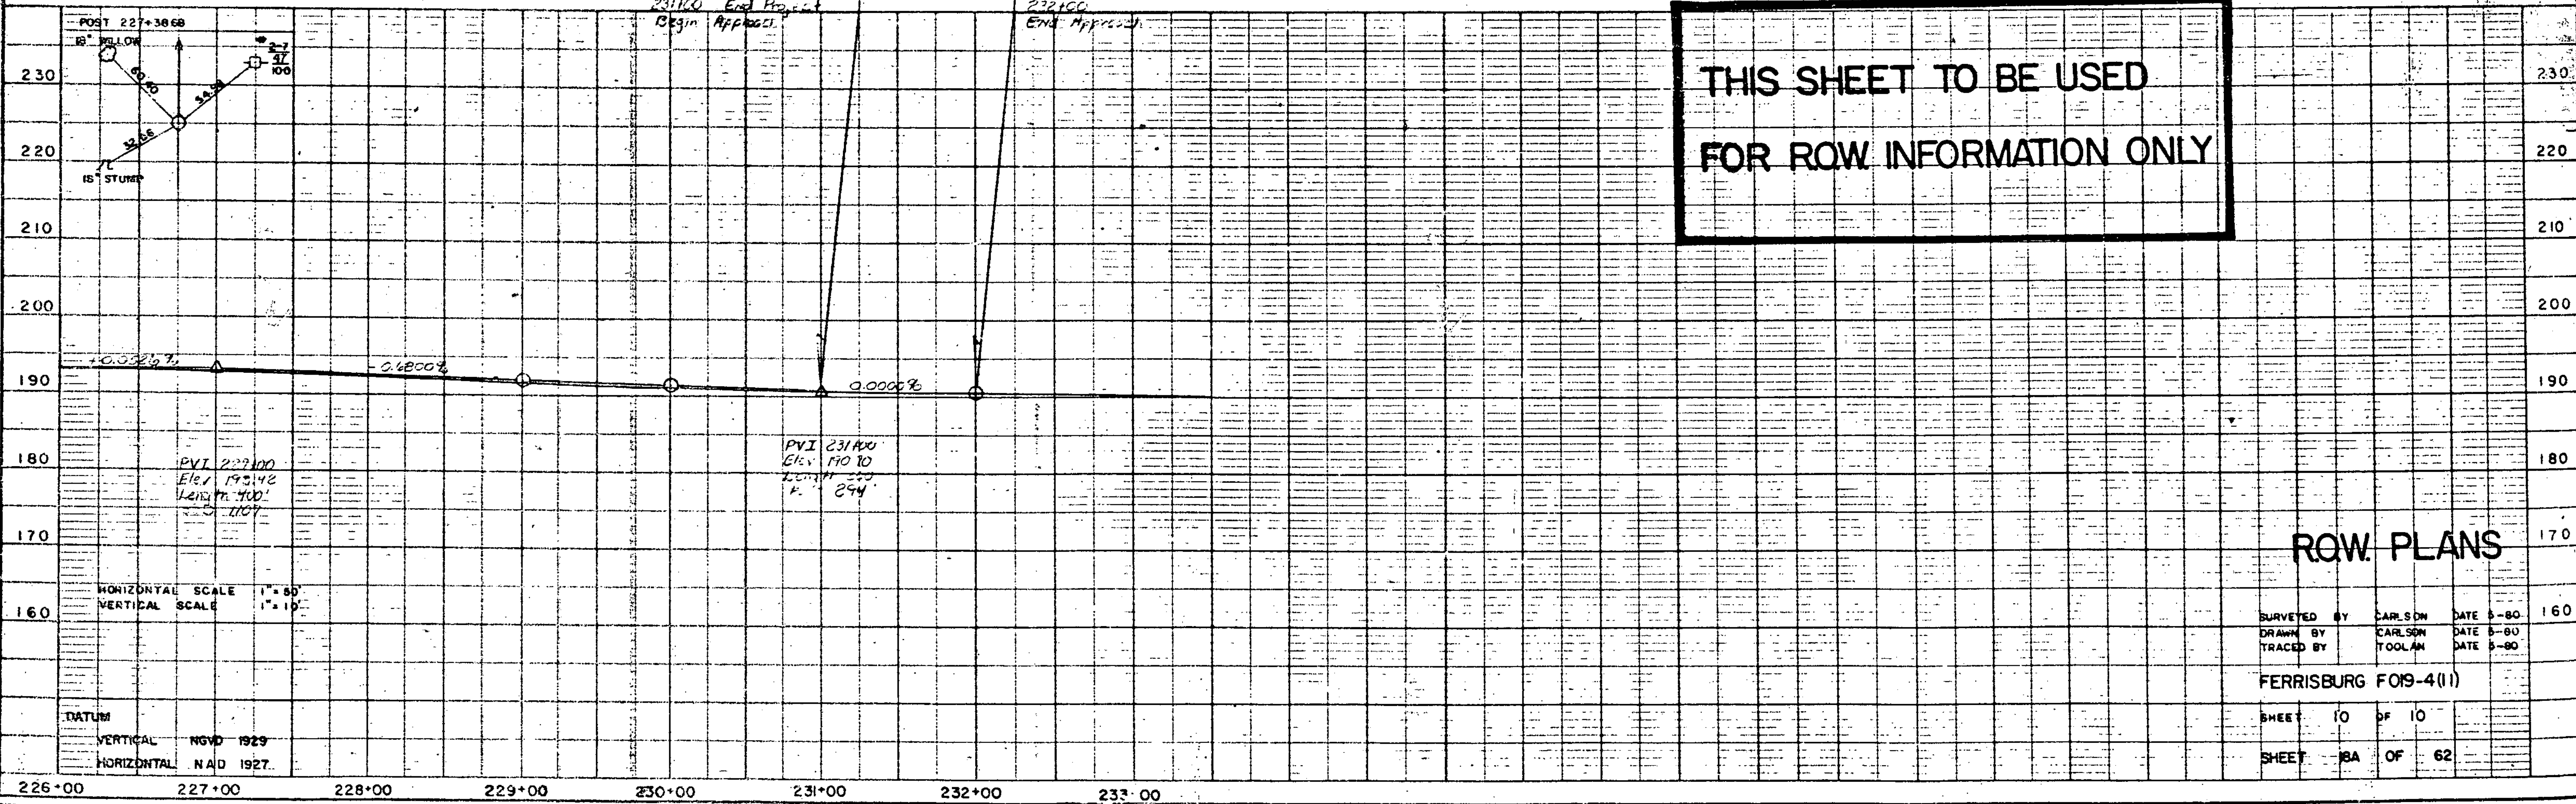

ROW PLANS

SURVEYED BY CARLSON DATE 8-80
 DRAWN BY CARLSON DATE 8-80
 TRACED BY TOOLAN DATE 8-80

FERRISBURG FOI9-4(II)

SHEET 10 OF 10

SHEET 18A OF 62