


12' 10' 12'

60'

11' 10'

11' 10' 11' 6"
width transition $r=10'$

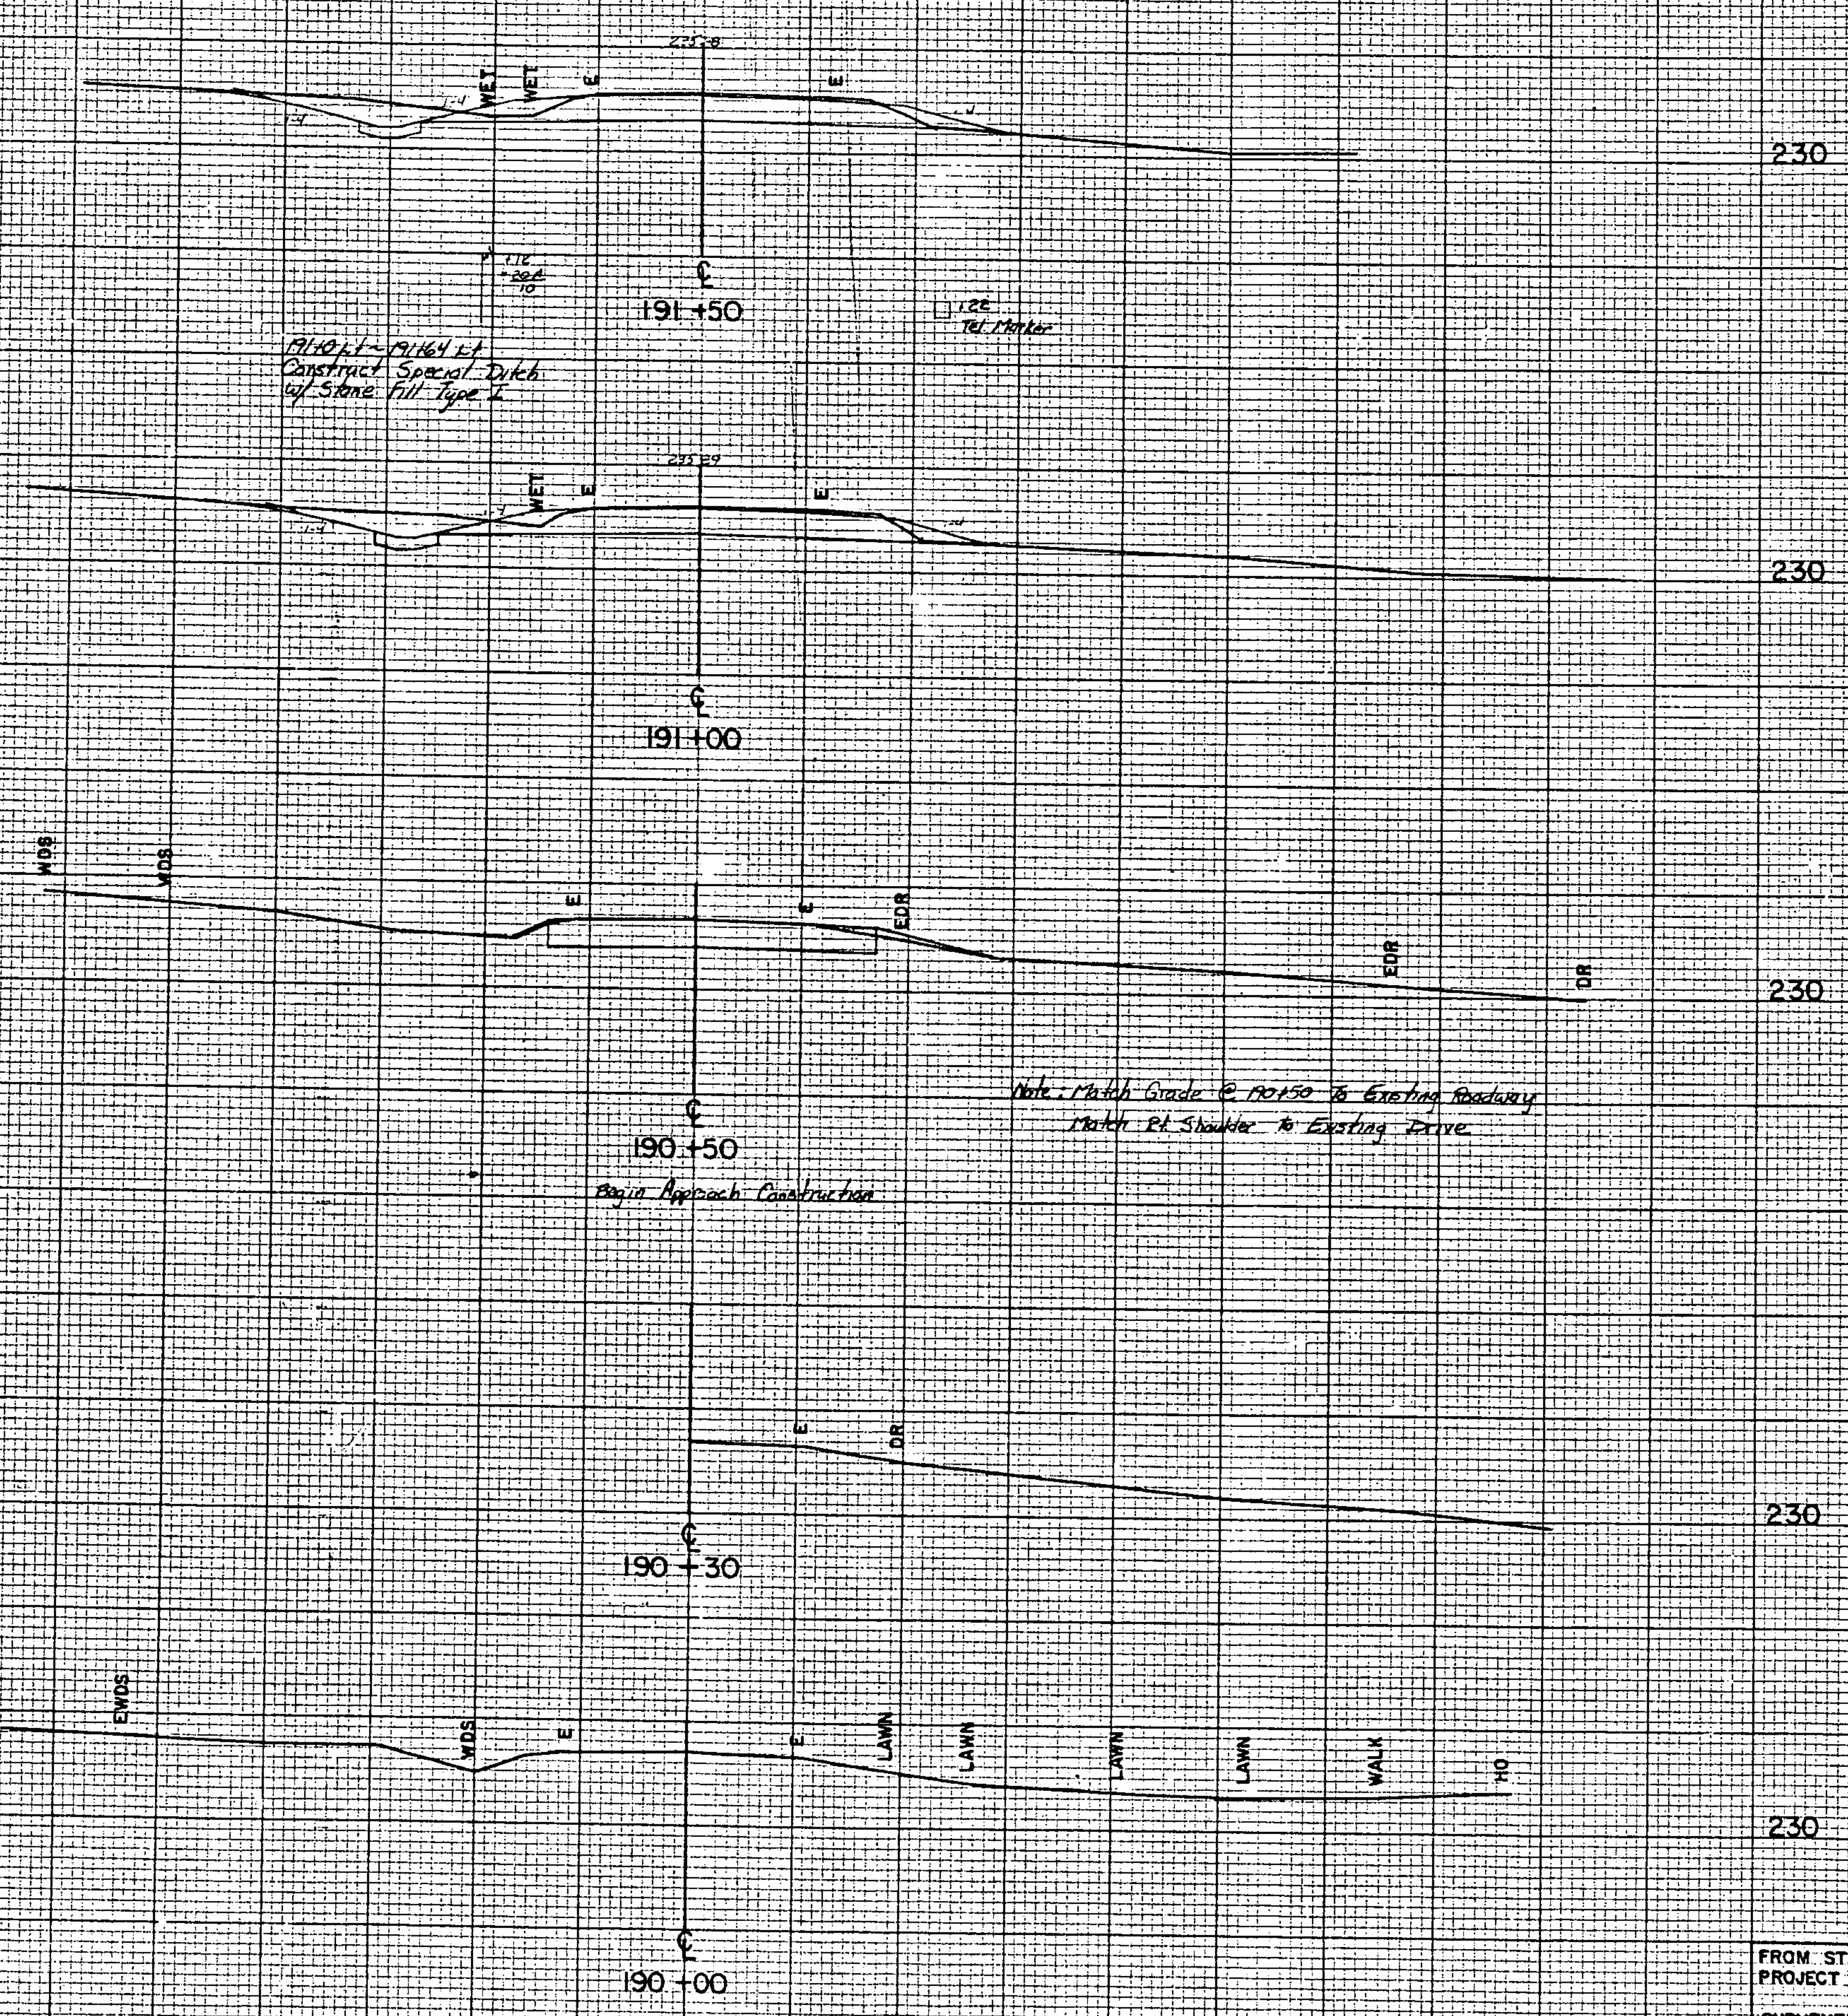

FROM STA.	190+00	TO STA.	191+50
PROJECT NAME	FERRISBURG M/L		
NO.	F EGG F 019-4 (II)		
SURVEYED BY	CARLSON	PLOTTED	5/27/80
SHEET	19 OF 62	SHEETS	4/80

SCALE 1" = 10'