

Note: Septic Drain @ 193+65 H
 To be placed w/ concrete Pipe
 To be Subsidiary To be Other
 Drainage Items.

Note: Catch Drain @ 192+25 H
 Use 10" Up-bow to carry water
 From Drains to ditch


193+40 H
 Construct 16' Gravel Drive

192+02 H - 193+52 H
 Construct Special Ditch
 w/ Type X Shore Fill

191+95 H
 Remove Existing 15' CBMP

192+00
 End Approach
 Begin Project
 FEGC P 019-4(U)

191+82 H
 Construct 10' Gravel Drive
 Also 18" x 30" Access Pipe w/
 M.E.C. T-4

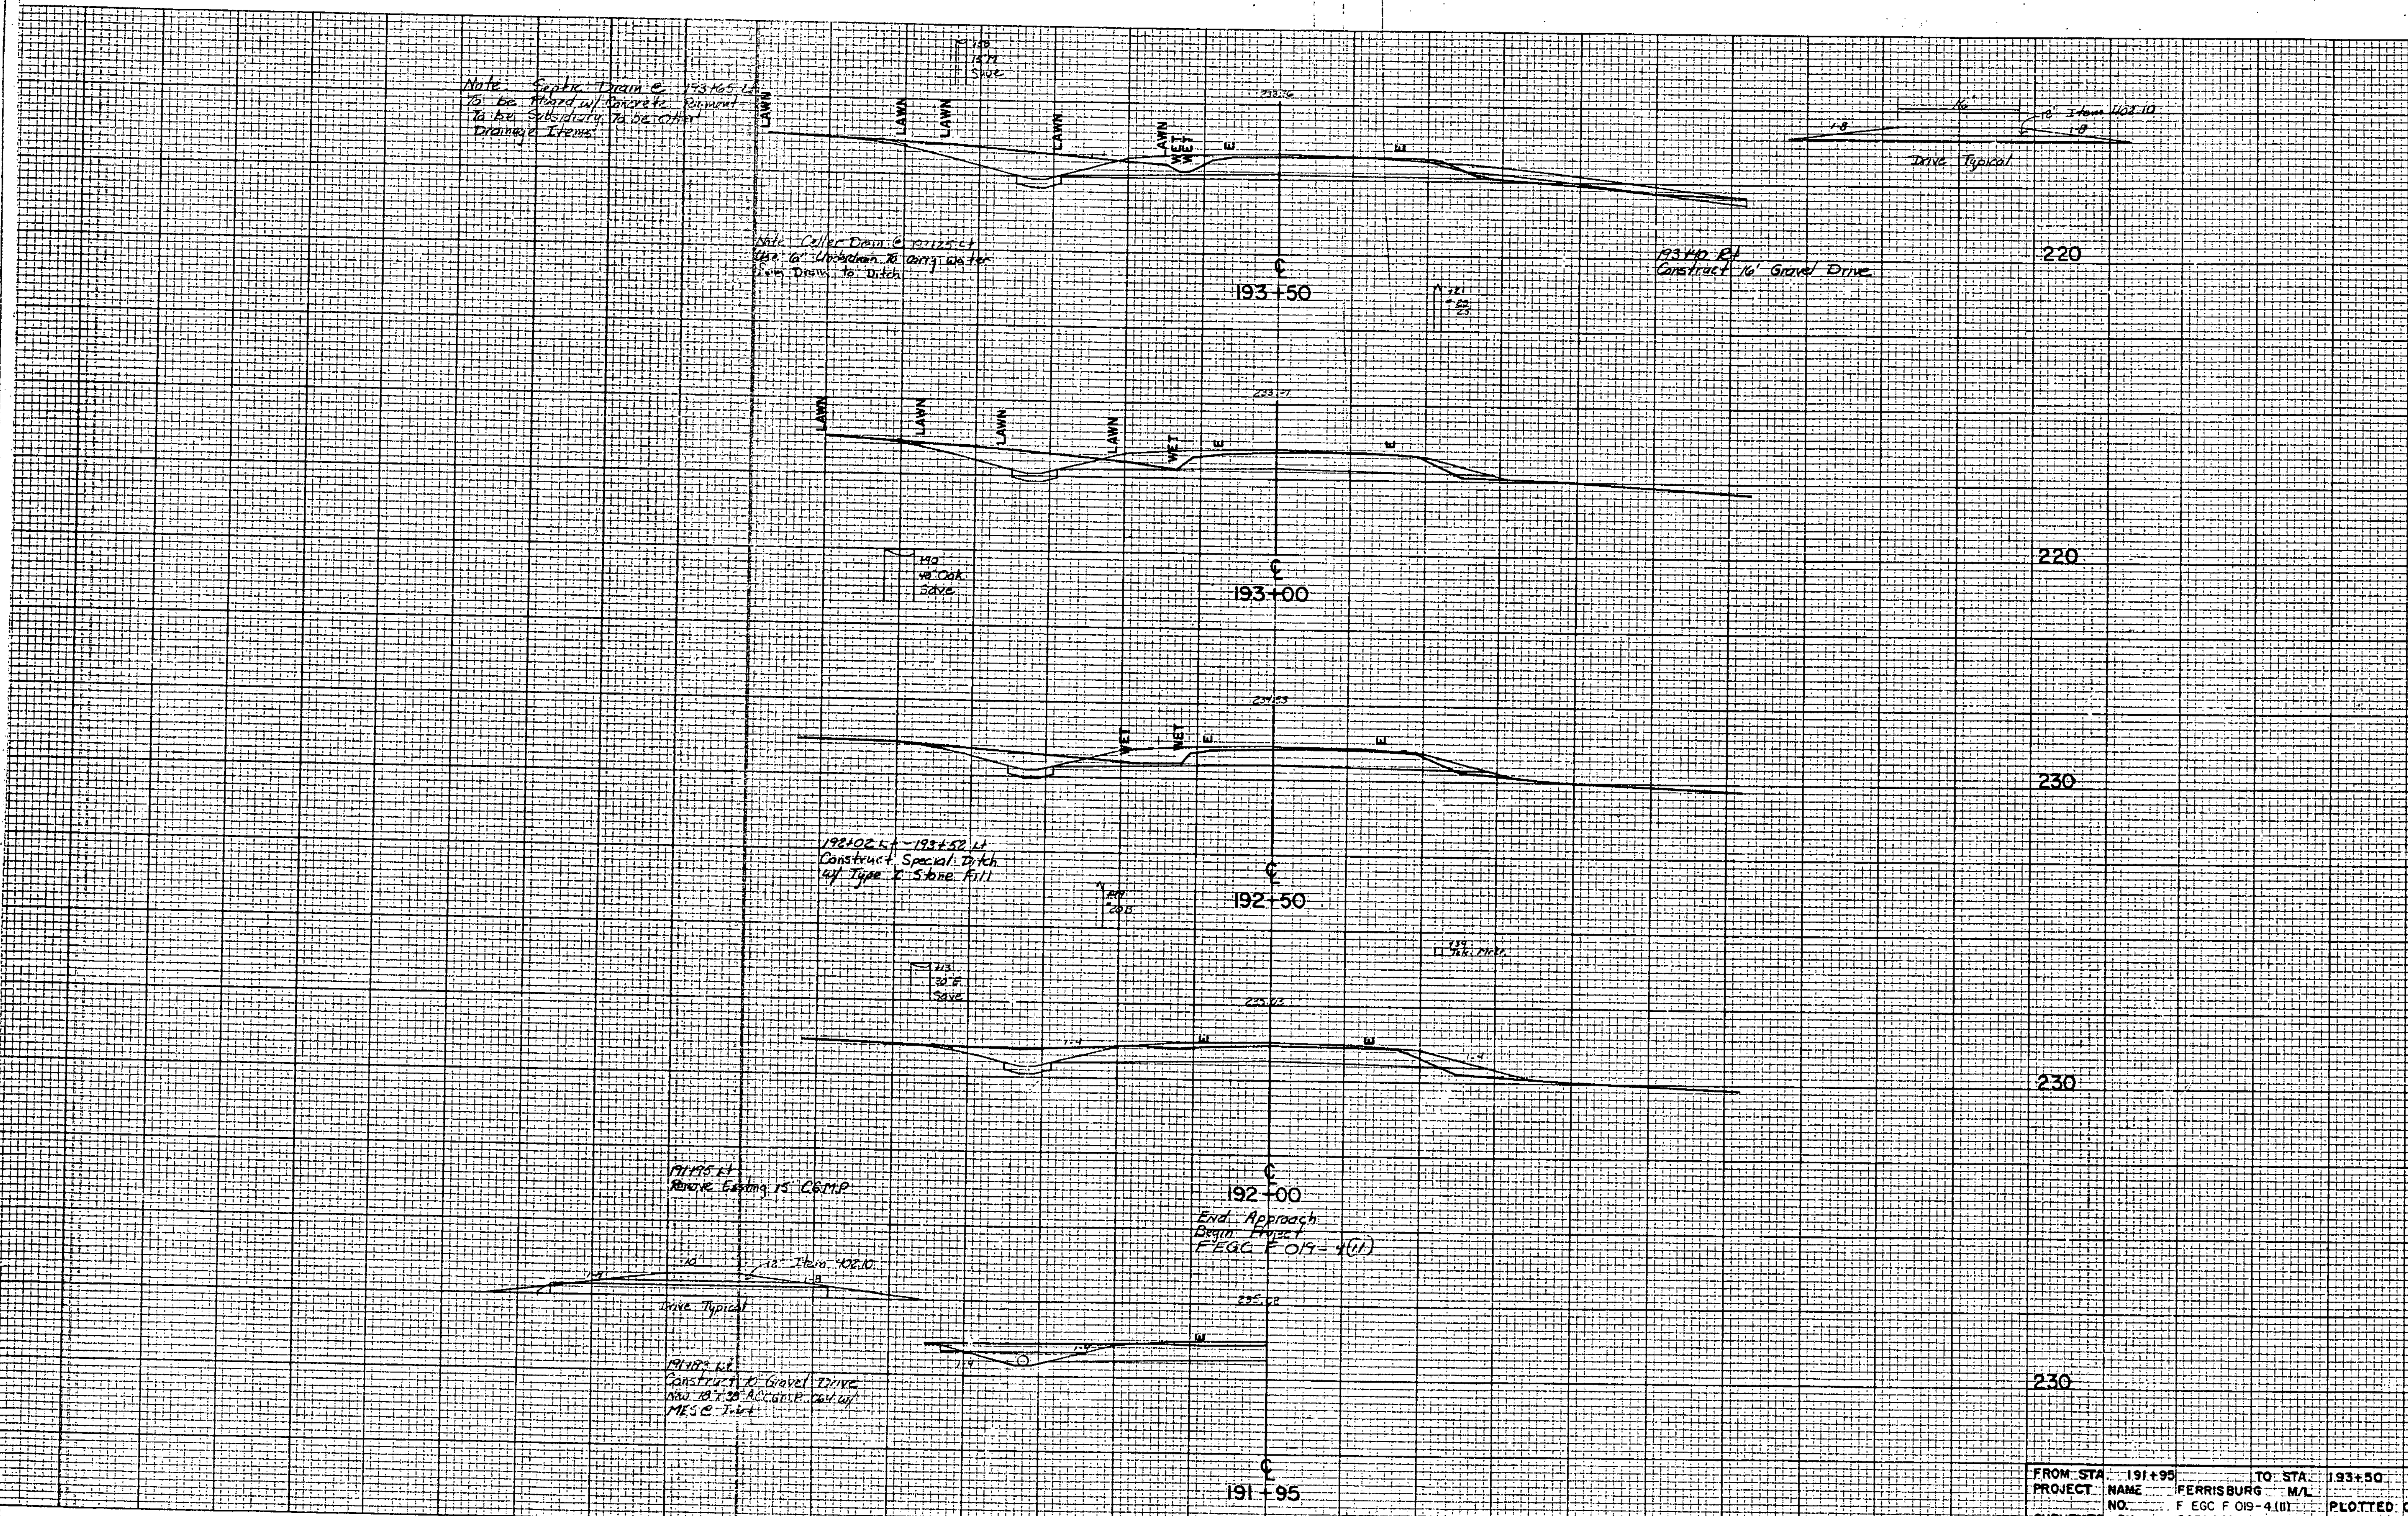

FROM STA	191+95	TO STA	193+50
PROJECT NAME	FERRISBURG M/L		
NO.	F EGC F 019-4(U)	PLOTTED	05/27/80
SURVEYED BY	CARLSON		4/80
SHEET	20	OF 62 SHEETS	

SCALE 1" = 10'