


197+50  
Begin Scarifying Existing Pavement

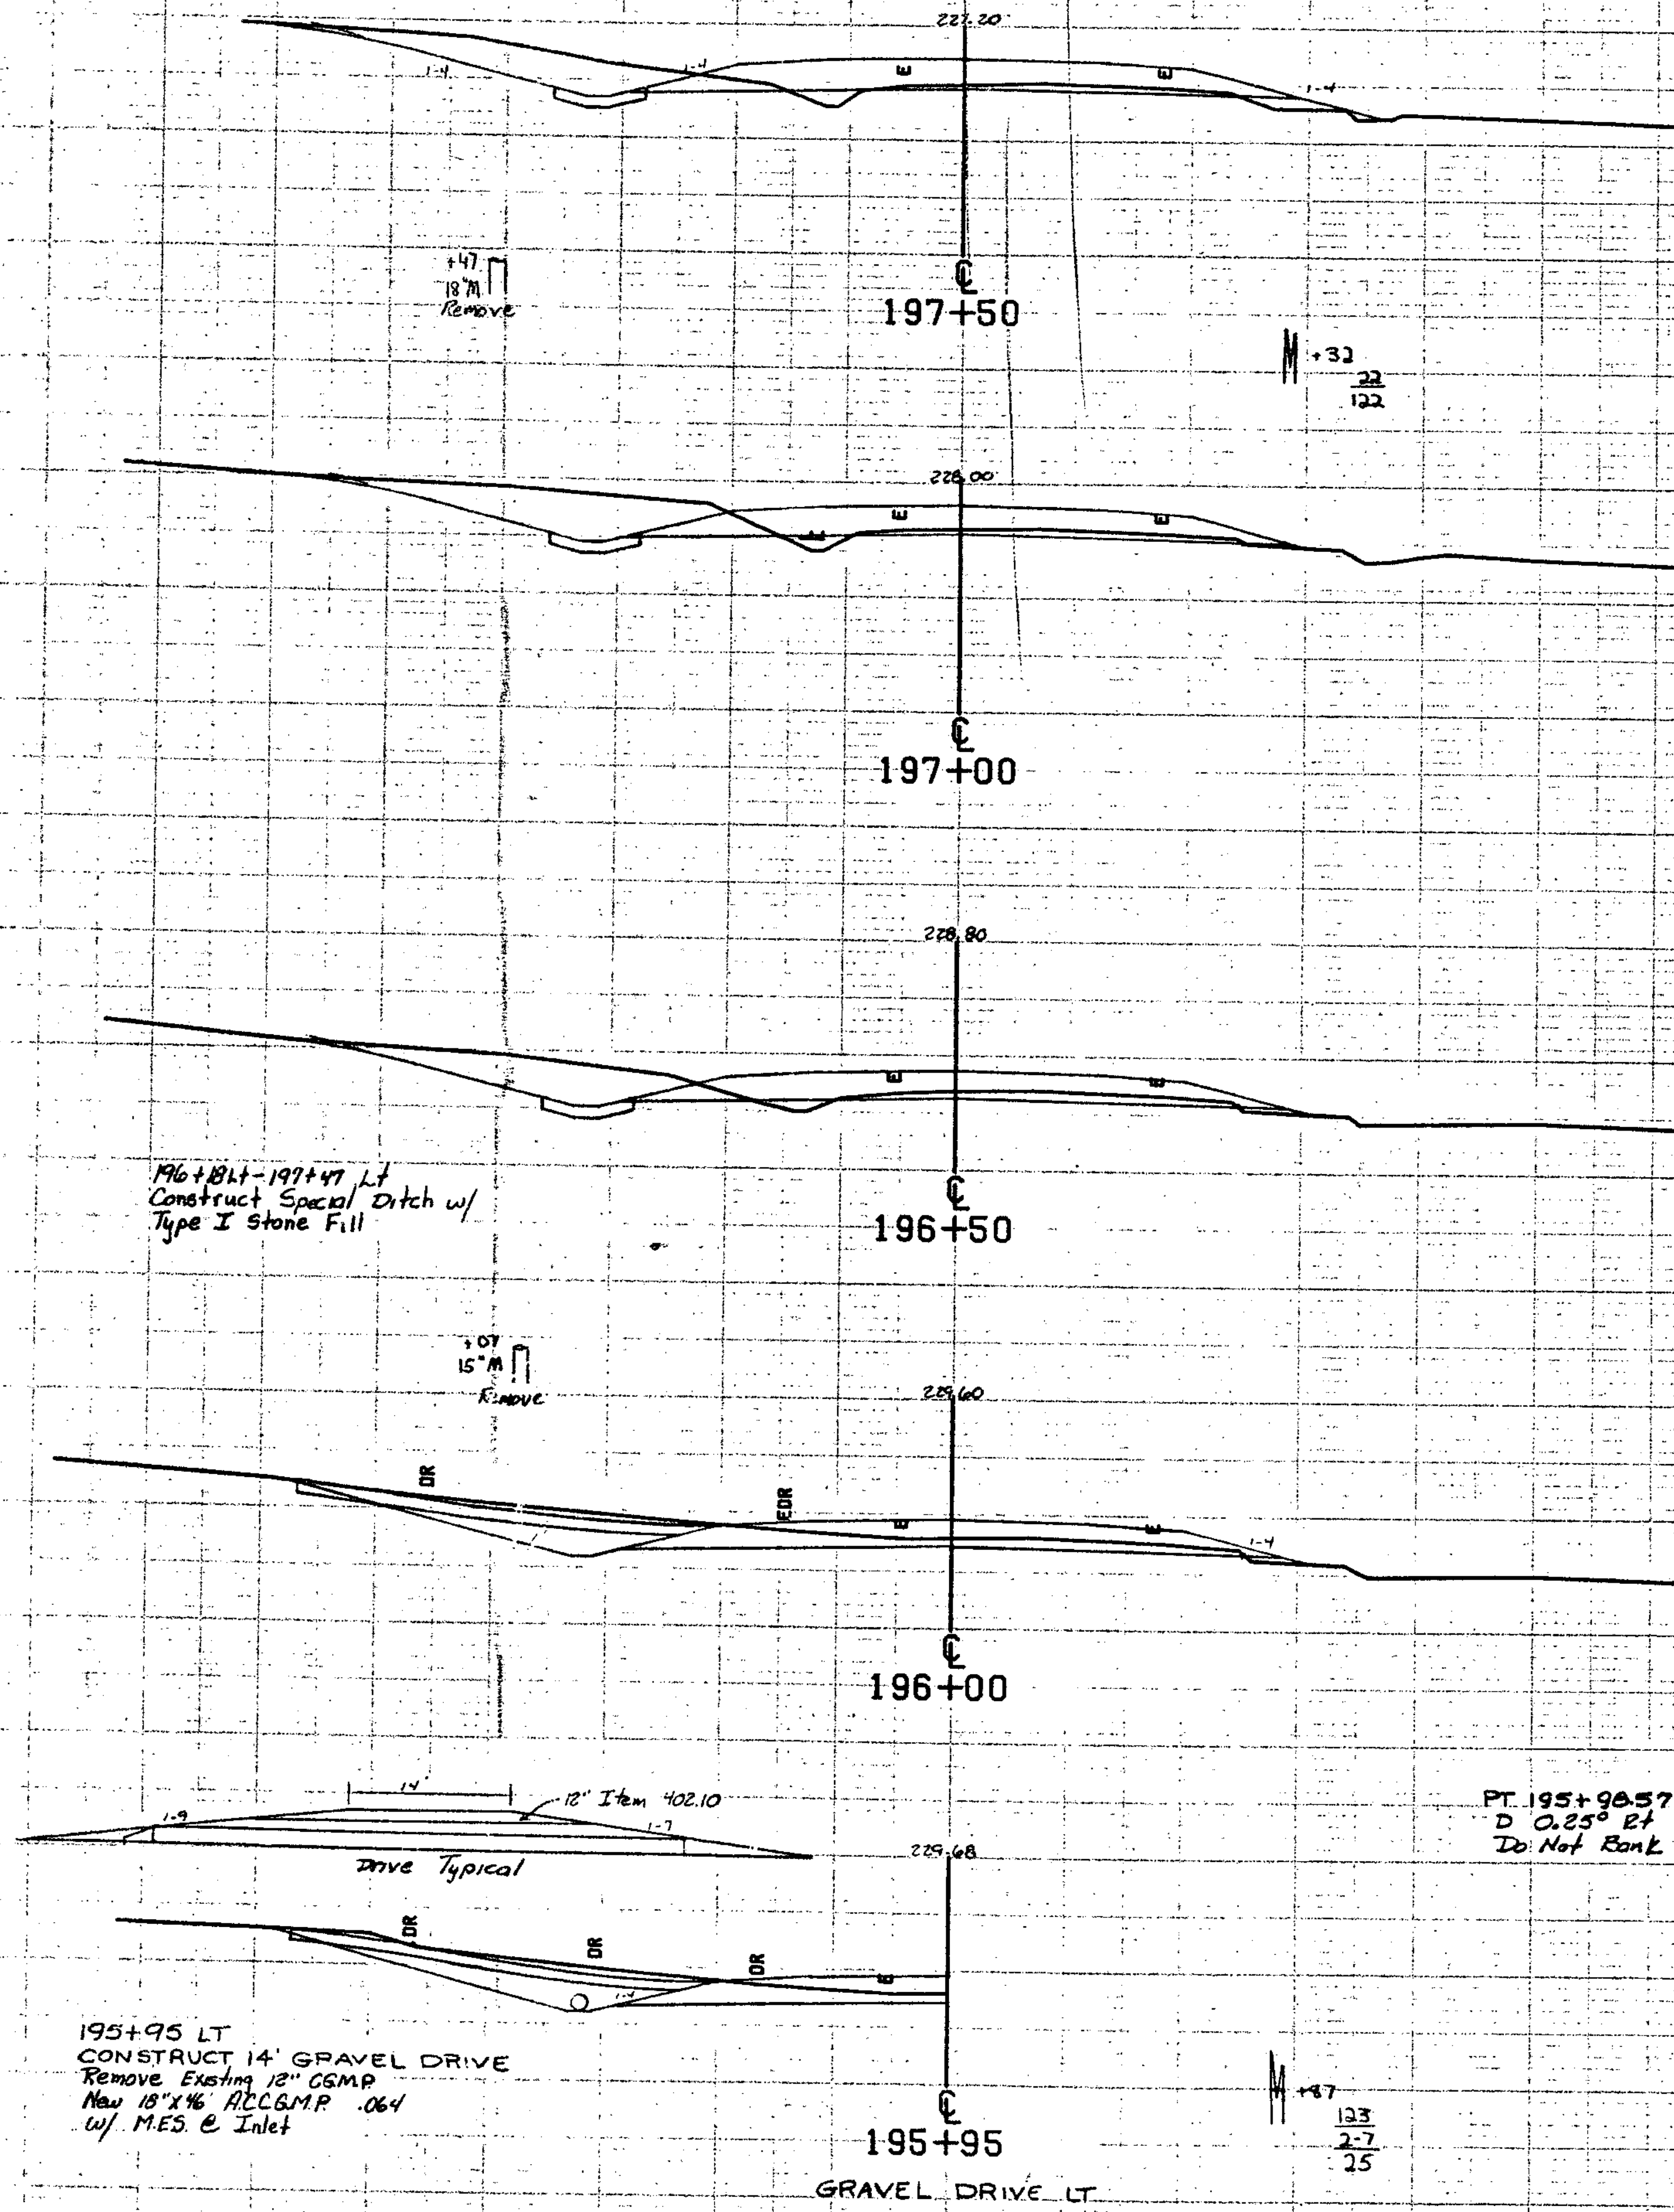

220

220

196+181-197+47 LT  
Construct Special Ditch w/  
Type I Stone Fill

PT. 195+98.57  
D 0.25° BT  
Do Not Bank

195+95 LT  
CONSTRUCT 14' GRAVEL DRIVE  
Remove Existing 12" GSMP  
New 18" x 1/4" ACCGMP .064  
w/ M.E.S. & Inlet

GRAVEL DRIVE LT

FROM STA. 195+95	TO STA. 197+50
PROJECT NAME	FERRISBURG M/L
NO.	F ECG F019-4(II)
SURVEYED BY	CARLSON
SHEET 22 OF 62 SHEETS	PLOTTED 05/27/80 APRIL 1980

SCALE 1" = 10 FEET