


197+87 LT - 200+36 LT
 Construct Special Ditch w/
 Type I Stone Fill

197+68 LT
 CONSTRUCT 14' GRAVEL DRIVE
 REMOVE EXISTING 12" CGMP
 NEW 18" X 38" RCC CMP, 064
 w/ MES & JWB

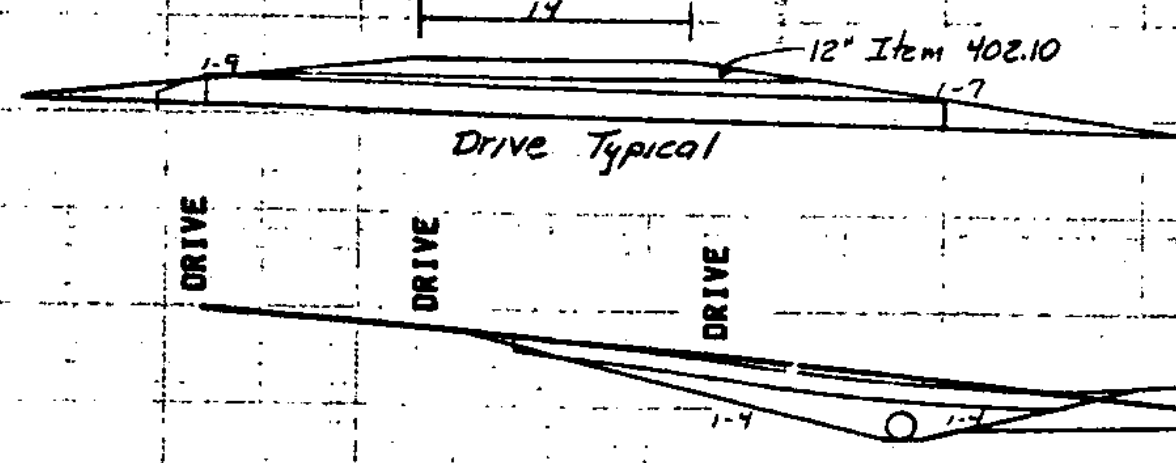

210

220

210

220

220

199+50

199+00

198+50

198+00

197+68

GRAVEL DRIVE LT

FROM STA. 197+68	TO STA. 199+50
PROJECT NAME	FERRISBURG M/L
NO.	F EGC F 019-4(11)
SURVEYED BY	CARLSON
SHEET 23 OF 62 SHEETS	PLOTTED 05/27/80 APRIL 1980

SCALE 1" = 10 FEET