


206+08 LT  
 CONSTRUCT 12' GRAVEL DRIVE  
 Existing 18" Drive Pipe Remove  
 New 24" HD ACCGMP 264 w/  
 MES @ Inlet

213.37  
 206+08  
 GRAVEL DRIVE LT


200

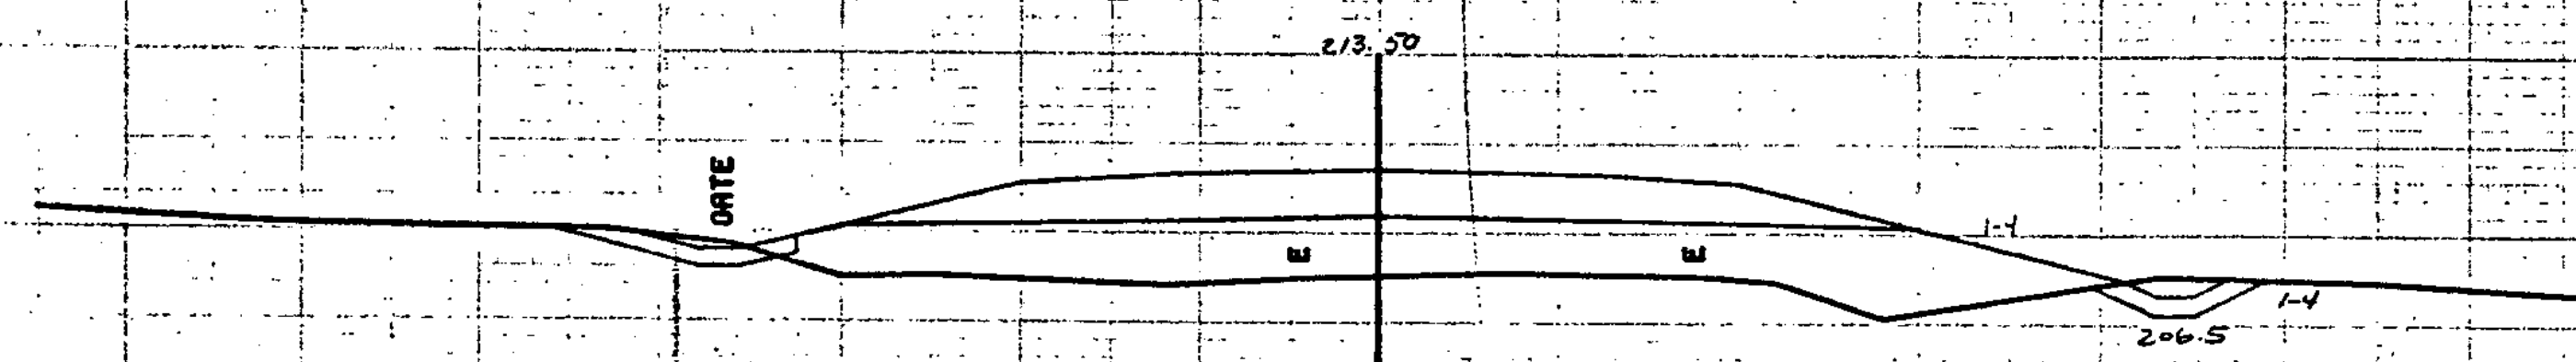

213.29  
 206+00


200

□+77  
 Tele. Inlet

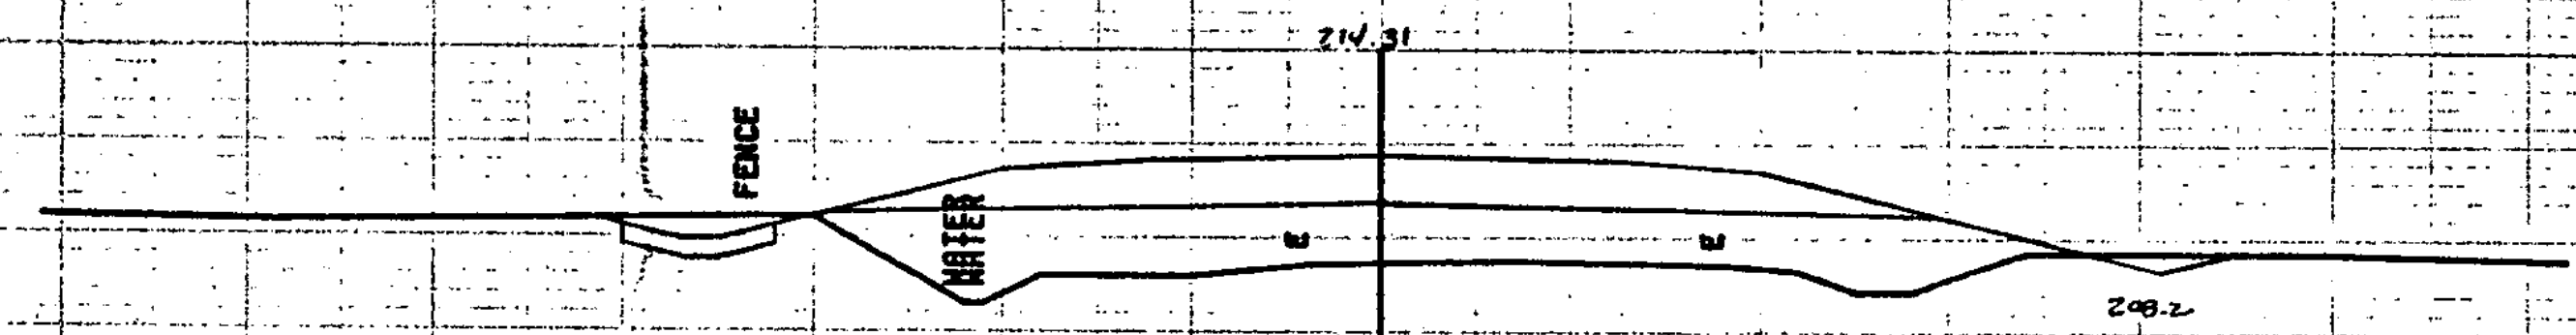

214.31  
 205+50


200

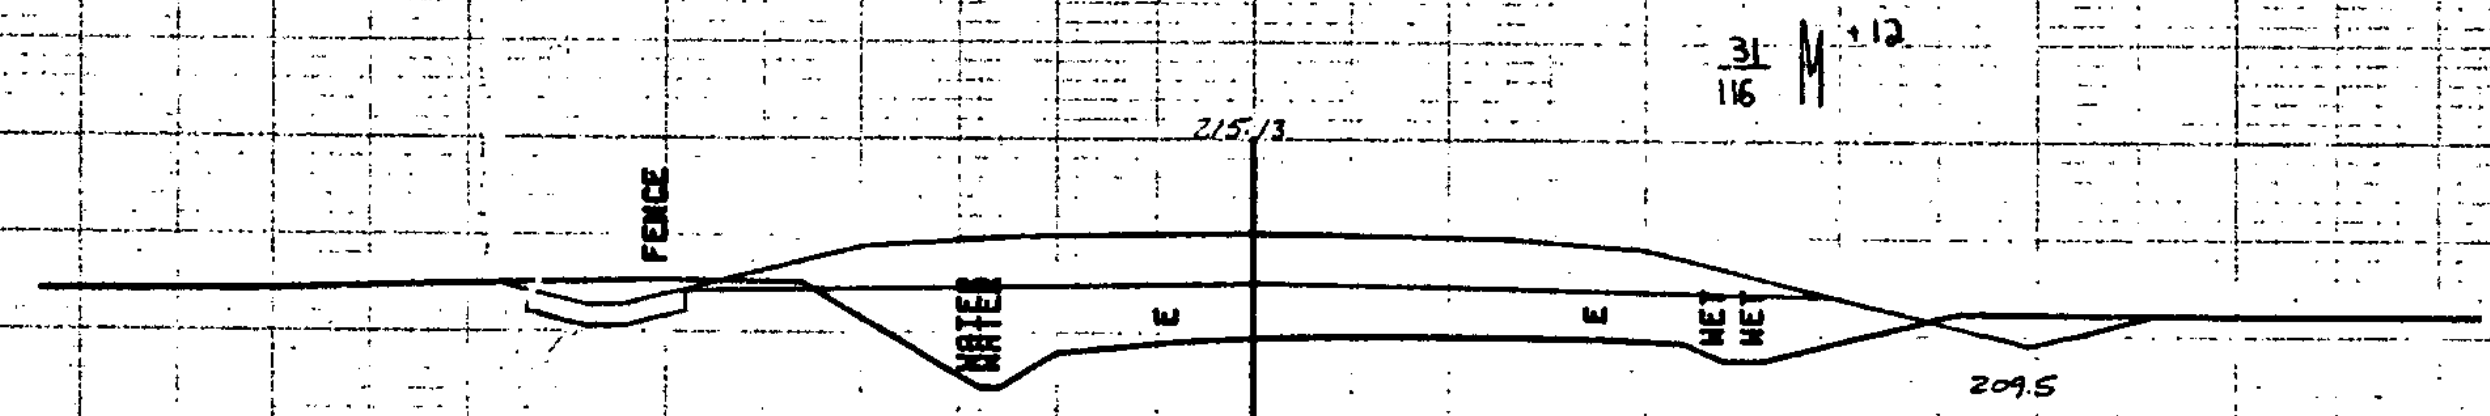

215.13  
 205+00

200

+63  
 18" E  
 Remove

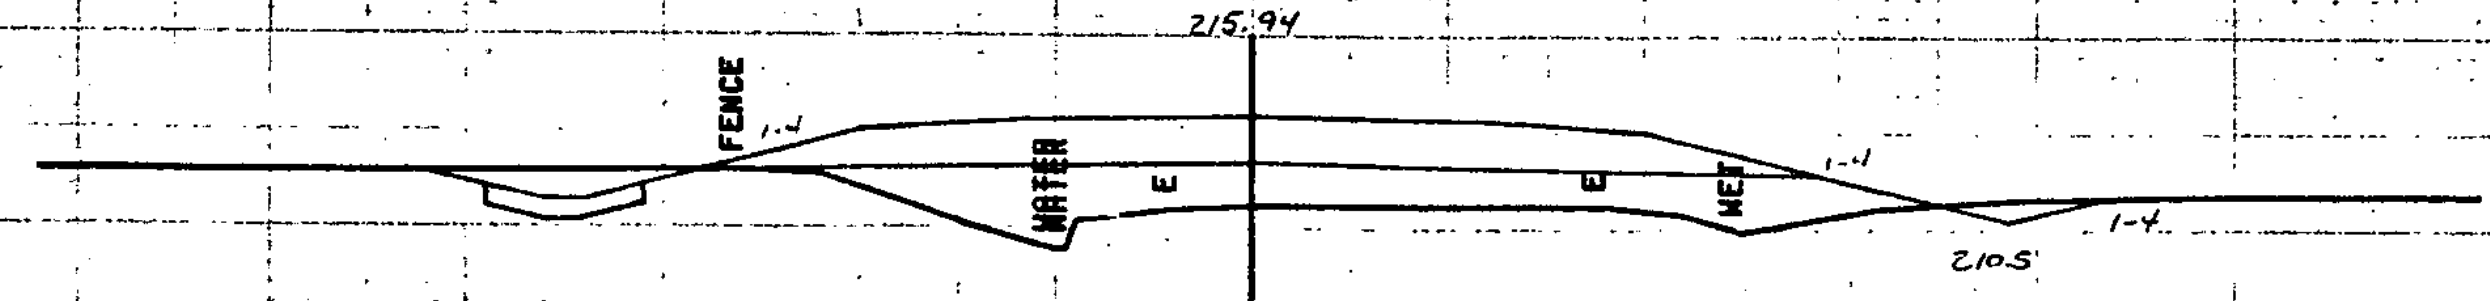

215.94  
 204+50

210

+34  
 10" E  
 Remove

FROM STA. 204+50 TO STA. 208+08  
 PROJECT NAME FERRISBURG M/L  
 NO. F EGC F 019-4 (II) PLOTTED 05/27/80  
 SURVEYED BY CARLSON APRIL 1980  
 SHEET 26 OF 62 SHEETS

SCALE 1" = 10 FEET