


224+46
GRAVEL DRIVE LT

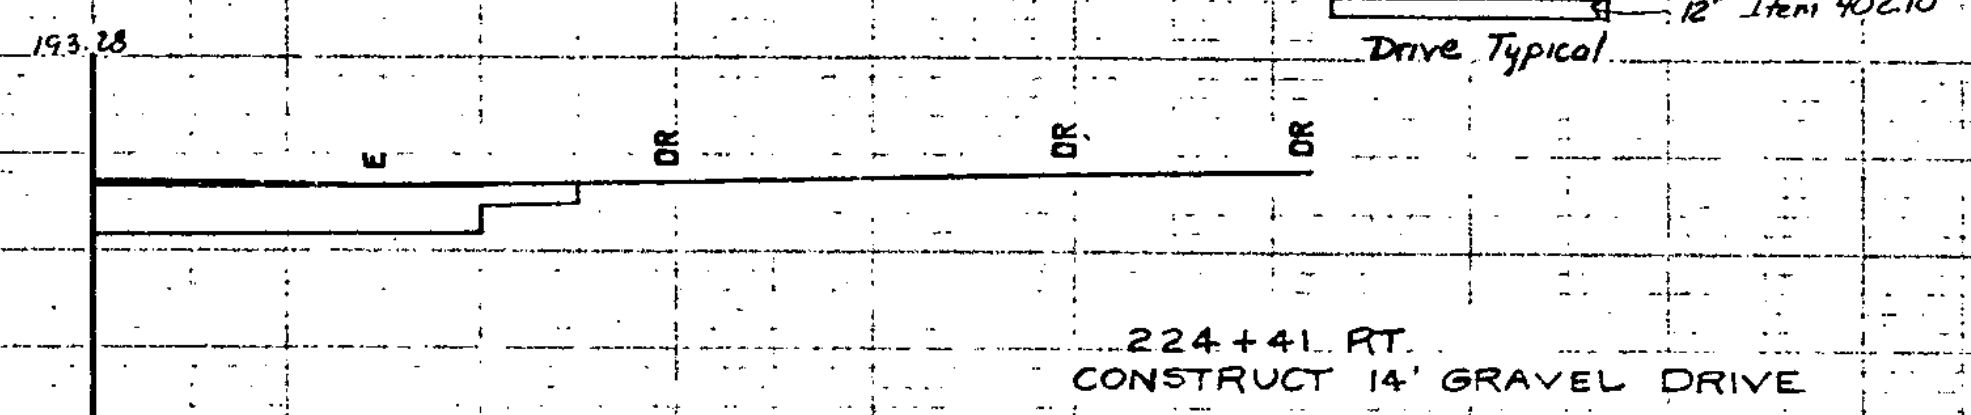


+21
24" E
Remove

224+41
GRAVEL DRIVE RT


224125 LT - 224135 RT
New 3" x 100' Seamless Copper Water Tube
w/ 6" x 150' Rigid Plastic Pipe Sleeve

M +07
103
44

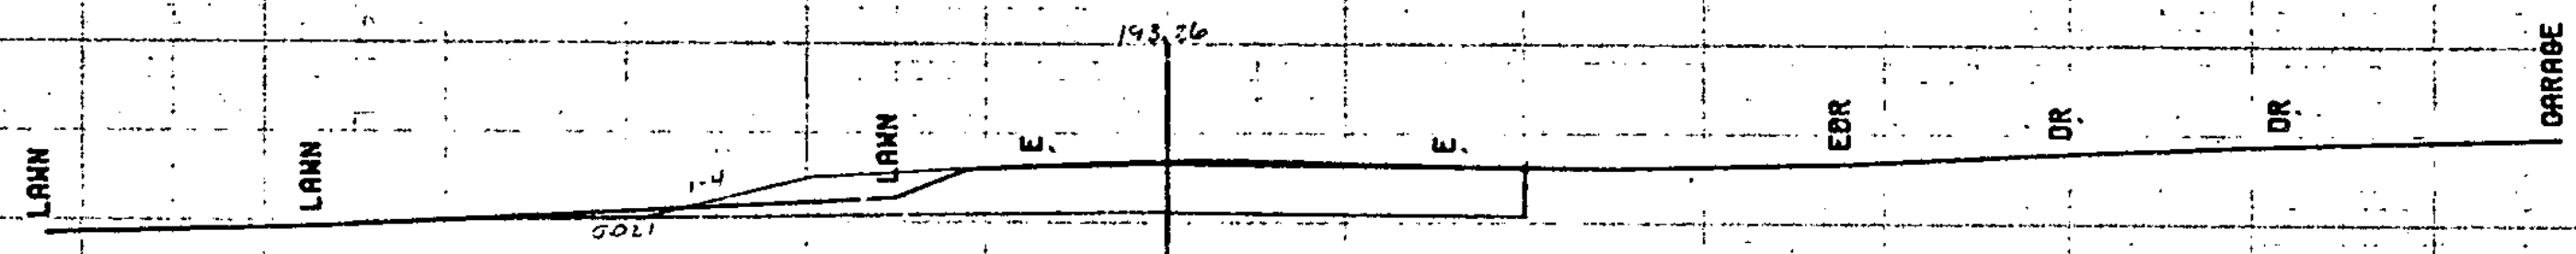



+94
Shrub
Save

224+00 ± RT
Existing CGMP Remove

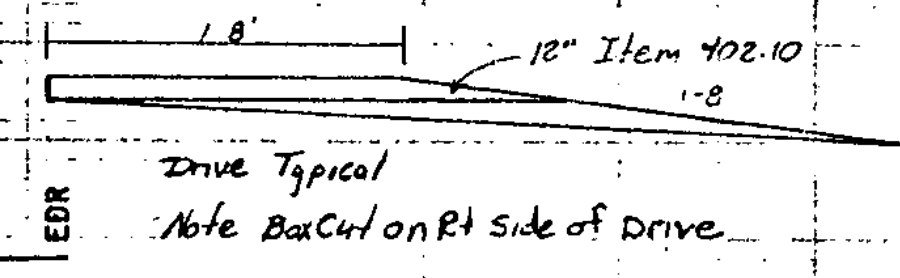

+65
Shrub
Save

223+77
GRAVEL DRIVE RT

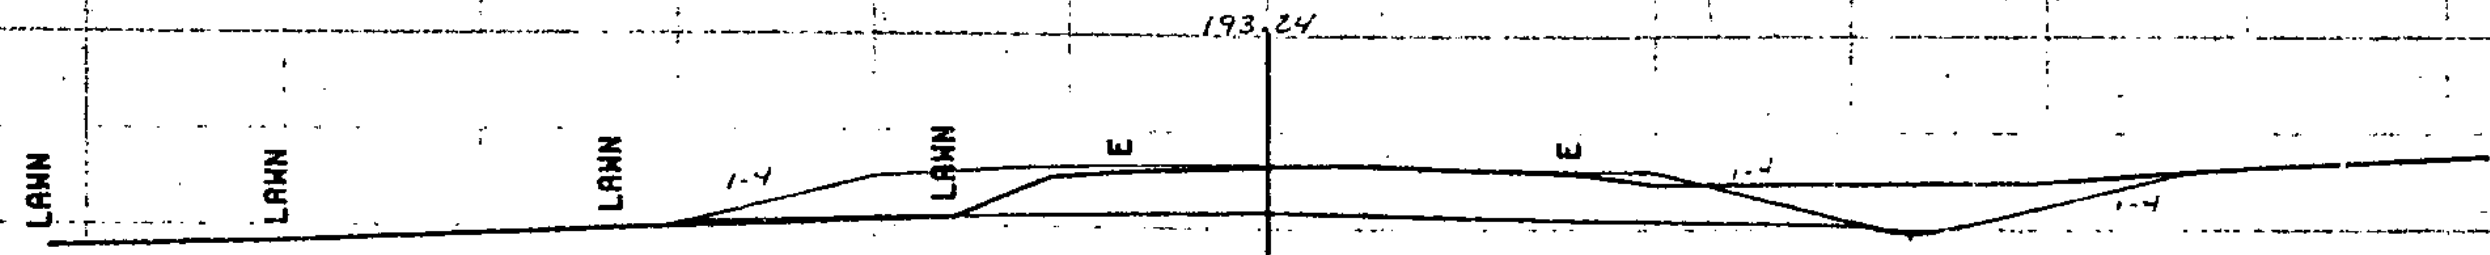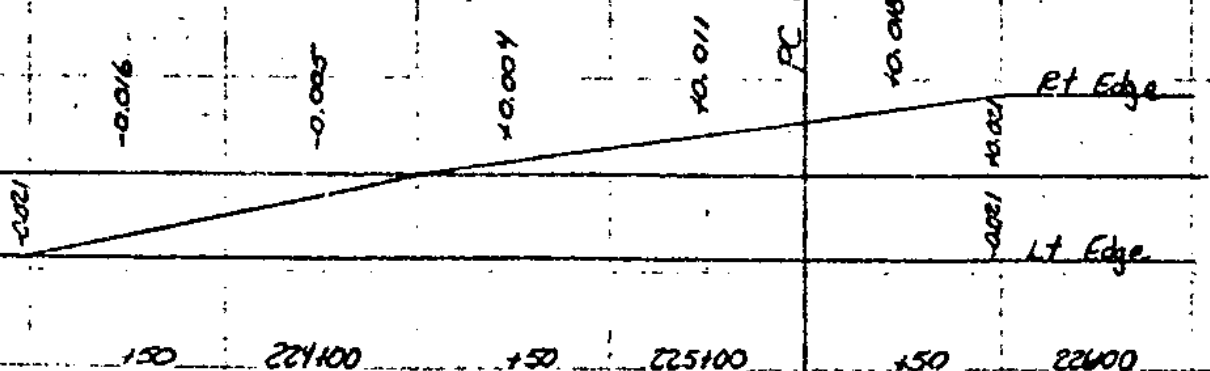

+47
Tele. Mkr.

FROM STA. 223+50 TO STA. 224+46
PROJECT NAME: FERRISBURG M/L
NO. F EGC F 019-4 (II) PLOTTED 07/08/80
SURVEYED BY: CARLSON-ARRIT 1980
SHEET 35 OF 62 SHEETS

SCALE: 1" = 10 FEET