
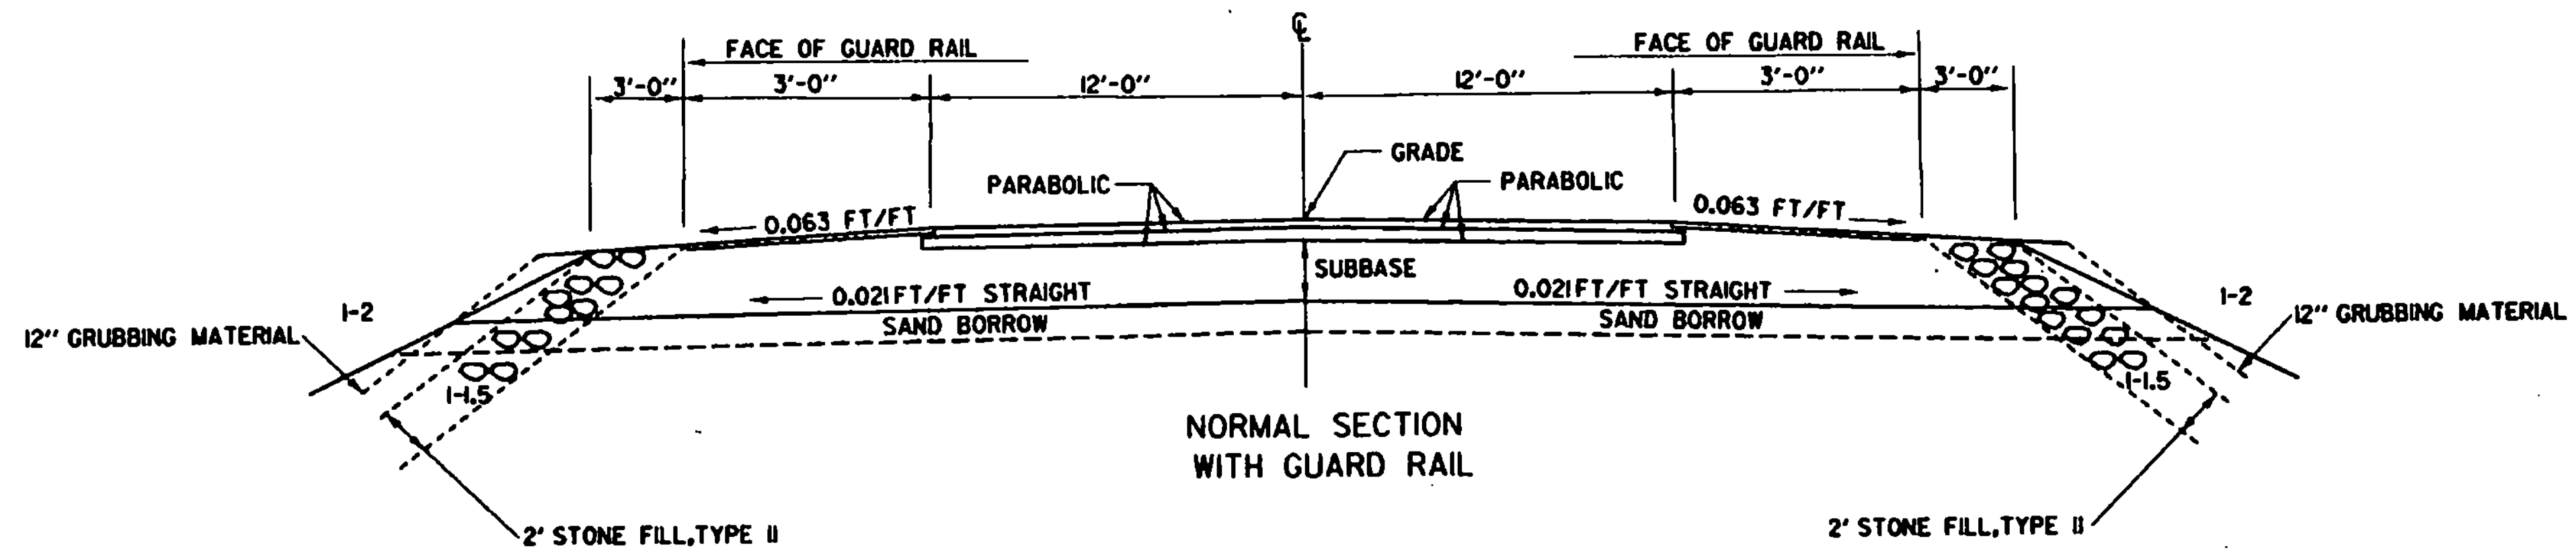


# TYPICAL SECTIONS

MATERIAL ITEM	THICKNESS TOLERANCE
PAVEMENT(OVERALL DEPTH)	± 1/4"
SUBBASE	± 1"
SAND BORROW	± 1"

3 1/2" BITUMINOUS CONCRETE PAVEMENT (1/2" LIFT OF TYPE III OVER 2" LIFT TYPE II)  
 3" BASE COURSE BITUMINOUS CONCRETE PAVEMENT (1 LIFT OF TYPE II)  
 \* 0" - 48" SUBBASE OF CRUSHED GRAVEL (FINE GRADED)  
 SHOULDERS : 1/2" BITUMINOUS CONCRETE PAVEMENT (TYPE III)  
 0" - 12" SAND BORROW (AS INDICATED ON PLANS OR AS DIRECTED BY THE ENGINEER )

\* SUBBASE IN TRANSITION (SEE DETAILS ON SHEETS 43 AND 46 OF 70 )

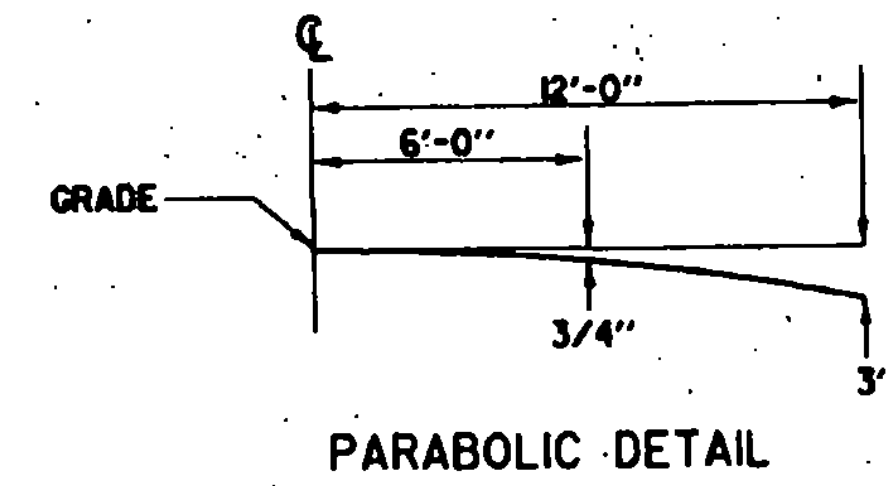

## SEEDING FORMULA , ITEM 651.15 RURAL AREAS

LBS./A.	WT.	NAME	PUR %	GERM %
22.5	1.5	CREEPING RED FESCUE	98	88
22.5	1.5	TALL FESCUE	98	90
5.0	0.5	RED TOP	98	88
5.0	0.5	BROADFOOT TREFOL	98	88
5.0	0.5	ANNUAL RYE GRASS	98	88
60.0	4.0			

\* SEED MIXTURE SHALL NOT HAVE A WEED CONTENT EXCEEDING 0.40%  
 \* WEIGHT AND SHALL BE FREE OF ALL NOXIOUS WEED SEED.  
 \* SEED- TO BE APPLIED PER SEEDING FORMULAS DIRECTED BY THE ENGINEER.  
 \* FERTILIZER- FORMULA 19-19-19 TO BE USED WITH SEED, APPLIED AT THE RATE OF 500 LBS./ACRE.  
 \* AGRICULTURAL LIMESTONE- TO BE APPLIED AT THE RATE OF 2 TONS/ACRE  
 \* AS DIRECTED BY THE ENGINEER.  
 \* MULCH- TO BE PLACED ON EARTH SLOPES AT THE RATE OF 2 TONS/ACRE,  
 \* AS DIRECTED BY THE ENGINEER.  
 \* OPSOL- TO BE USED WITH SEED AS INDICATED ON THE PLANS,  
 \* AS DIRECTED BY THE ENGINEER.  
 \* WALKER POSTS- TO BE PLACED AS DIRECTED BY THE ENGINEER.  
 \* SLOPE ROUNDING- ALL CUT SLOPES TO BE ROUNDED IN ACCORDANCE WITH STANDARD SHEET B-6.  
 \* AT LIMITS OF SAND BORROW WHEN USED IN CONJUNCTION WITH  
 \* REVISIONS- SEE STANDARD SHEET D-2.

SURVEYED BY	FALL	DATE	3/87
DRAWN BY	NAILOR	DATE	3/3/90
SQUAD LEADER	SHERIDAN		
DESIGN FILE NO.	ZF2456.501778069.DGN		
PRJ FILE	778069TYP	DATE PLOTTED	7-MAY-1992
PRJ NAME	NORWICH		
PRJ NO.	BHS 0113(36)		
SHEET	3	OF	70 SHEETS