
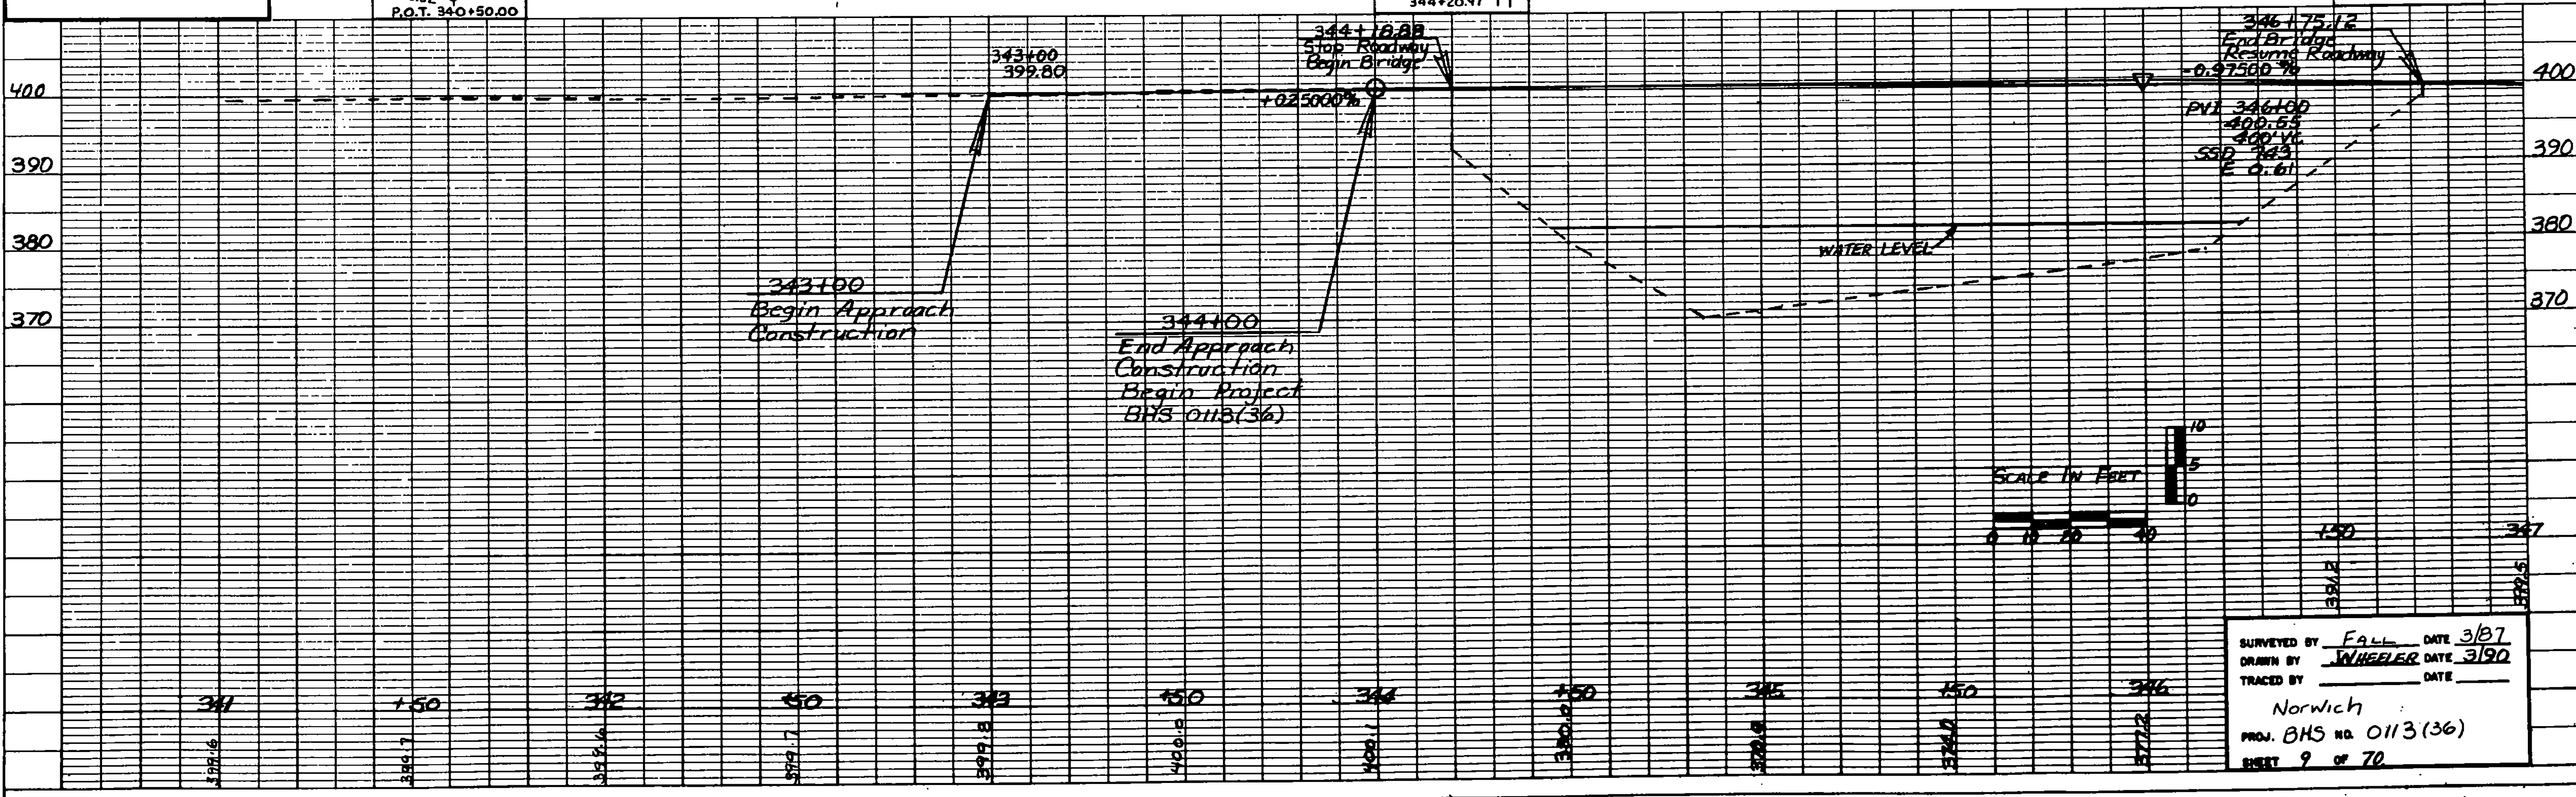
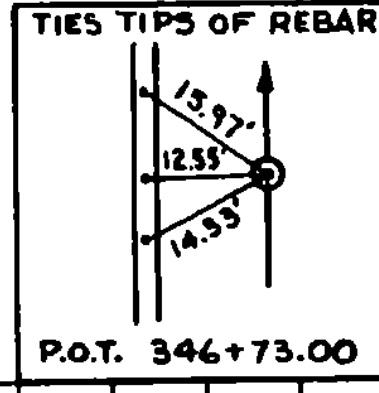
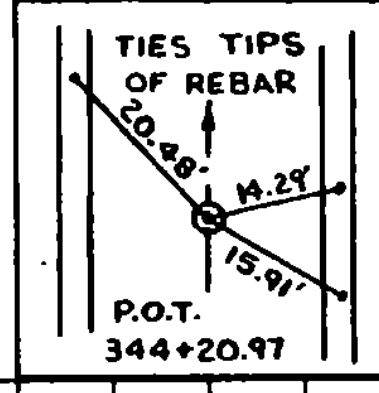


DATE: 11/11
 DRAWN BY: [blank]
 CHECKED BY: [blank]
 TITLE: [blank]
 NO.: [blank]

DATE: [blank]
 DRAWN BY: [blank]
 CHECKED BY: [blank]
 TITLE: [blank]
 NO.: [blank]

DATUM
 VERTICAL NGVD 1929
 HORIZONTAL N/A

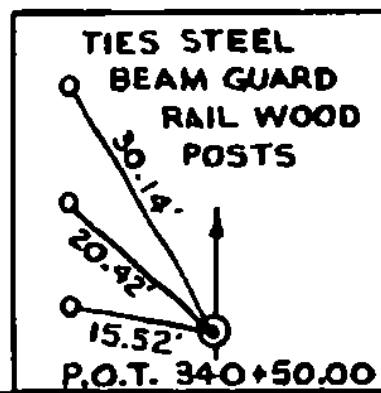

SURVEYED BY FALL DATE 3/07
 DRAWN BY WHEELER DATE 3/10
 TRACED BY _____ DATE _____
 Norwich
 PROJ. BHS NO. 0113(36)
 SHEET 9 OF 70

BRIDGING 44-233-1357