


ITEM	NO. PIECES	SIZE	LENGTH	MARK	TYPE	A	B	C	D	E	F	G	H	J	K	R	O	ITEM	NO. PIECES	SIZE	LENGTH	MARK	TYPE	A	B	C	D	E	F	G	H	J	K	R	O	ITEM	NO. PIECES	SIZE	LENGTH	MARK	TYPE	A	B	C	D	E	F	G	H	J	K	R	O
SUPERSTRUCTURE																		ABUTMENT #2																																			
4	444	5	24-1	ES501	STR													81												181																							
5	148	5	21-2	ES501A	STR													82												182																							
6	8	5	22-7	ES502	STR													83												183																							
7	80	5	27-1	ES503	STR													84												184																							
8	18	5	7-0	ES503A	STR													85												185																							
																		ABUTMENT #2 SHALL HAVE THE SAME BARS AS ABUTMENT #1 BUT SHALL HAVE A PREFIX OF "2A."																																			
12	278	6	30-3	ES601	STR													86												186																							
13	244	6	45-2	ES602	STR													87												187																							
																		PIER #2																																			
17	522	5	4-7	ES604	SS	0-6	1-5	0-9	1-5									88												188																							
18	88	5	7-11	ES505	SS	4-5	0-9	2-1	0-8									89												189																							
																		PIER #2 SHALL HAVE THE SAME BARS AS PIER #1 BUT SHALL HAVE A PREFIX OF "2P."																																			
ABUTMENT #1																		APPROACH SLAB - ABUTMENT #1																																			
27	44	5	26-1	IA501	STR													105												172																							
28	14	5	5-6	IA507	STR													106												173																							
32	10	7	25-9	IA701	STR													107												174																							
35	6	8	16-0	IA801	STR													108												175																							
38	10	11	20-9	IA101	STR													109												176																							
41	61	5	9-2	IA502	T1	0-7	1-7	2-5	1-7	2-5							110												177																								
42	51	5	9-11	IA503	16	2-2	3-1	1-6	1-8	1-6							111												178																								
43	51	5	9-10	IA504	S10			4-6	0-10	4-6							112												179																								
44	46	5	7-3	IA505	16	2-2	1-10	0-9	2-6								113												180																								
45	51	5	9-6	IA506	S10			4-4	0-10	4-4							114																																				
47	12	8	9-3	IA802	19			6-3	3-0								115																																				
48	16	8	6-0	IA803	19			3-0	3-0								116																																				
PIER #1																		APPROACH SLAB - ABUTMENT #2																																			
54	23	5	4-6	IP501	STR													120												191																							
55	24	5	24-0	IP502	STR													121												192																							
59	47	5	7-6	IP503	S10			1-6	4-6	1-6							122												193																								
60	46	5	5-0	IP504	S10			3-0	2-0								123												194																								
79																		159																																			
80																		160																																			

ASTM STANDARD REINFORCING BARS				
BAR SIZE DESIGNATION	WEIGHT POUNDS PER FOOT	NOMINAL DIMENSIONS ROUND SECTION		
		DIAMETER INCHES	CROSS SECTIONAL AREA SQ. INCHES	PERIMETER INCHES
#3	.376	.375	.11	1.178
#4	.668	.500	.20	1.571
#5	1.043	.625	.31	1.963
#6	1.502	.750	.44	2.356
#7	2.044	.875	.60	2.749
#8	2.670	1.000	.79	3.142
#9	3.400	1.128	1.00	3.544
#10	4.303	1.270	1.27	3.990
#11	5.313	1.410	1.56	4.430
#14	7.65	1.693	2.25	5.32
#18	13.60	2.257	4.00	7.09

TYPICAL BAR BENDS

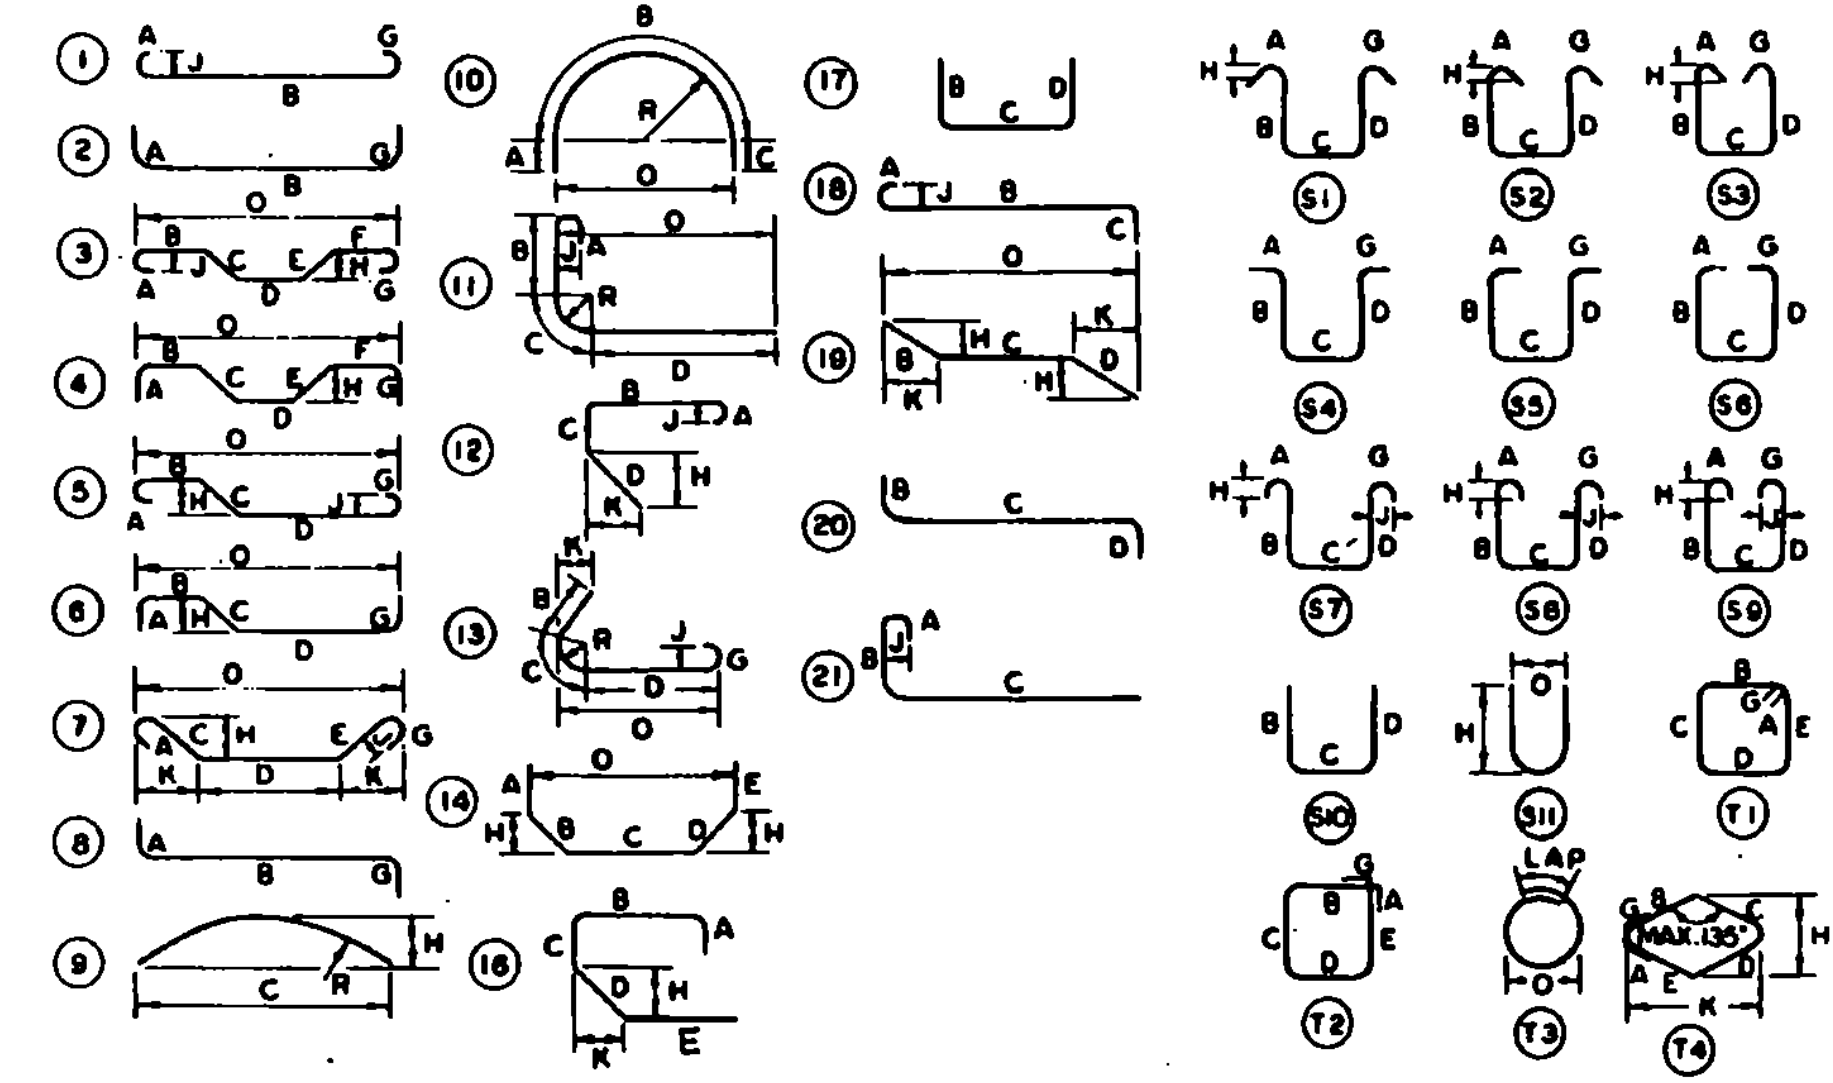

NOTES

- UNLESS OTHERWISE DESIGNATED, ALL BAR REINFORCEMENT FOR CONCRETE IN SIZES UP TO AND INCLUDING NO. 18 SHALL CONFORM TO THE REQUIREMENTS OF THE "SPECIFICATIONS FOR DEFORMED BILLET-STEEL BARS FOR CONCRETE REINFORCEMENT," AASHTO M 31 (ASTM A 615-B1). ALL BARS SHALL BE GRADE 60, UNLESS OTHERWISE DESIGNATED.
 - FOR TYPICAL BENDING DETAILS, RECOMMENDED PIN DIAMETER "D" OF BENDS AND HOOKS AND OTHER STANDARD PRACTICE SEE CURRENT CONCRETE REINFORCING STEEL INSTITUTE "MANUAL OF STANDARD PRACTICE."
 - BARS WHICH REQUIRE MORE ACCURATE BENDING THAN STANDARD PRACTICES SHOULD HAVE LIMITS INDICATED.
 - ALL DIMENSIONS ARE .OUT TO OUT OF BAR EXCEPT "H" AND "G" ON STANDARD 180° AND 135° HOOKS.
 - "J" DIMENSION ON 180° HOOKS TO BE SHOWN ONLY WHERE NECESSARY TO RESTRICT HOOK SIZE, OTHERWISE STANDARD HOOKS ARE TO BE USED.
 - "H" DIMENSION ON STIRRUPS TO BE SHOWN ONLY WHEN NECESSARY TO MAINTAIN CLEARANCES.
 - WHERE SLOPE DIFFERS FROM 45° DIMENSIONS "M" AND "N" MUST BE SHOWN.
- ▲ DENOTES BARS TO BE CUT IN FIELD.
 * DENOTES ONE EXTRA BAR ADDED FOR TESTING PURPOSES.
 △ DENOTES TWO EXTRA BARS ADDED FOR TESTING PURPOSES.

REV. NO.	MADE BY	DATE	DESCRIPTION

STATE OF VERMONT
AGENCY OF TRANSPORTATION

TOWN OF NORWICH	BRIDGE NO. 81
HIGHWAY NO. U.S. ROUTE 5	LOG STA. 345+47
U.S. ROUTE 5 OVER THE OMPOMPANOSUC RIVER	
REINFORCING STEEL SCHEDULE	
DESIGNED BY D.J. HOYNE	DRAWN BY D.J. HOYNE
CHECKED BY B.E. SICKERT	BRIDGE DESIGN SUPERVISOR
DATE 2-92	FRY: Bo/kum DATE 4/92
PROJECT NORWICH	PROJECT NO. BHS 0113 (36)
BRIDGE SHEET NO. BR 115	SHEET 31 OF 70