


344+38 Lt
 End Guard Rail Approach Section Type I
 End Removal and Disposal of Guard Rail

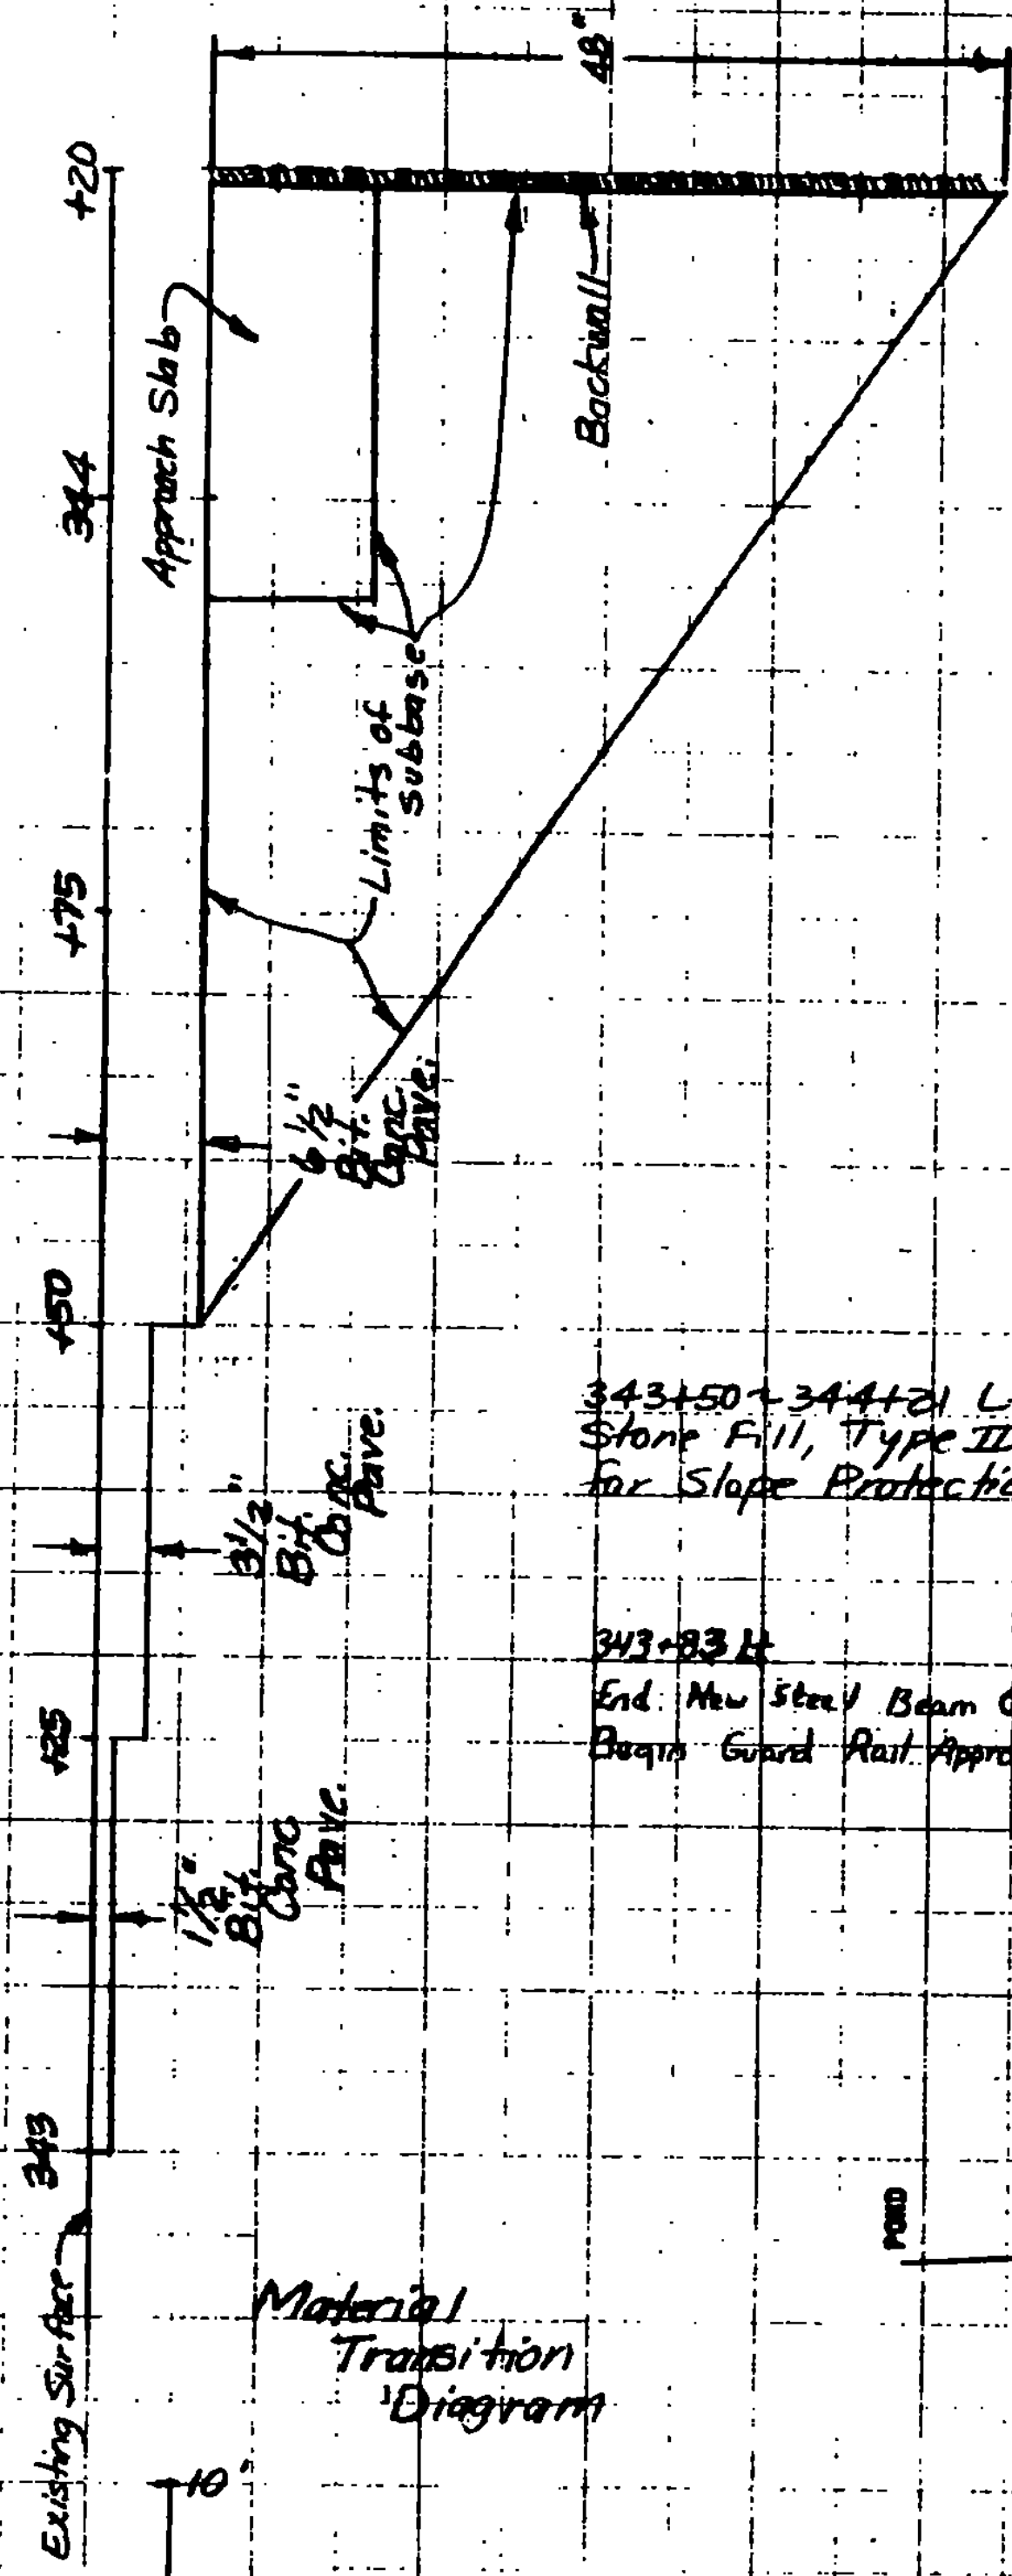

343+50 - 344+21 Lt.
 Stone Fill, Type II
 for Slope Protection

343+83 Lt
 End New Steel Beam Guard Rail
 Begin Guard Rail Approach Section Type I

343+08 Lt
 Begin Removal and Disposal of Guard Rail
 Begin New Steel Beam Guard Rail

343+00
 Begin Approach Construction
 Cold Planing Bituminous Pavement


Stone Fill, Type II
 Grubbing Material (Typ)

344+08 RA
 End Guard Rail Approach Section Type I
 End Removal and Disposal of Guard Rail

343+50 - 344+21 RA
 Stone Fill, Type II
 for Slope Protection

343+83 RA
 End New Steel Beam Guard Rail
 Begin Guard Rail Approach Section Type I

Roadway and Shoulder Banking Detail

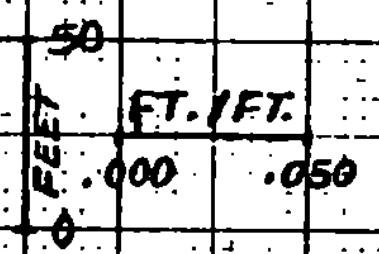

PROJECT NAME	NORWICH MAIN	TO STA.	344+20.98
NO.	BNSD 13 1980 S		
DATE	FALL		
SCALE	1" = 40'		
PLOTTED	03/25/97		