


346+85.44
 Begin Guard Rail Approach Section Type I
 Begin Removal and Disposal of Guard Rail

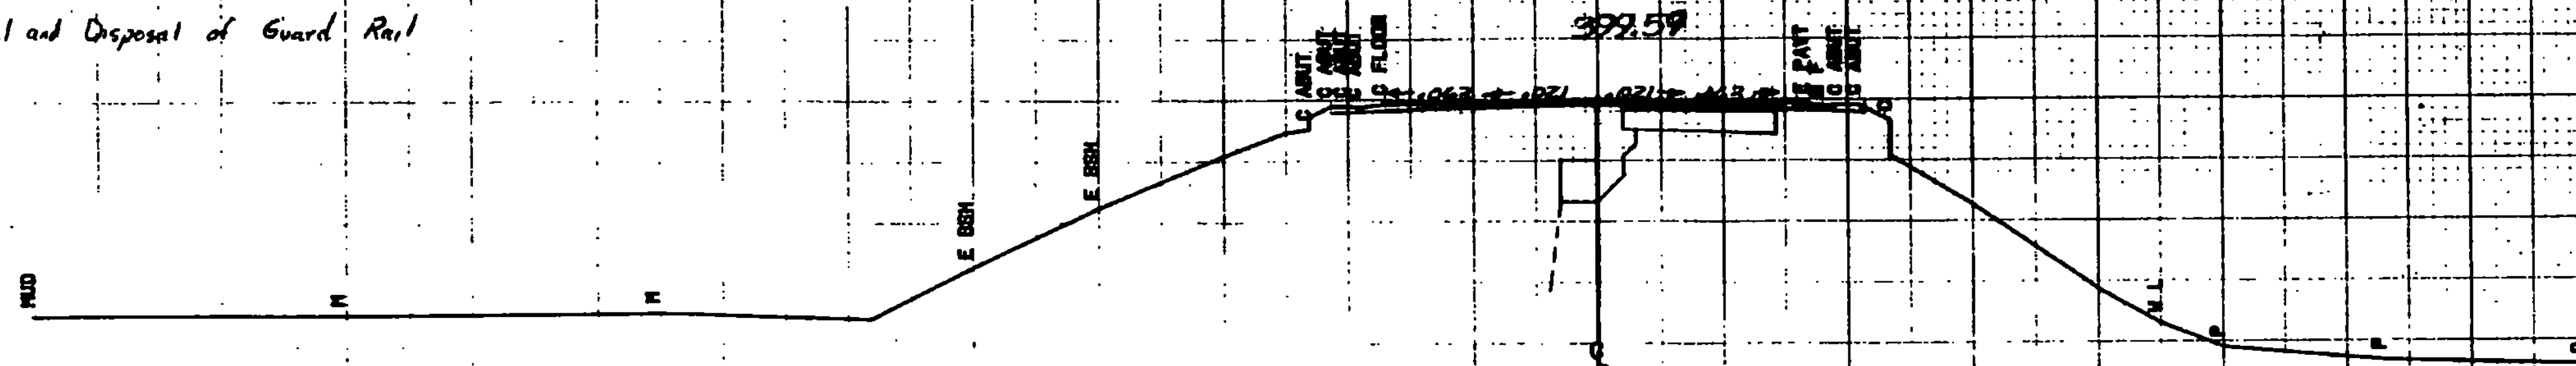

346+75.12
 346+73
 End Bridge
 Resume Roadway
 Askew 44°50' Lt.
 399.72

390

346+62.88
 Begin Removal and Disposal of Guard Rail
 Begin Guard Rail Approach Section Type I

390

346+50


399.94

390

346+00

399.97

390

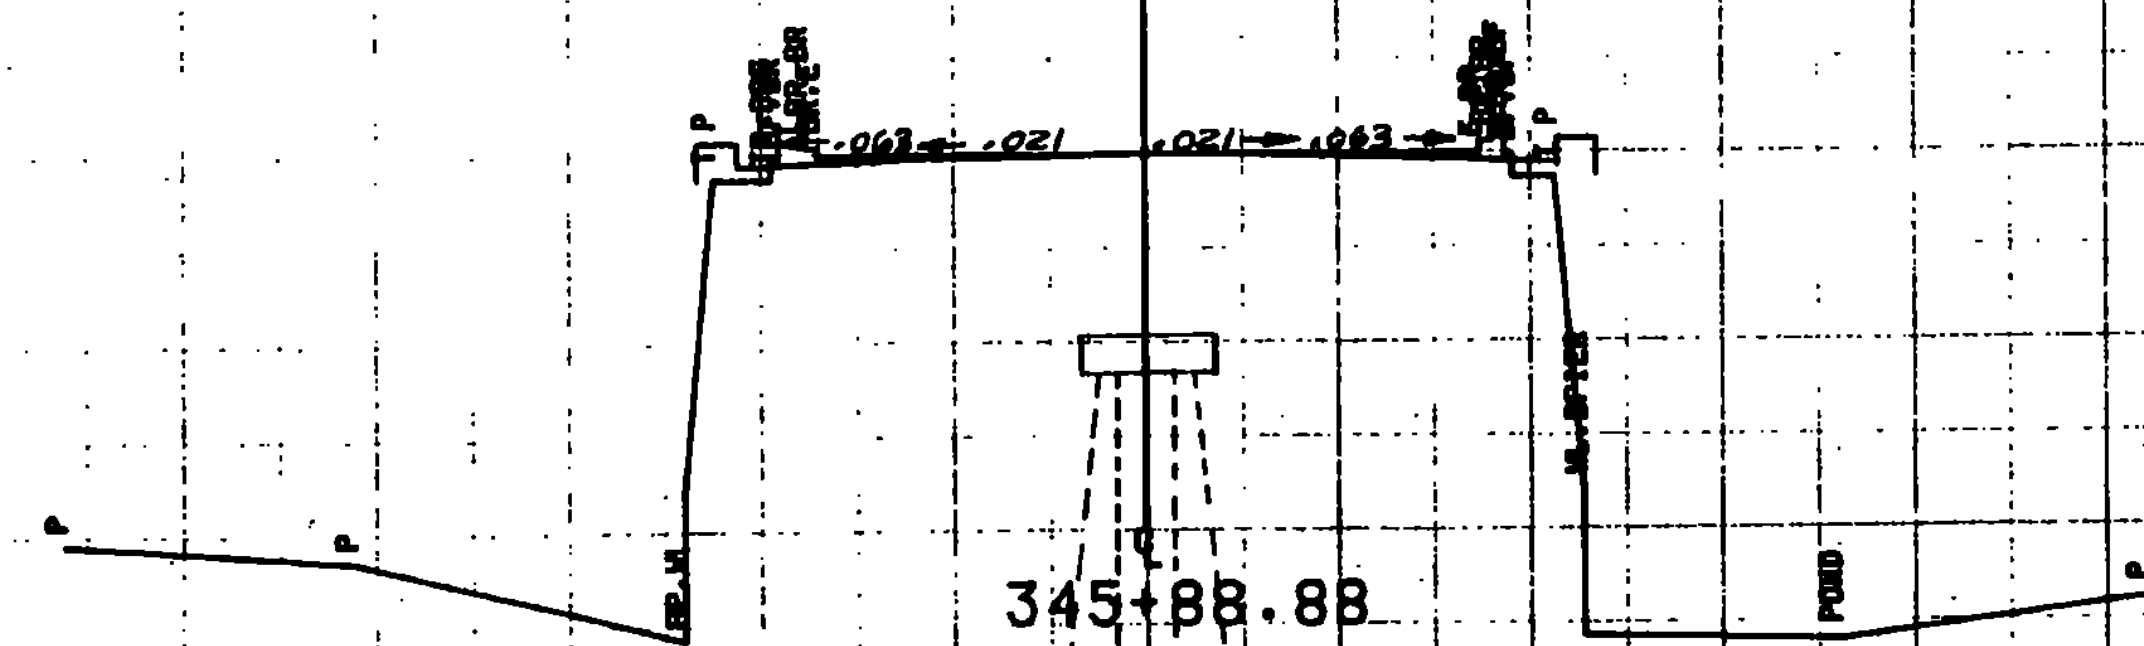

345+88.88
 Askew 45°12' Lt.

SCALE 1" = 10' HORIZ

FROM STA.	345+88.88	TO STA.	346+73
PROJECT NAME	NORMICH MAIN		
NO.	BHS01.13 (SG) 9		PLOTTED 03/25/87
SURVEYED BY	CALL		03/87
SHEET	25 OF 70 SHEETS		