


WEST RUTLAND - RUTLAND
 REG. F020-1(10) 9/2
 TOPSOIL 982+0^R - 984+0^R

DATE: 10/2/92
 BY: J. W. G. L. / J. W. G. L.
 SURVEYED: []
 PLOTTED: []
 AREA CHECKED: []
 ORIGINAL SURVEY NOTE BOOK No. []

DATE: []
 BY: []
 SURVEYED: []
 PLOTTED: []
 AREA CHECKED: []
 ORIGINAL SURVEY NOTE BOOK No. []

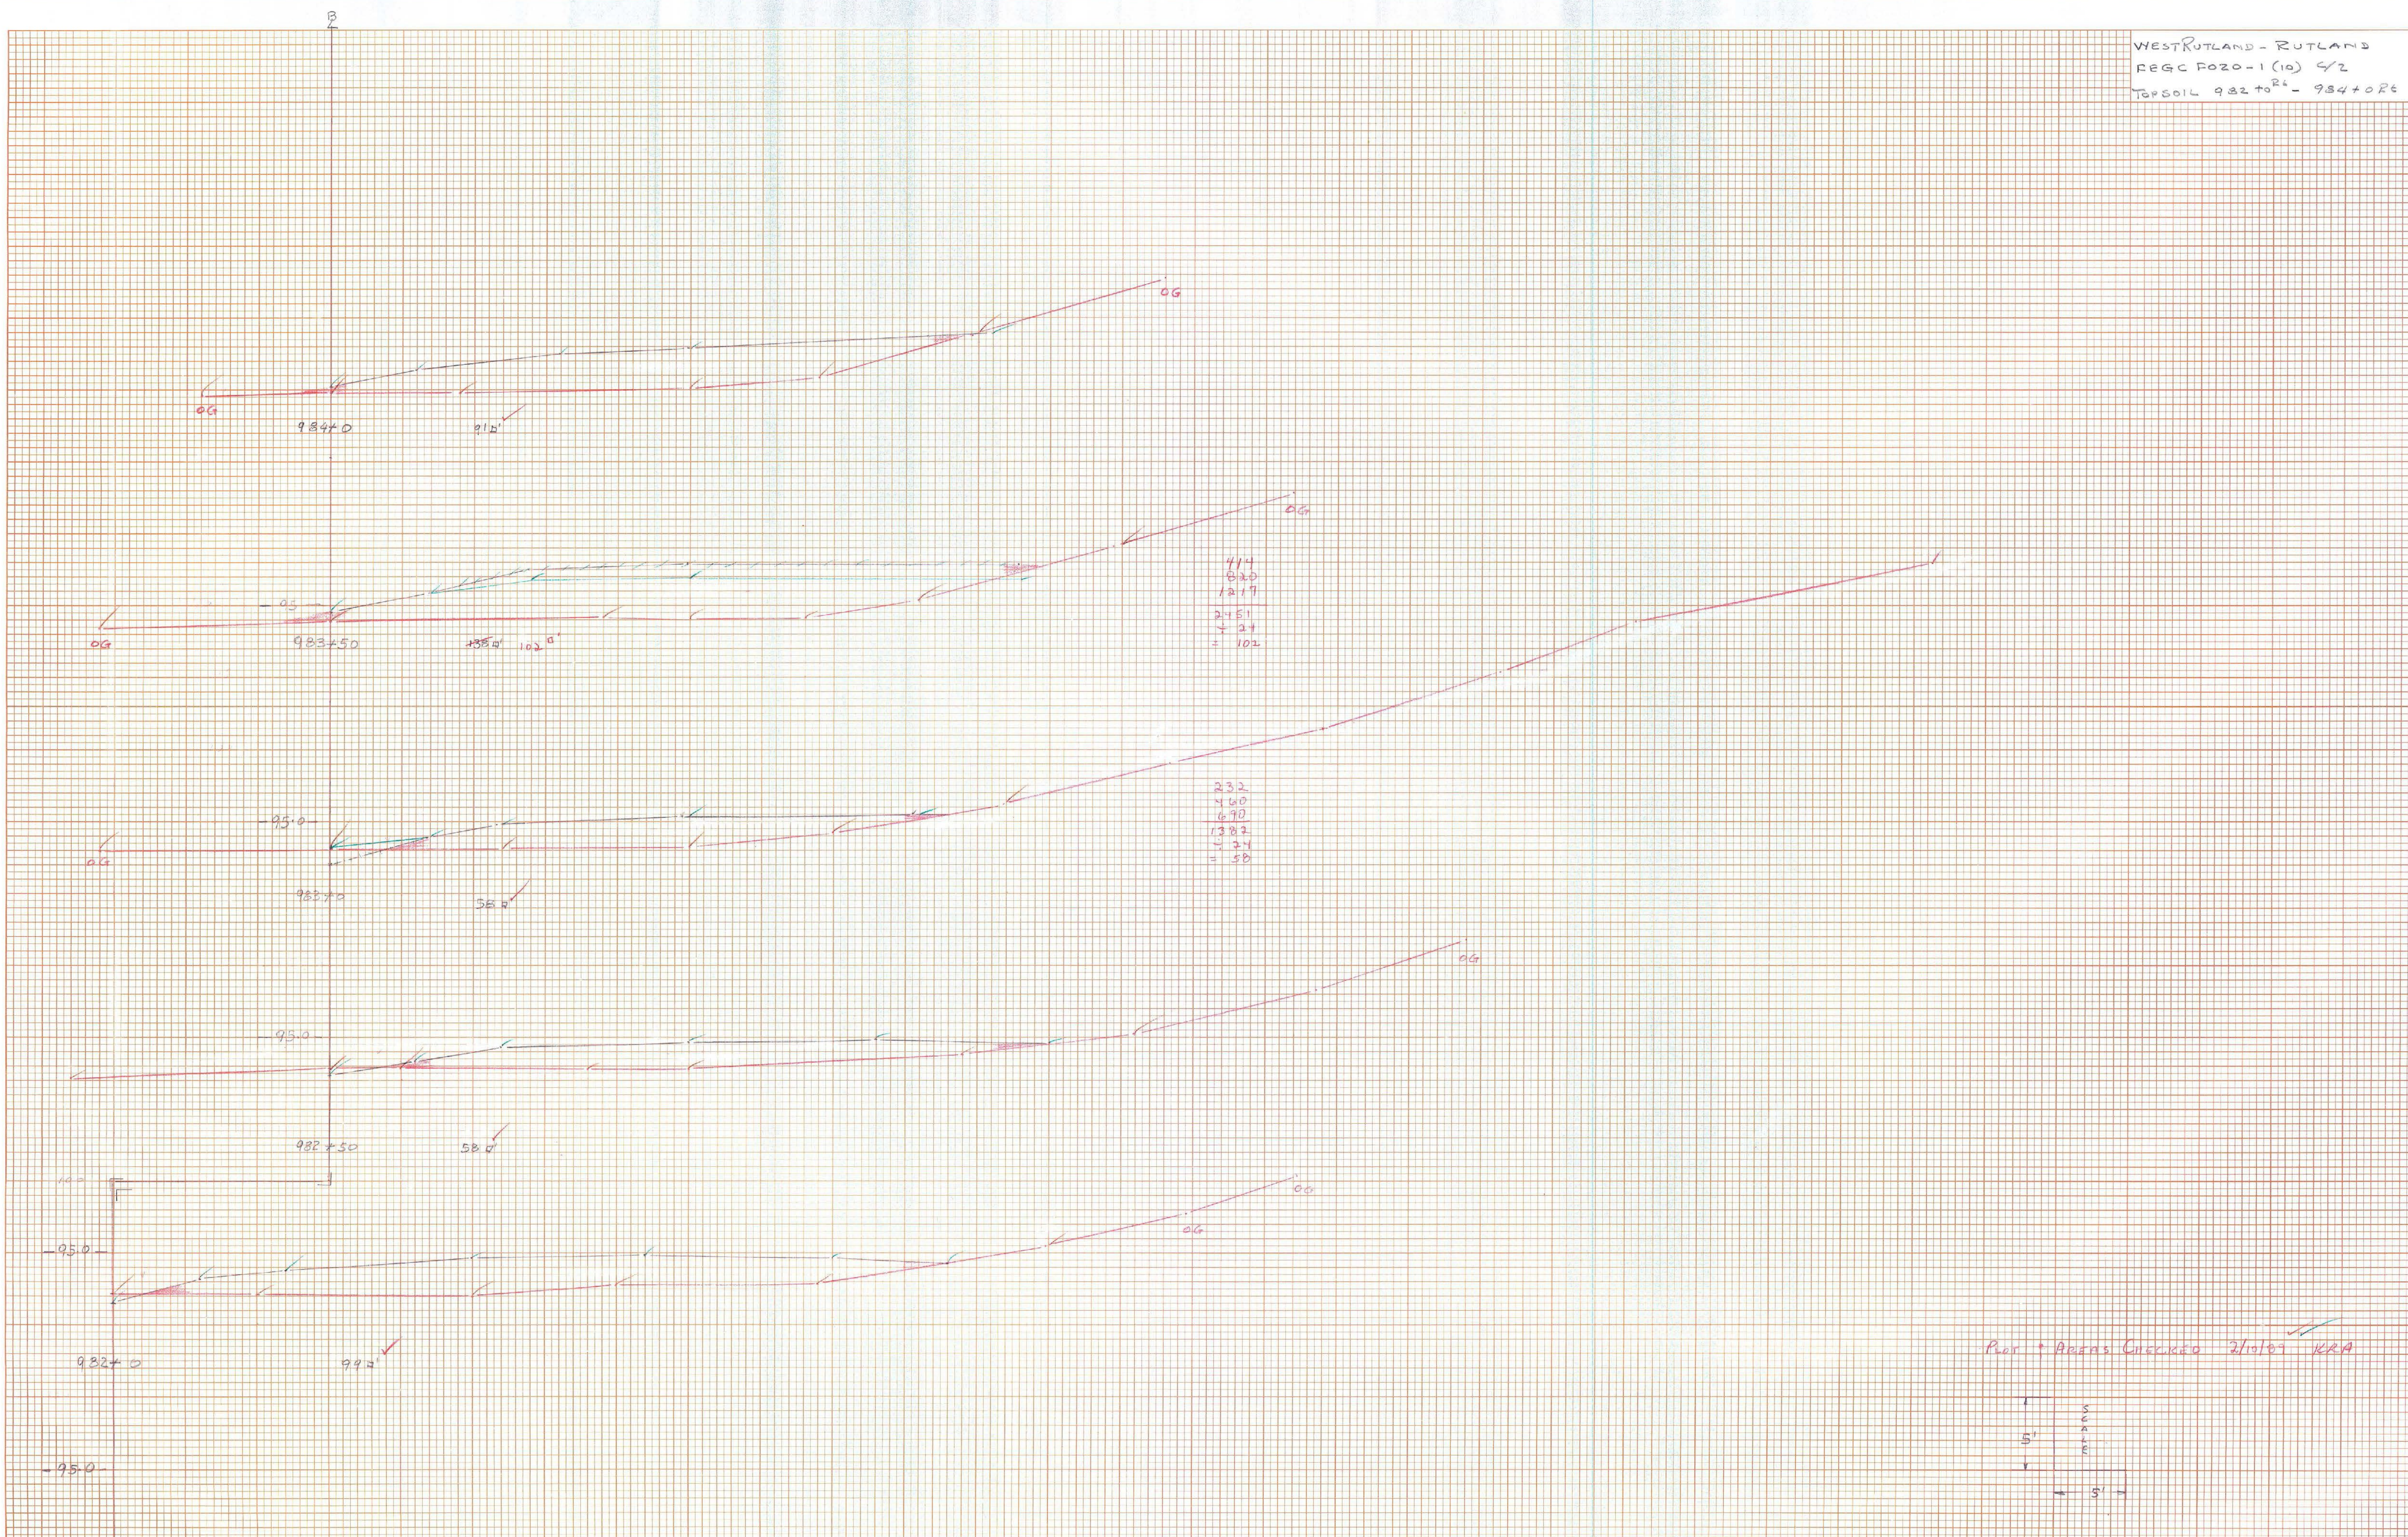

Plan + Areas Checked 2/10/07 KRA

