


DATE: 7/10/89  
 BY: K.A.A.  
 SURVEYED: V.L.E.P.T.E.  
 PLOTTED: T.A.L.E.P.T.E.  
 AREA CHECKED: K.A.A.  
 FINAL SURVEY NOTE BOOK NO.

DATE: 7/10/89  
 BY: K.A.A.  
 SURVEYED: V.L.E.P.T.E.  
 PLOTTED: T.A.L.E.P.T.E.  
 AREA CHECKED: K.A.A.  
 ORIGINAL SURVEY NOTE BOOK NO.

STATION	DIST.	AREA	CU. YDS.	AREA	C.Y.
977+0		0		0	
977+50	50	363	336	363	336
978+0	50	378	686	374	682
978+50	50	323	649	243	571
979+0	50	163	450	175	387
979+50	50	184	321	184	332
980+0	50	163	321	174	331
980+50	50	89	233	94	248
981+0	50	98	173	98	178
981+50	50	98	192	98	191
982+0	50	99	143	99	143
982+50	50	52	145	52	145
983+0	50	52	107	52	107
983+50	50	138	181	102	148
984+0	50	91	213	91	179
984+50	50	104	181	89	167
985+0	0	0	0	0	0
COLUMN TOTAL			4476		4277

WEST RUTLAND - RUTLAND  
 REG. C. FORD-1 (10) 1/2  
 TOPSOIL 984+50<sup>R</sup> 985+50<sup>RE</sup>

K.A.A.  
 7/10/89

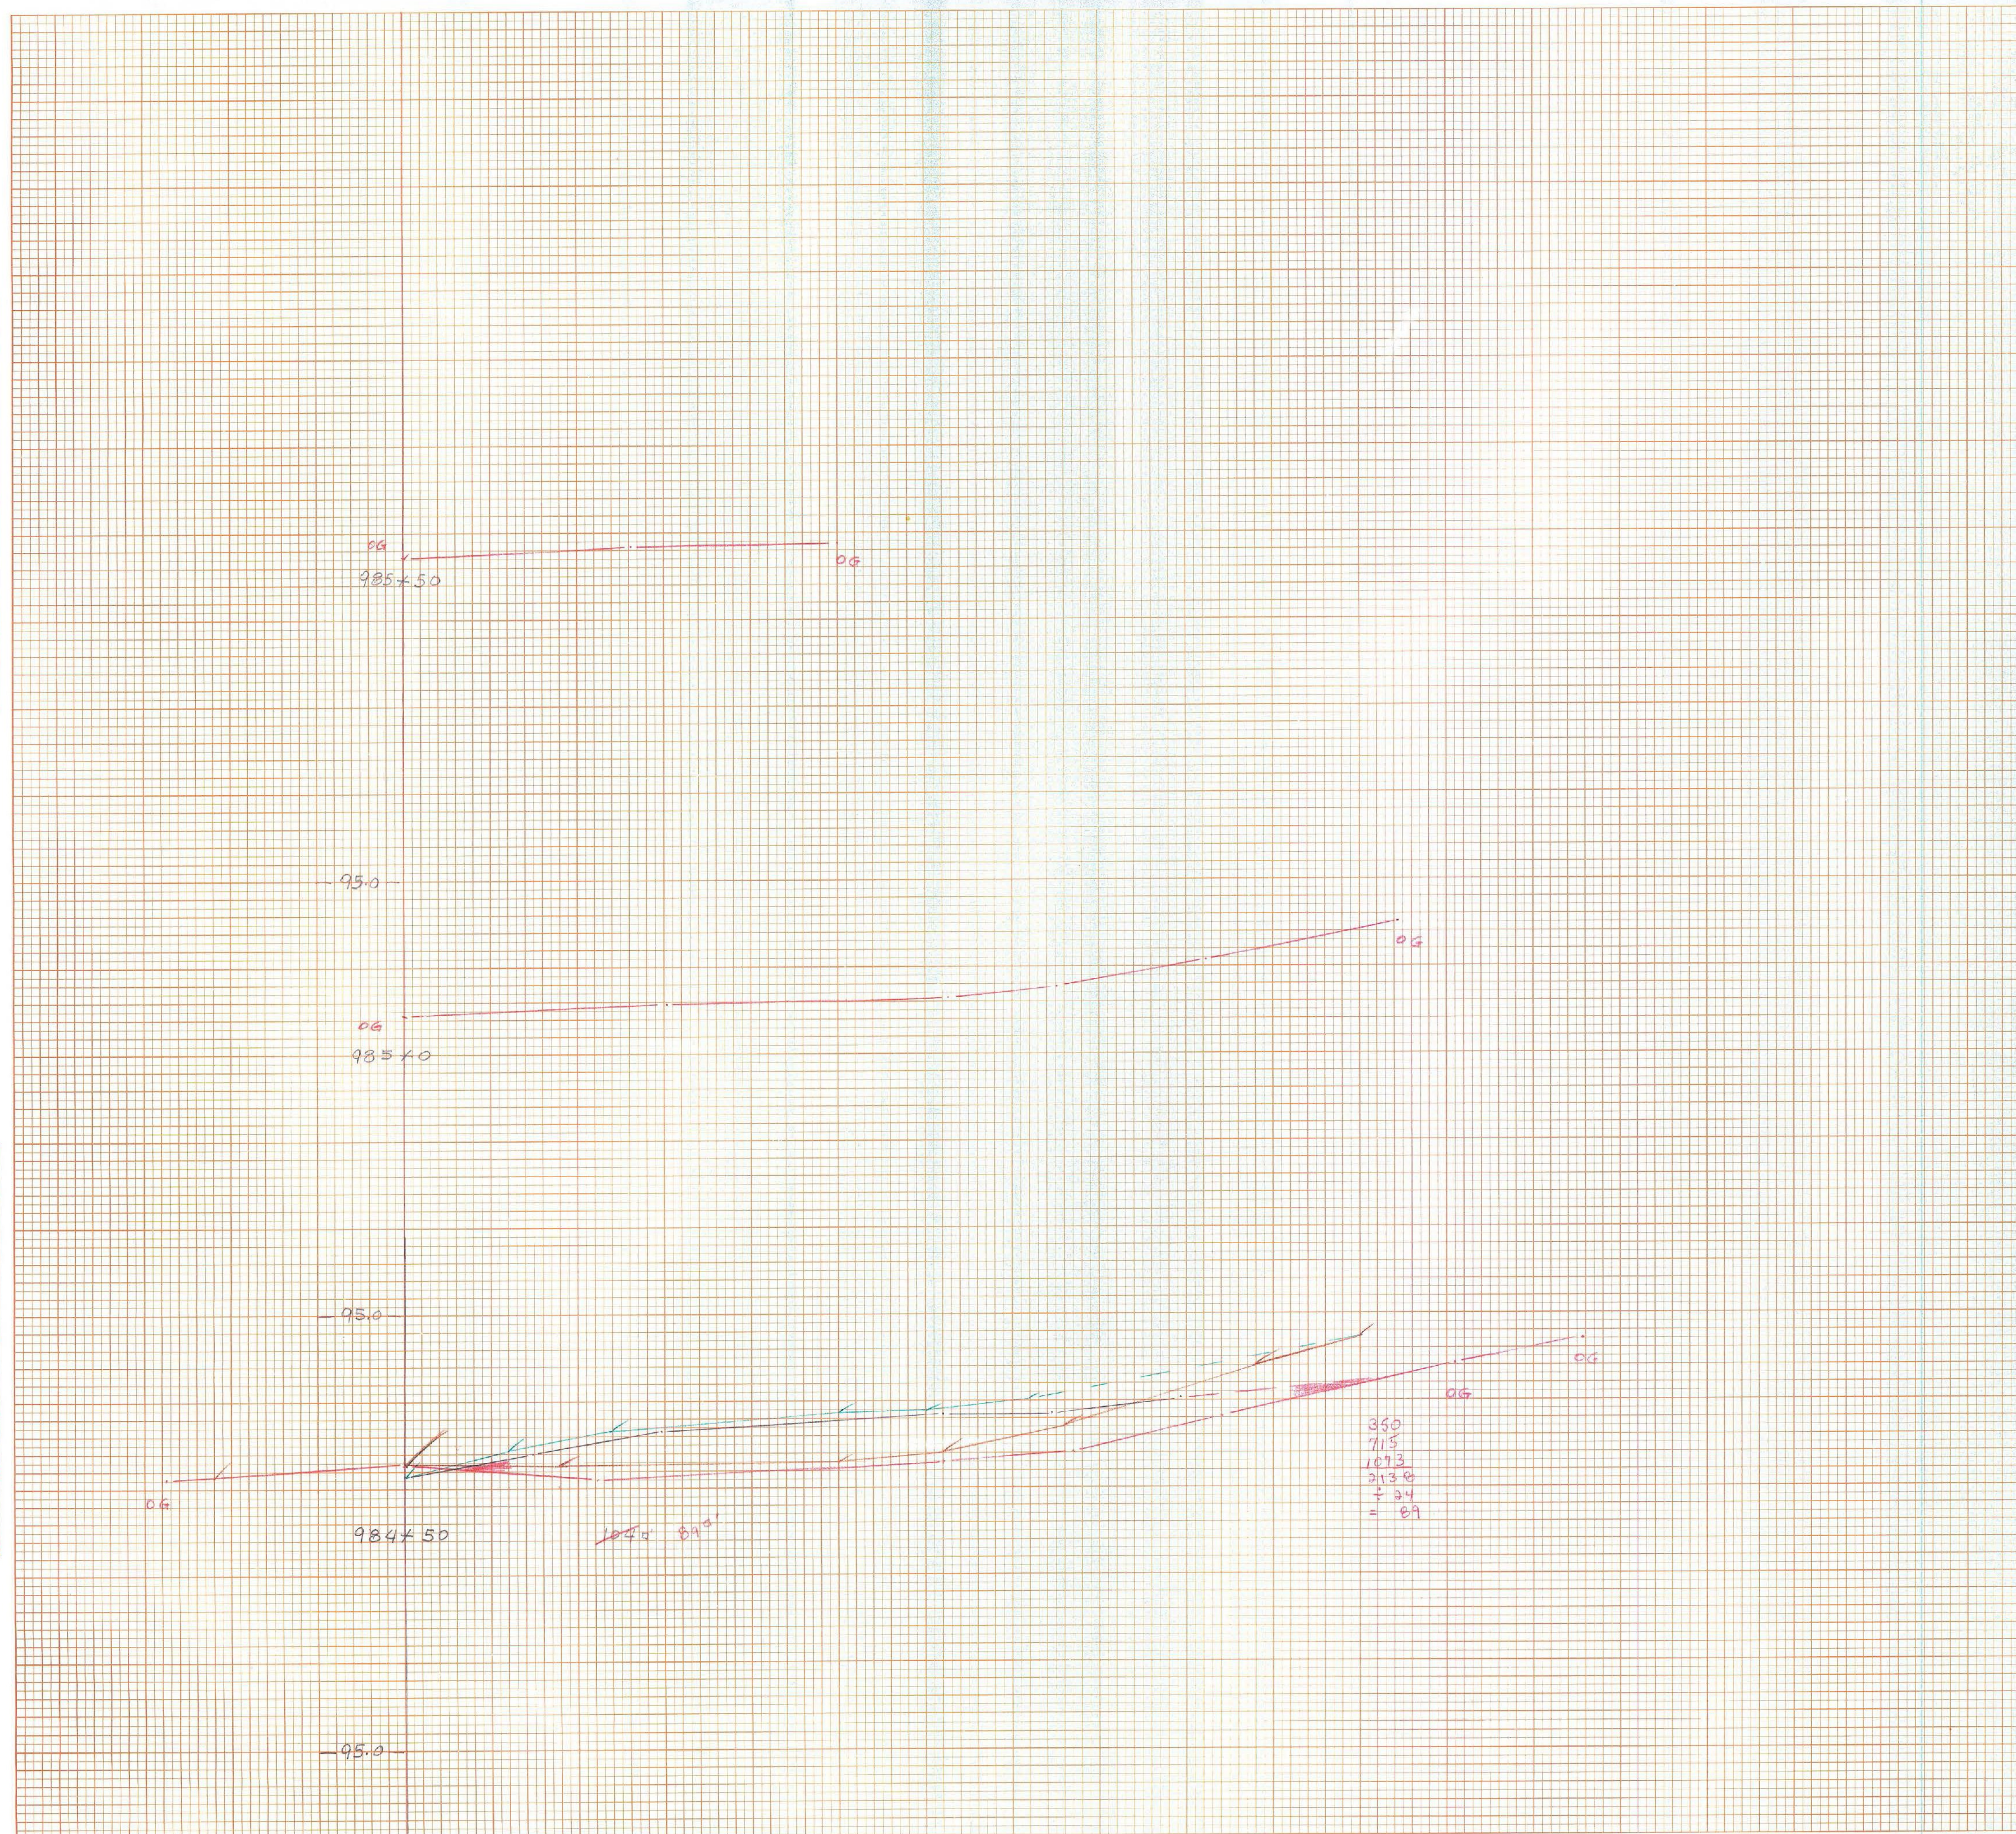

Prof. & Area Checked 7/10/89 K.A.A.

