


PLAN VIEW
 EAST BOUND LANE
 OVER DORR DRIVE

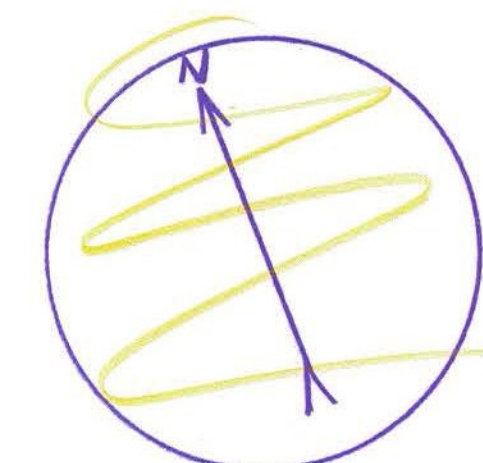

RECEIVED JUL 16 1986
 CK'D BY CSR OK'D BY CFW
 RESUBMIT _____ APPROVED _____
 BY Allen & Couch DATE 7/18
SWB

UNO - UNLESS NOTED OTHERWISE
 TOTAL PAULIMIT THIS SHEET = 484'-4"

DRAWN BY: MR	DATE: 7-10-85	CHECKED BY: me	SHEET NO. 2 OF 4
2 RAIL BOX BEAM BRIDGE RAIL LAYOUT US RTE 4 OVER DORR DRIVE (EB) TOWNS OF RUTLAND & WEST RUTLAND RUTLAND COUNTY STATE OF VERMONT			
PROJECT # F-EGC-F-020-1(10)			
GENERAL CONTRACTOR: MAXWELL BROTHERS FENCE CO.			
ERECTOR: MAXWELL BROTHERS FENCE CO.			HUBBELL JOB NUMBER
FABRICATOR: D.W. HUBBELL & SONS, INC.			DS/227