


EASTBOUND FRAMING PLAN

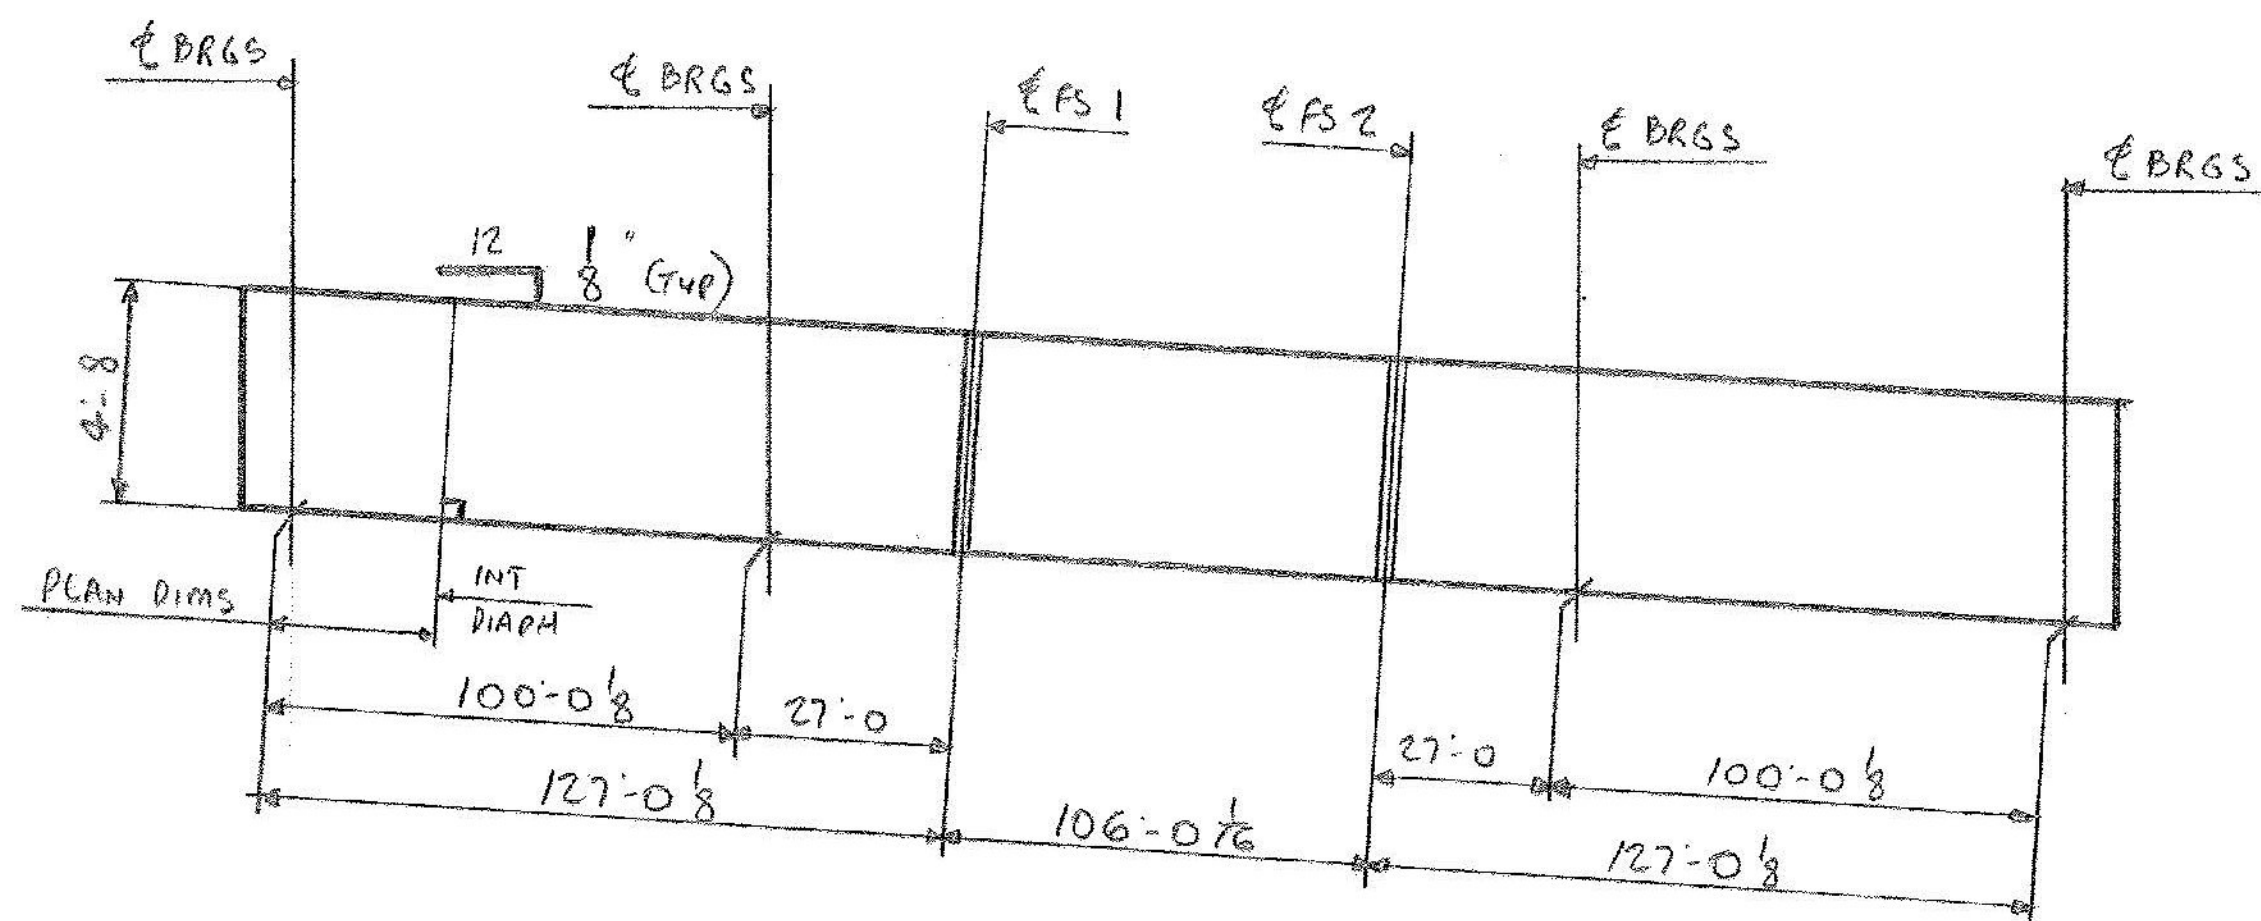

TYP. GIRDER ELEVATION

- NOTES:
- 1) ALL LONG. DIMS ARE SLOPING ALONG BOTT. OF WEB.
 - 2) ALL TRANSV. DIMS ARE HORIZ.
 - 3) → ARROW DENOTES DROP OR SLOPE. (POINTS TO LOW END)
 - 4) ENDS, BRGS ARE VERTICAL.
 - 5) INT DIAPHS & FS ARE NORMAL.
 - 6) FOR DIAPH LAYOUTS SEE W2 (4-44)

IT. NO. 506.91		BR. NO. G		PROJ. NO. F020-1(10)	
FOR APPROVAL			FOR FILES & FIELD		
EASTBOUND FRAMING PLAN					
APPROVED: 2-1-85		<i>Bancroft & Martin Inc.</i> South Portland, Maine 04106 JOB: U.S. 4 OVER OTTER CREEK RUTLAND, VERMONT CUSTOMER: EARTH CONSTRUCTION DESIGNER: STATE OF VERMONT AGENCY OF TRANS.			
PRINT DIST.					
7	12-14-84 APP.				
8	2-26-85 FAB.				
ORIG	3-26-86 VAT				
REV. Δ		ORDER NO.	JOB NO.	DRAWING NO.	REV.
CHECKED	11-27-84 FK			4-44	W-1
DRAWN	11/17/84 LT				

RW 9561
PTS 1-128