

WOVEN WIRE FENCE
W/ STEEL POSTS
EB 892+00 - 908+00 RL
WB 892+00 - 908+00 LT


SAND BORROW
EB 892+00 - 908+00
WB 892+00 - 908+00

SLOPE BENCHING
EB 893+00 - 908+00 RL
WB 899+00 - 908+00 LT

WOVEN WIRE FENCE
W/ STEEL POSTS
EB 892+00 - 908+00 RL
WB 892+00 - 908+00 LT

SAND BORROW
EB 892+00 - 908+00
WB 892+00 - 908+00

SLOPE BENCHING
EB 893+00 - 908+00 RL
WB 899+00 - 908+00 LT

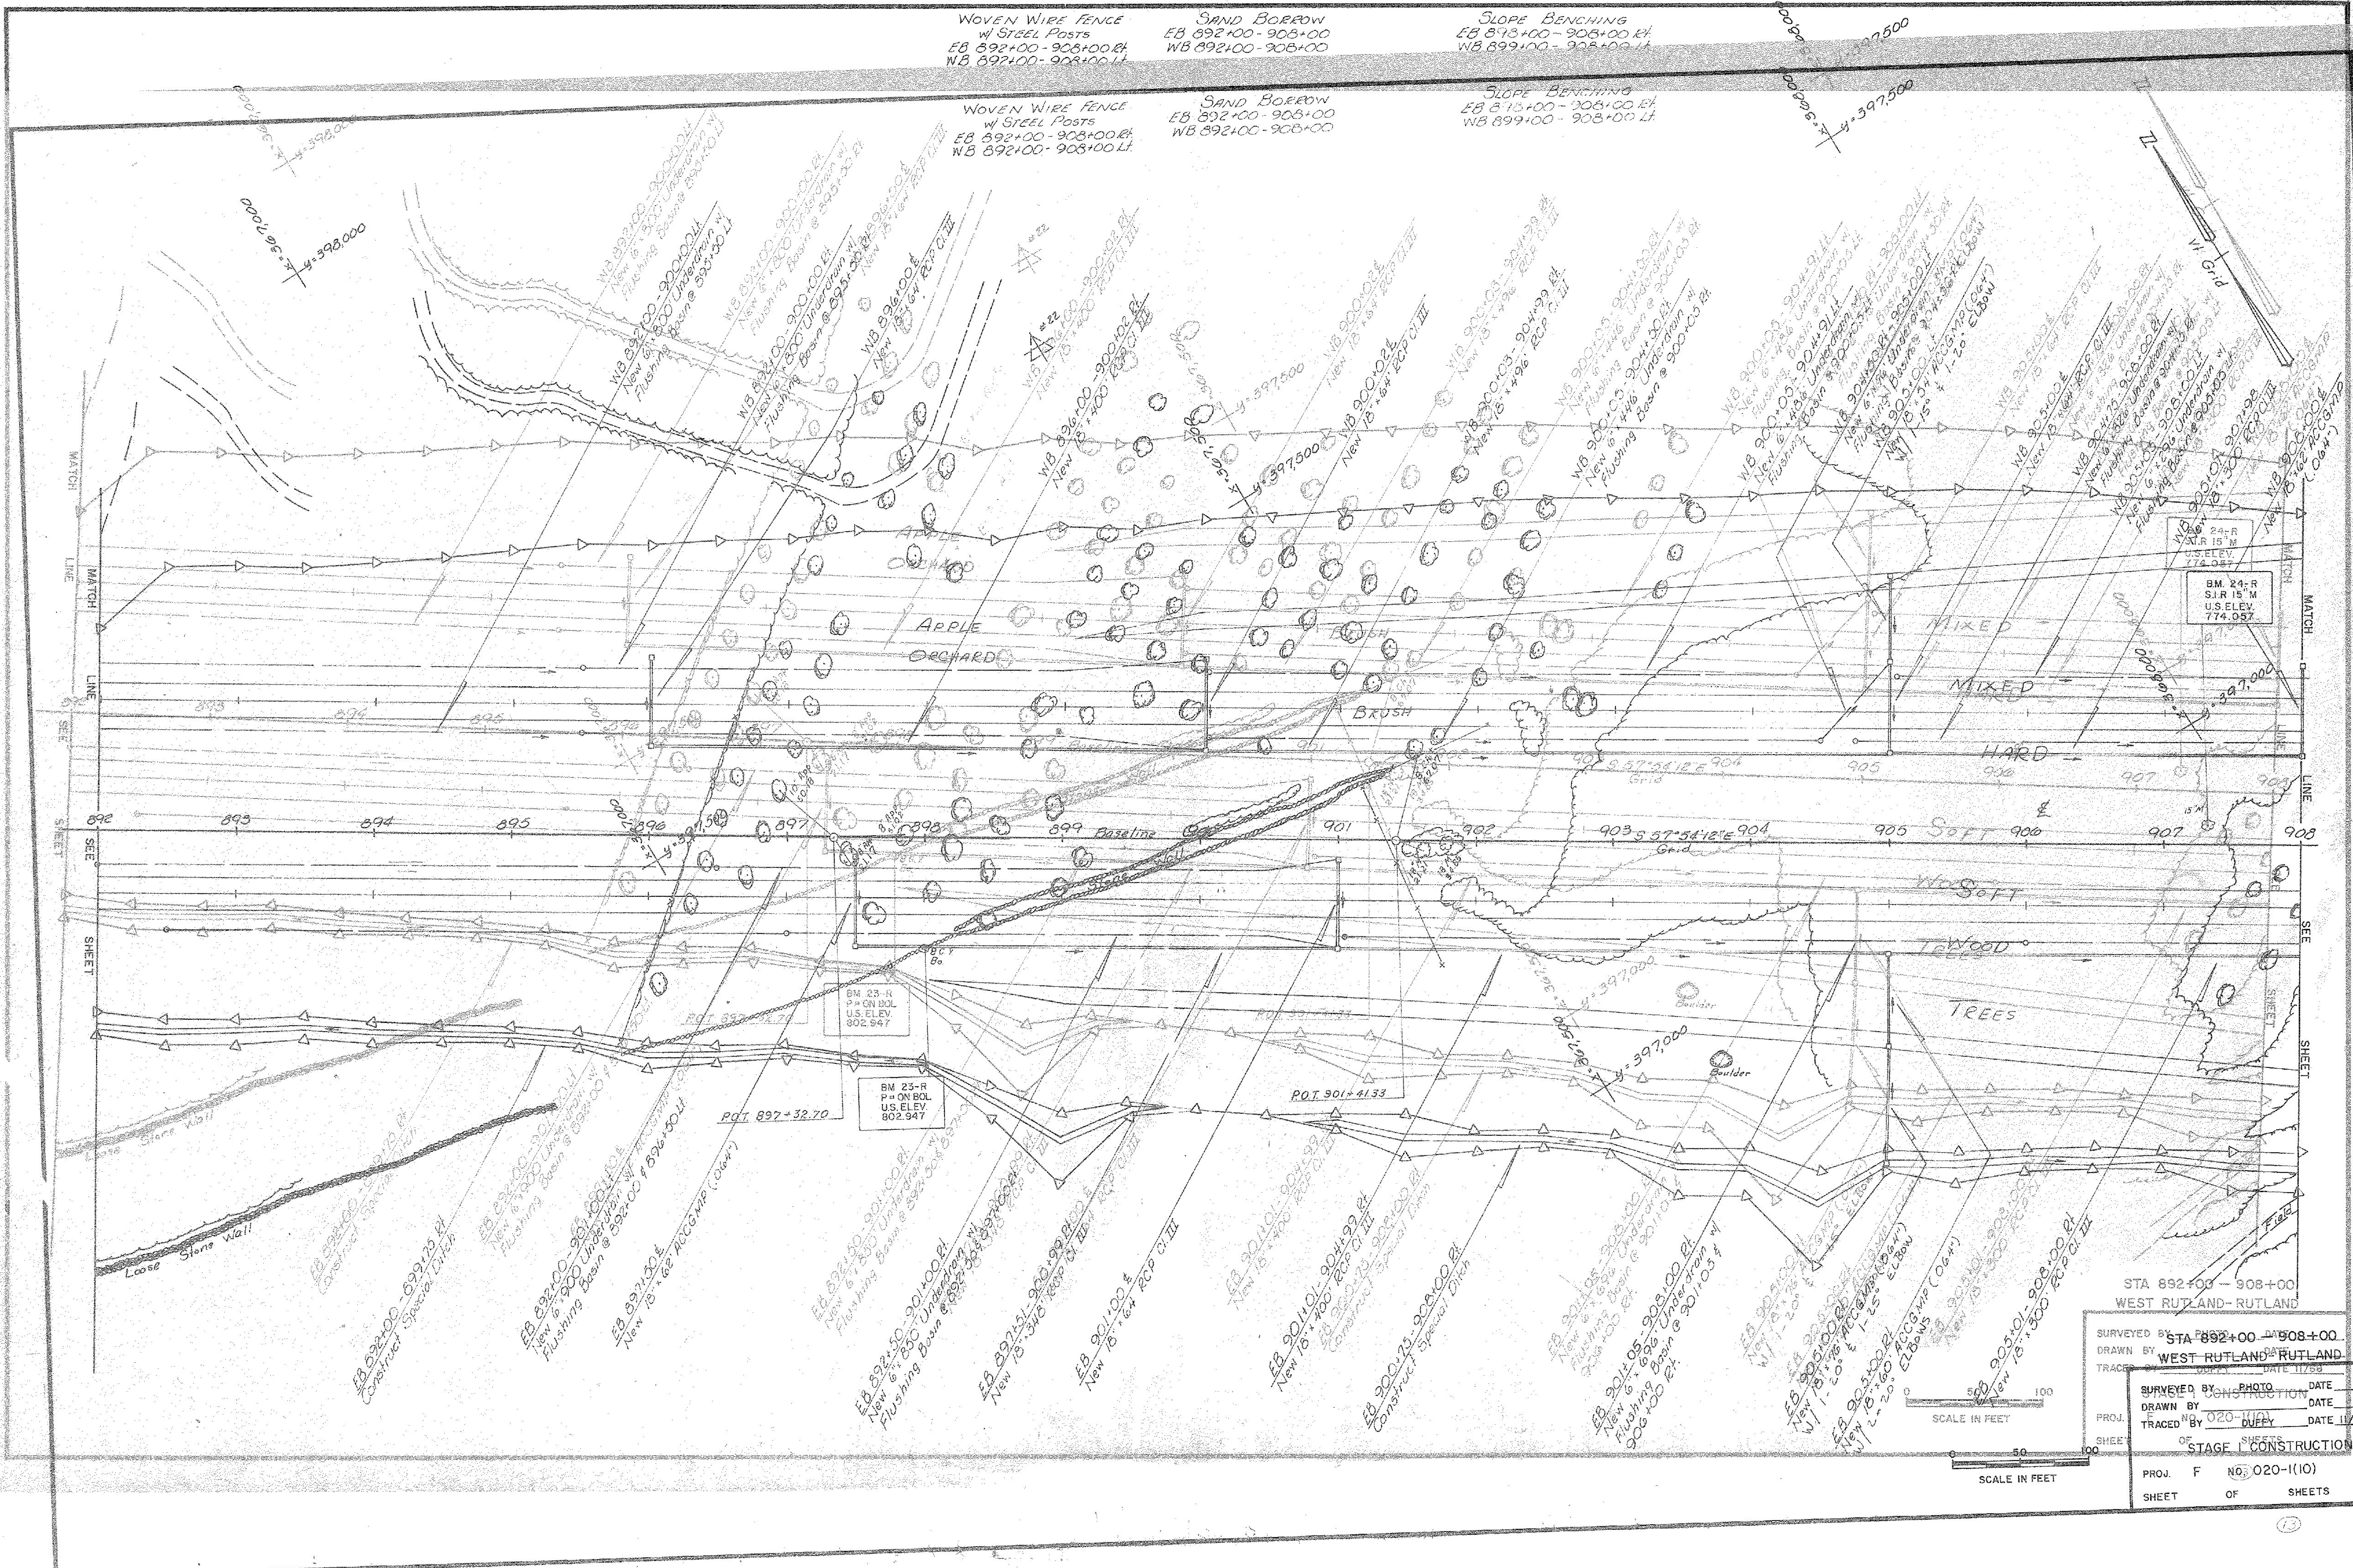

BM 23-R
P= ON BCL
U.S. ELEV.
802.947

BM 23-R
P= ON BCL
U.S. ELEV.
802.947

BM 24-R
S.I.R 15'M
U.S. ELEV.
774.957

STA 892+00 - 908+00
WEST RUTLAND - RUTLAND

SURVEYED BY STA 892+00 - 908+00
DRAWN BY WEST RUTLAND - RUTLAND

TRACED BY DATE
SURVEYED BY PHOTO DATE
DRAWN BY DATE

PROJ. 020-1(10)
DRAWN BY DUFFY DATE 11/78

SHEET OF SHEETS
STAGE I CONSTRUCTION

PROJ. F NO. 020-1(10)
SHEET OF SHEETS

