

WOVEN WIRE FENCE
w/ STEEL POSTS
EB 892+00 - 908+00 RT
WB 892+00 - 908+00 LT


SAND BORROW
EB 892+00 - 908+00
WB 892+00 - 908+00

SLOPE BENCHING
EB 893+00 - 908+00 RT
WB 899+00 - 908+00 LT

4.397500

4.398000

Vt. Grid

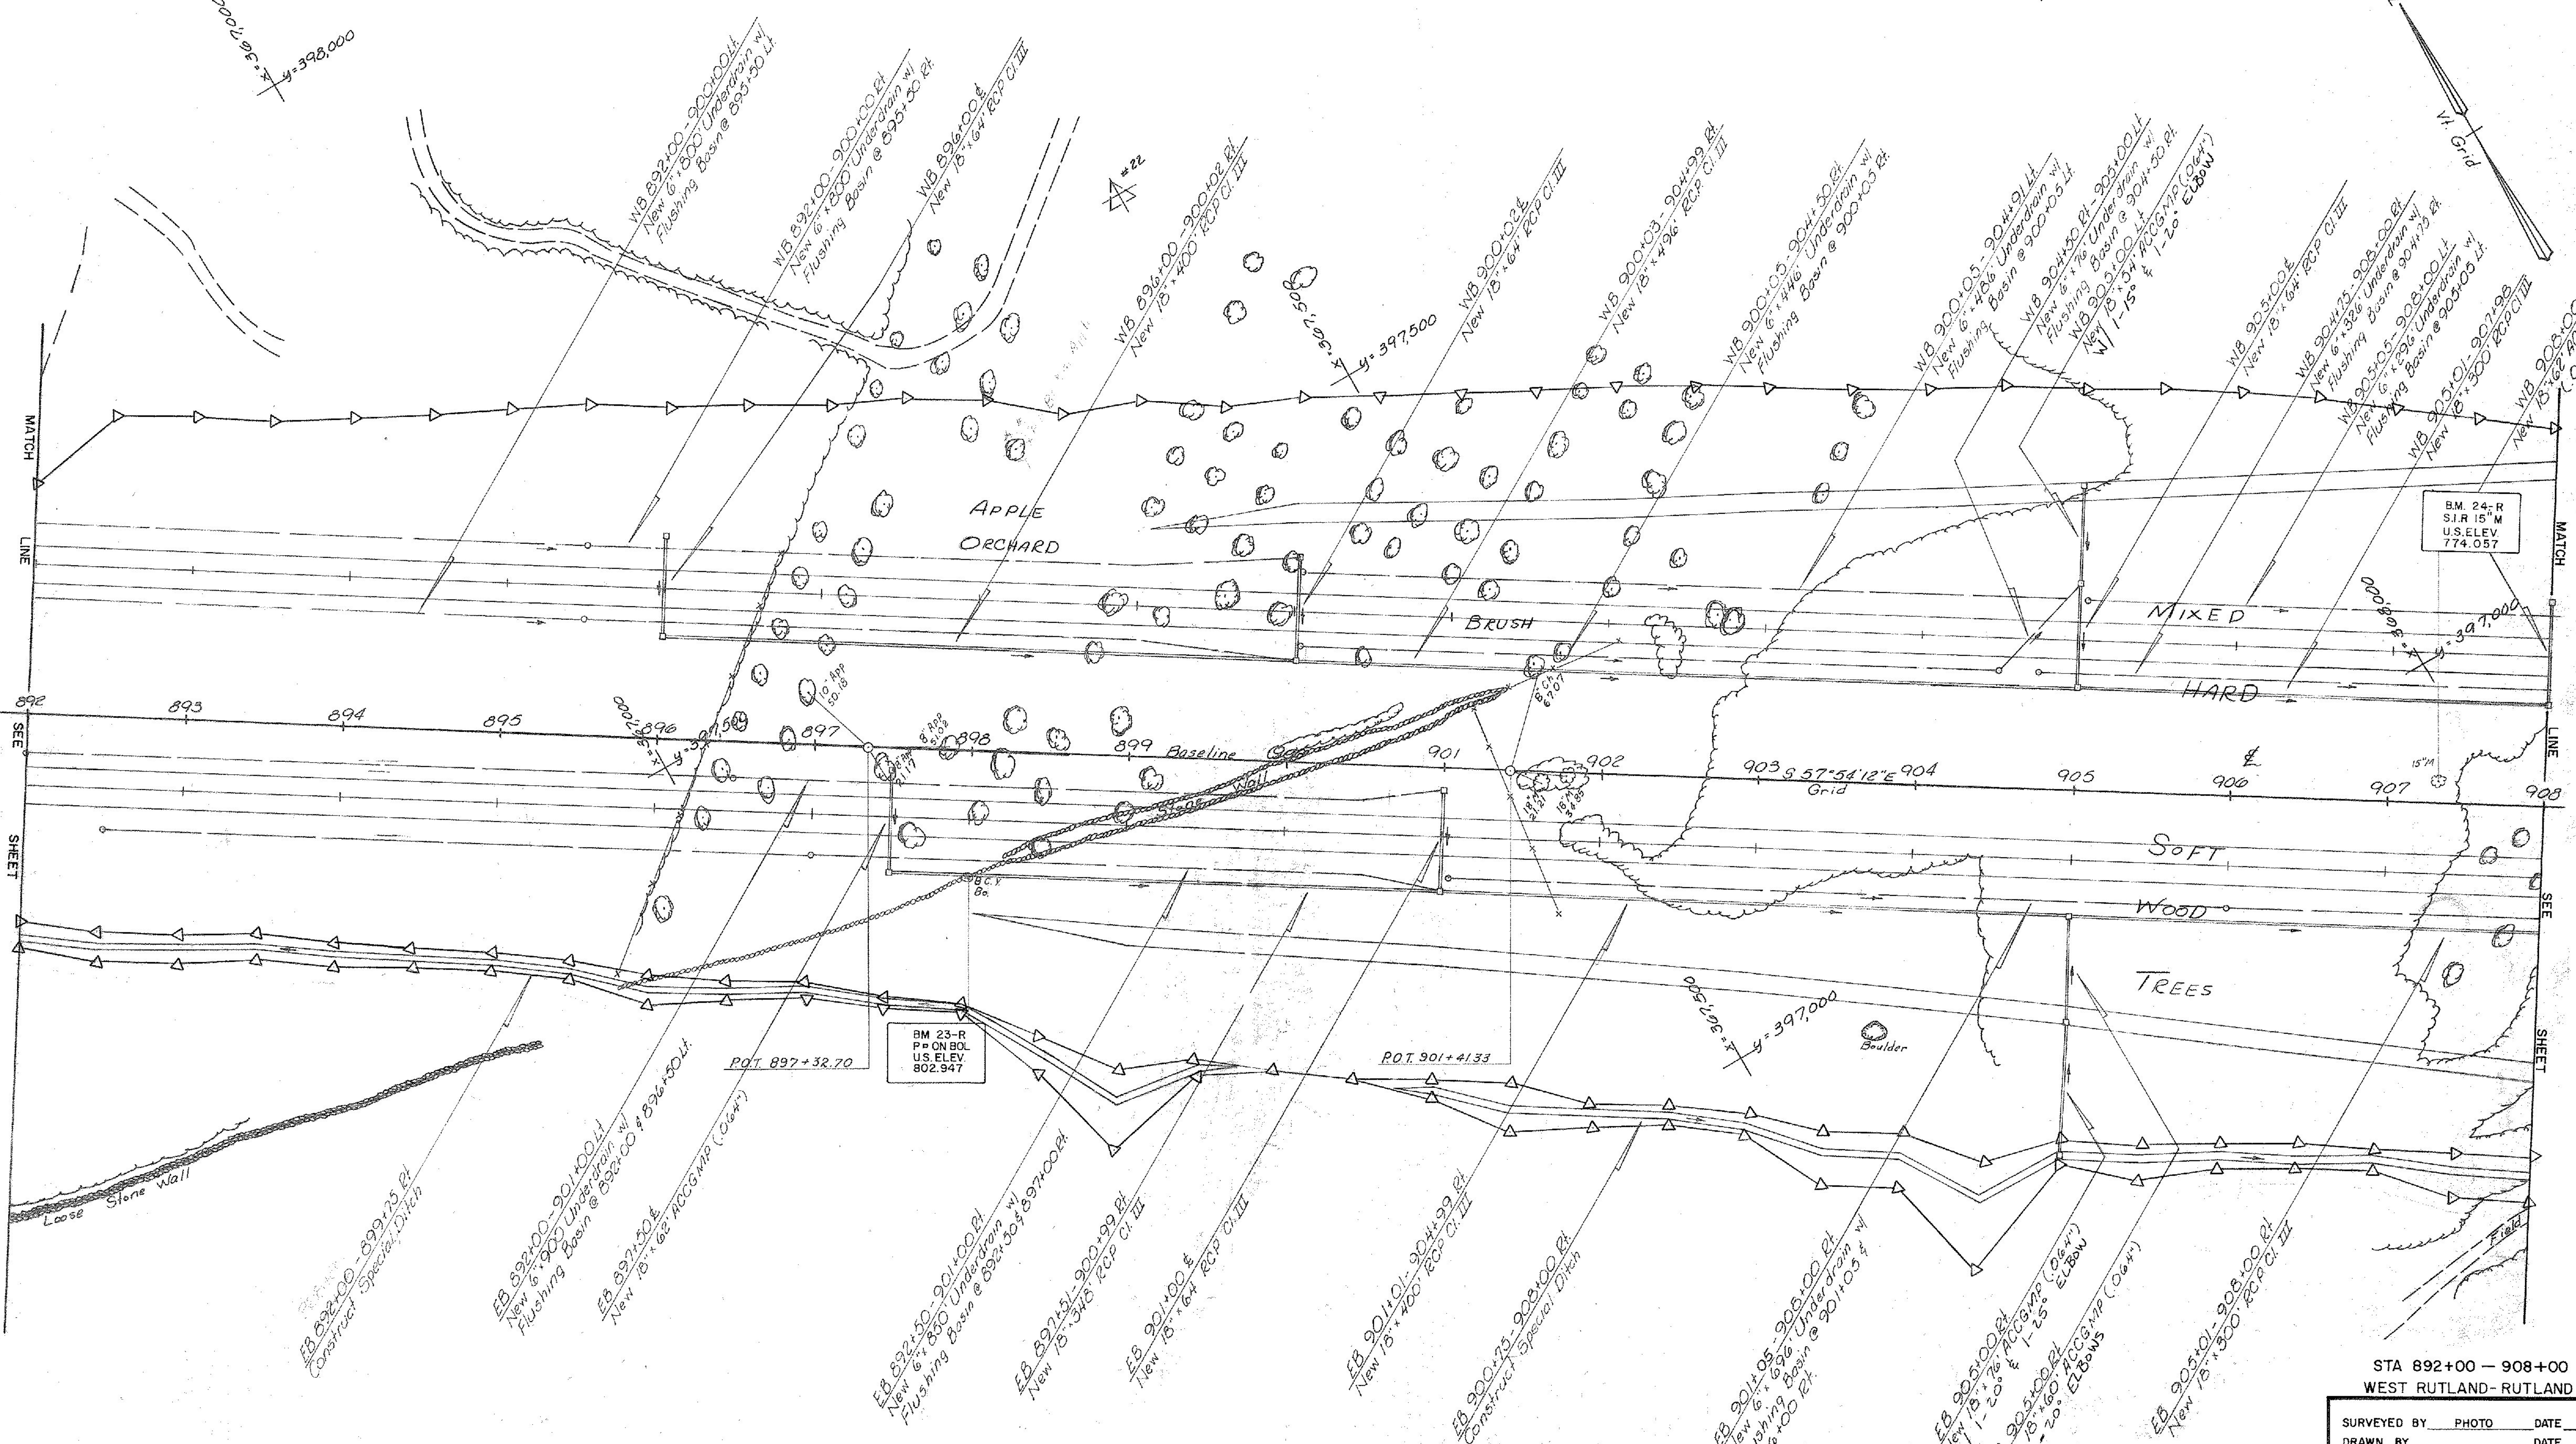

BM 23-R
P=ON BOL
U.S. ELEV.
802.947

BM 24-R
S.I.R. 15\"/>

STA 892+00 - 908+00
WEST RUTLAND - RUTLAND

SURVEYED BY PHOTO DATE
DRAWN BY DATE
TRACED BY DUFFY DATE 11/68

STAGE I CONSTRUCTION
PROJ. F NO. 020-1(10)
SHEET OF SHEETS

0 50 100
SCALE IN FEET