


GUARD RAIL, STANDARD STEEL BEAM W/ STEEL POSTS, TYPE II, 6'-3" SPACING
 EB 988+00 TO 991+51 ± RT
 WB 988+00 TO 991+53 ± LT.
 GUARD RAIL, THREE CABLE W/ STEEL POSTS
 Ramp Y 4+00 RT to 2+31 (15+61 LT)
 WOVEN WIRE FENCE W/ STEEL POSTS
 EB 988+00 RT. TO RAMP Y 4+00 RT.
 WB 988+00 LT. TO RAMP H 0+00 RT.
 TREATED TIMBER CURB
 EB 988+00 TO 991+42 RT.
 WB 988+00 TO 991+42 LT.
 Ramp Y 4+00 RT. to 2+31 (15+61 LT)

CONSTRUCT COMMERCIAL DRIVE
 U.S. 7 326+00 RT.
 REMOVING & RESETTING CURB
 U.S. 7 319+50 TO 326+40 (ISLAND)

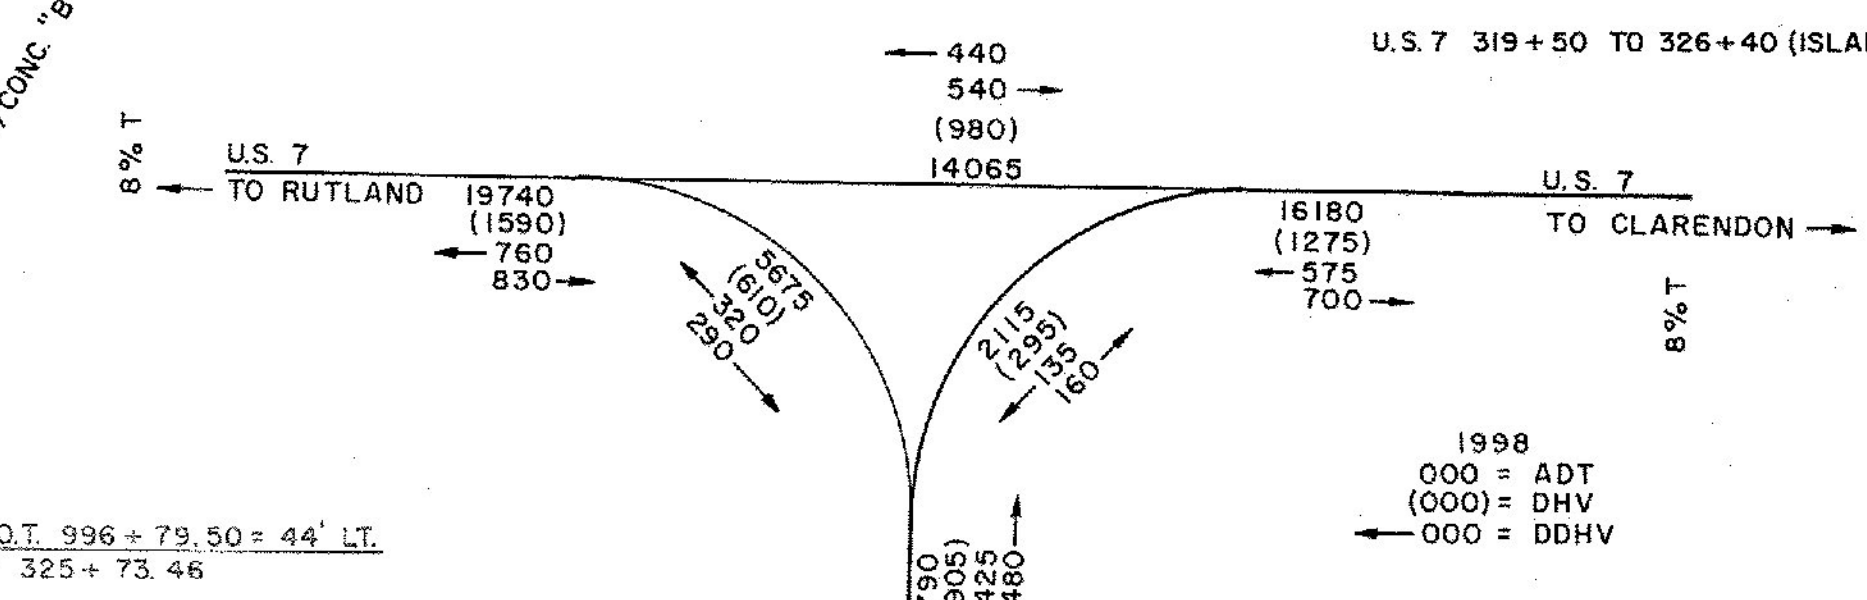


1998
 000 = ADT
 (000) = DHV
 000 = DDHV

RADIO TOWER BASE
US ELEV. 571.948

BM 37-R
SIR 48'E
US. ELEV. 569.799

EASTBOUND CURVE DATA	RAMP Y CURVE DATA	RAMP H CURVE DATA
Δ 10° 08' 30" LT.	Δ 66° 57' RT.	Δ 116° 08' 30" RT.
D 2° 30'	D 12'	D 24° 54' 40"
R 2291.83	R 477.465	R 230.00
T 203.36	T 315.73	T 369.09
L 405.67	L 557.92	L 466.22
E 9.01	E 94.95	E 204.89
BANK 0.021 FT/FT.	BANK 0.080 FT/FT.	BANK 0.080 FT/FT.

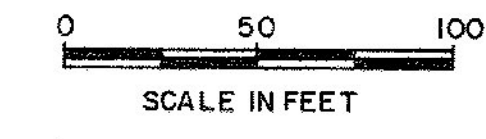

987+50 - 997+03.14
 WEST RUTLAND / RUTLAND
 SURVEYED BY FALL DATE JUNE '75
 DRAWN BY DZG DATE JULY '75
 TRACED BY DZG DATE JULY '75
 STAGE I CONSTRUCTION
 PROJ. F. NO. 020-1(10)
 SHEET OF