

Commercial Drive
342+95 Lt
Removing & Resetting
Curb
Remove From:
343+50 - 344+00 Lt
Item 203.15

Jughandle Extension
Vertical Granite Curb
0+45 - 1+80 Lt
1+20 - 1+80 Rt
Granite Slope Edging
0+87 - 1+25 Island



REMOVAL AND DISPOSAL OF
PRESENT GUARD RAIL
US 7 336+65 - 341+70 Lt.

DEM. & DISP OF BLOK.
Ramp L 17+00 Rt.

WOVEN WIRE FENCE w/
STEEL POSTS
Ramp L 8+00 - 14+50 Rt.
Ramp H 0+00 - 4+00 Rt.

* GUARD RAIL, Three Cable w/
Light Steel Posts
US 7 341+74 Lt - Ramp H 4+00 Rt.

CHAIN LINK FENCE
Ramp L 14+30 - 18+15 Rt.

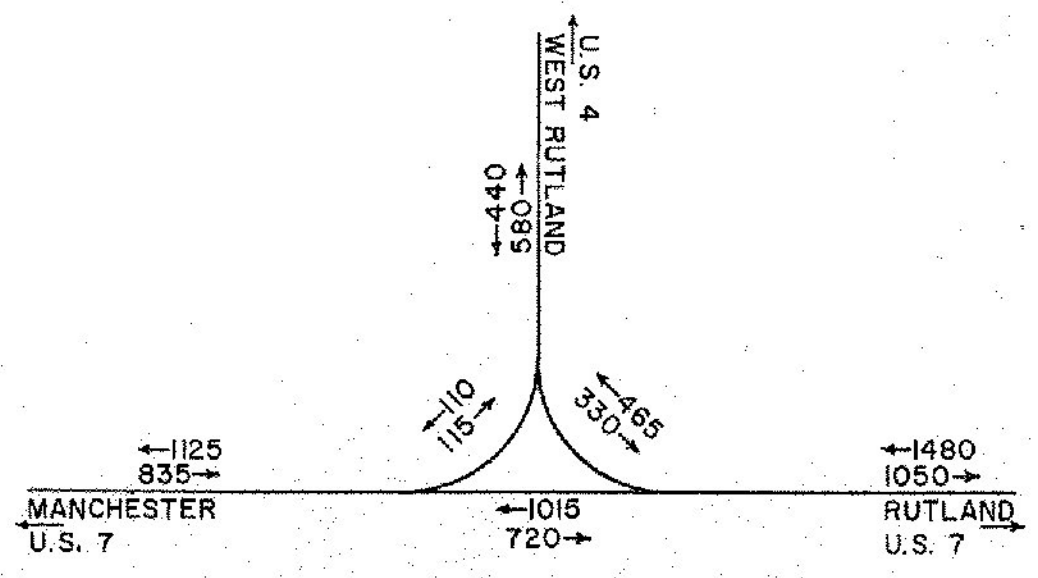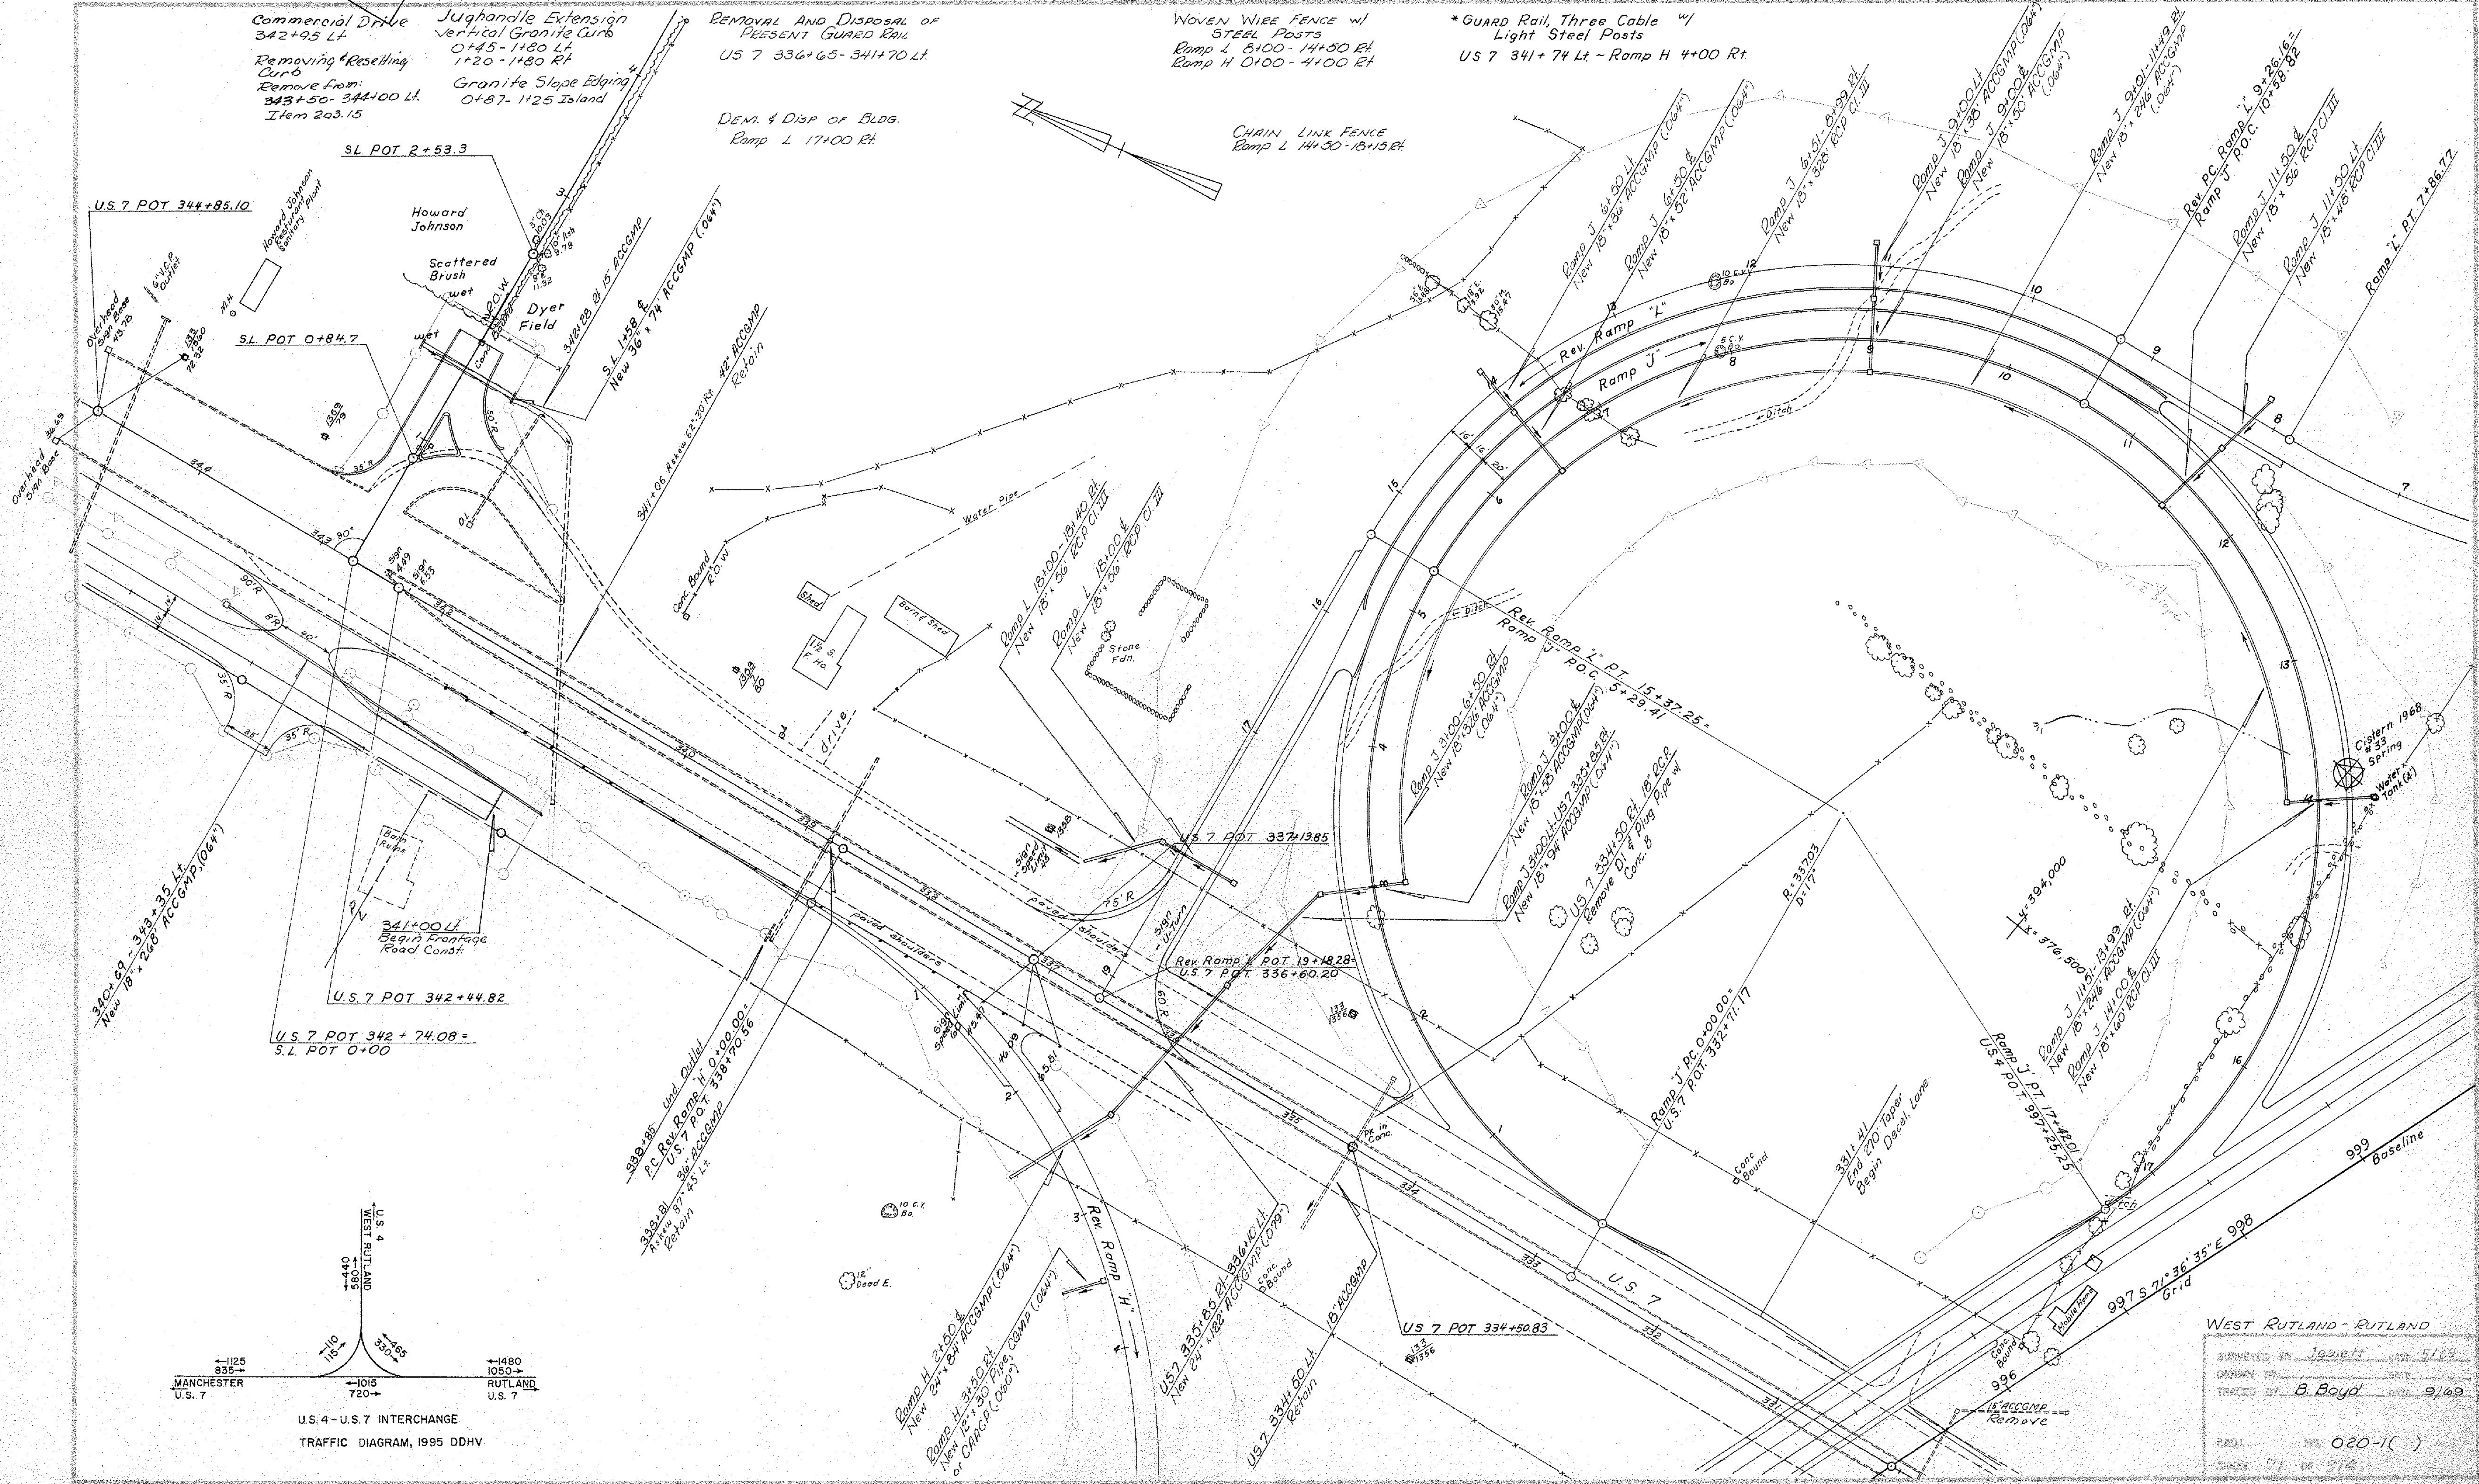

WEST RUTLAND - RUTLAND
SURVEYED BY J. J. J. DATE 5/63
DRAWN BY B. Boyd DATE 9/63
TRACED BY B. Boyd DATE 9/63
PROJ. NO. 020-1()
SHEET 57 OF 514