


RAMP H CURVE DATA  
 $\Delta$  116° 08' 30" RT.  
D 24° 54' 40"  
R 230.00  
T 369.09  
L 466.22  
E 204.89  
BANK 0.080 FT./FT.


CONSTRUCT COMMERCIAL DRIVE  
U.S. 7 STA. 326+00 RT.

VT. GRID

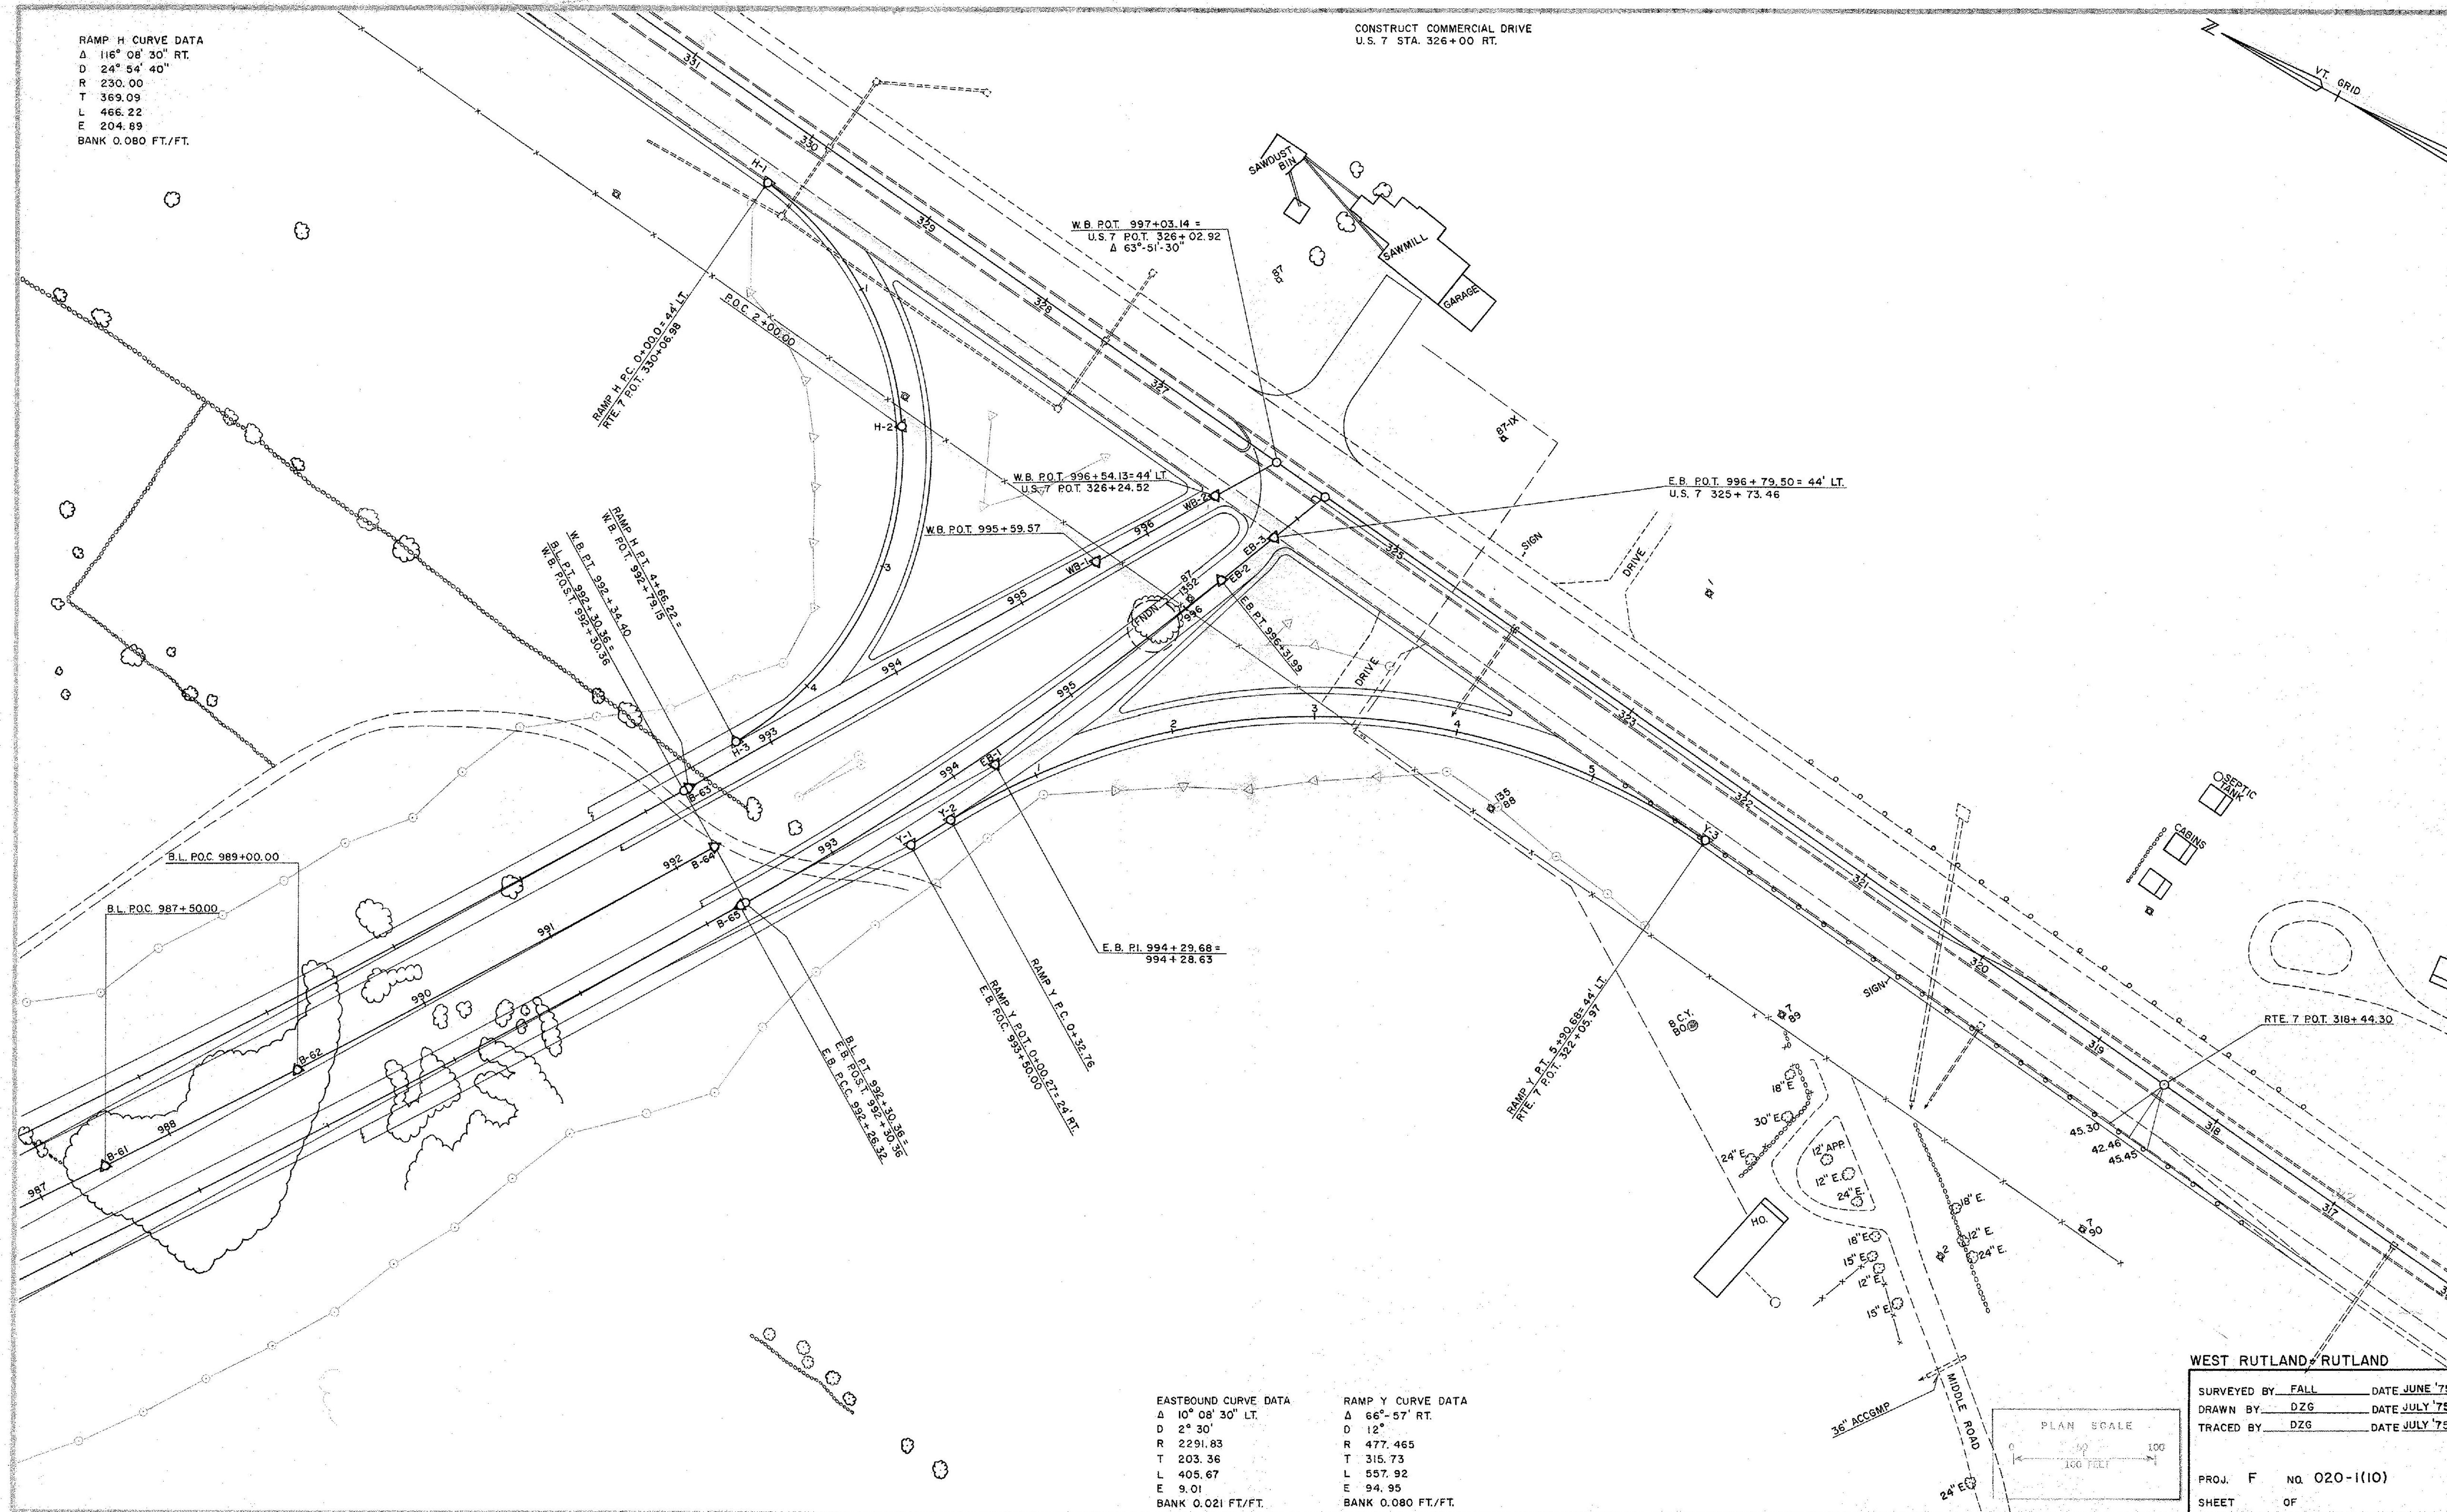

EASTBOUND CURVE DATA  
 $\Delta$  10° 08' 30" LT.  
D 2° 30"  
R 2291.83  
T 203.36  
L 405.67  
E 9.01  
BANK 0.021 FT./FT.

RAMP Y CURVE DATA  
 $\Delta$  66°-57' RT.  
D 12"  
R 477.465  
T 315.73  
L 557.92  
E 94.95  
BANK 0.080 FT./FT.

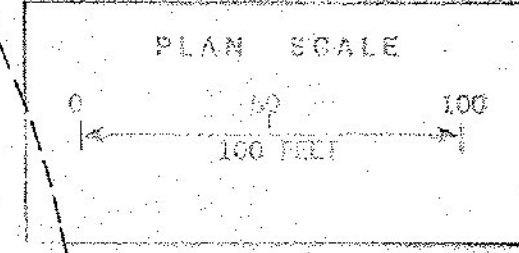

WEST RUTLAND - RUTLAND

SURVEYED BY	FALL	DATE	JUNE '75
DRAWN BY	DZG	DATE	JULY '75
TRACED BY	DZG	DATE	JULY '75

PROJ. F NO. 020-1(10)  
SHEET OF