


DATE	BY	CHECKED
7/75	TR	
PLAN SURVEYED PLOTTED CHECKED NO. OF INCHES NO.		



DATE	BY	CHECKED
7/75	TR	
PROFILE SURVEYED PLOTTED CHECKED NO. OF INCHES NO.		

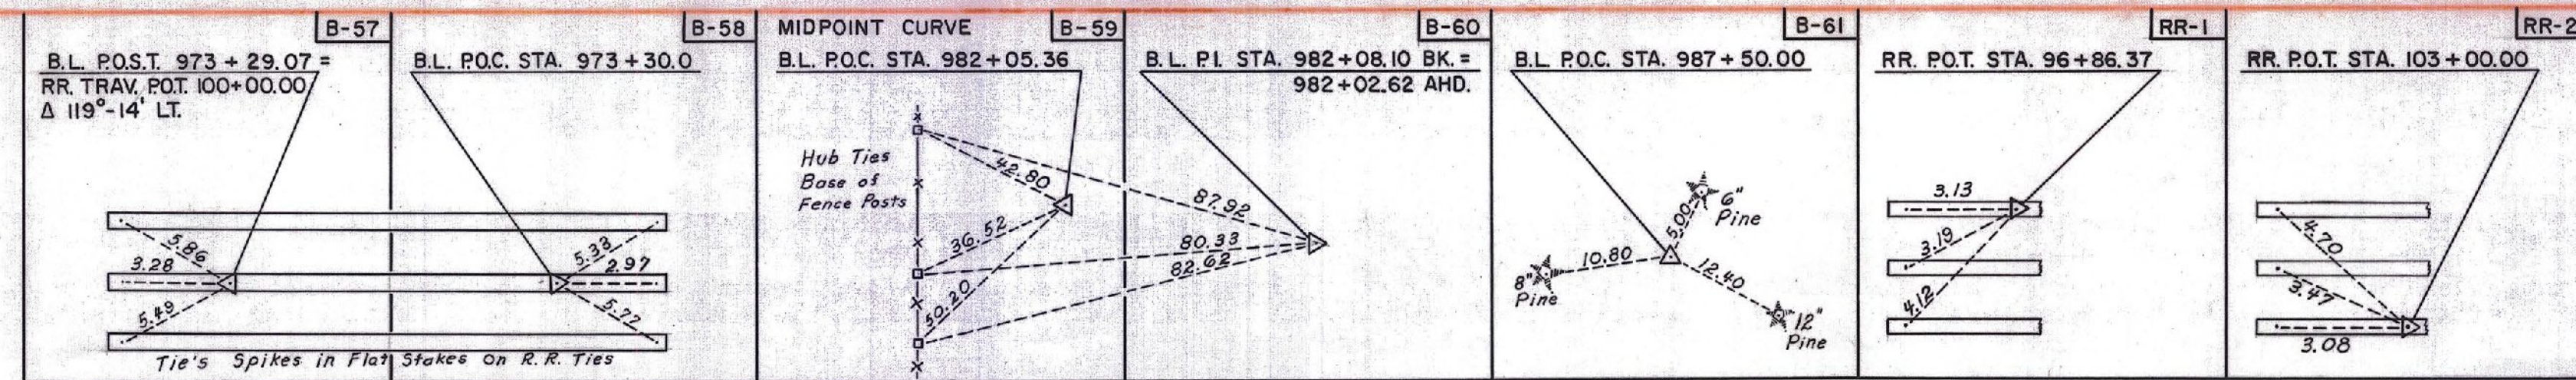